

11


11

8.5

11

11

8.5

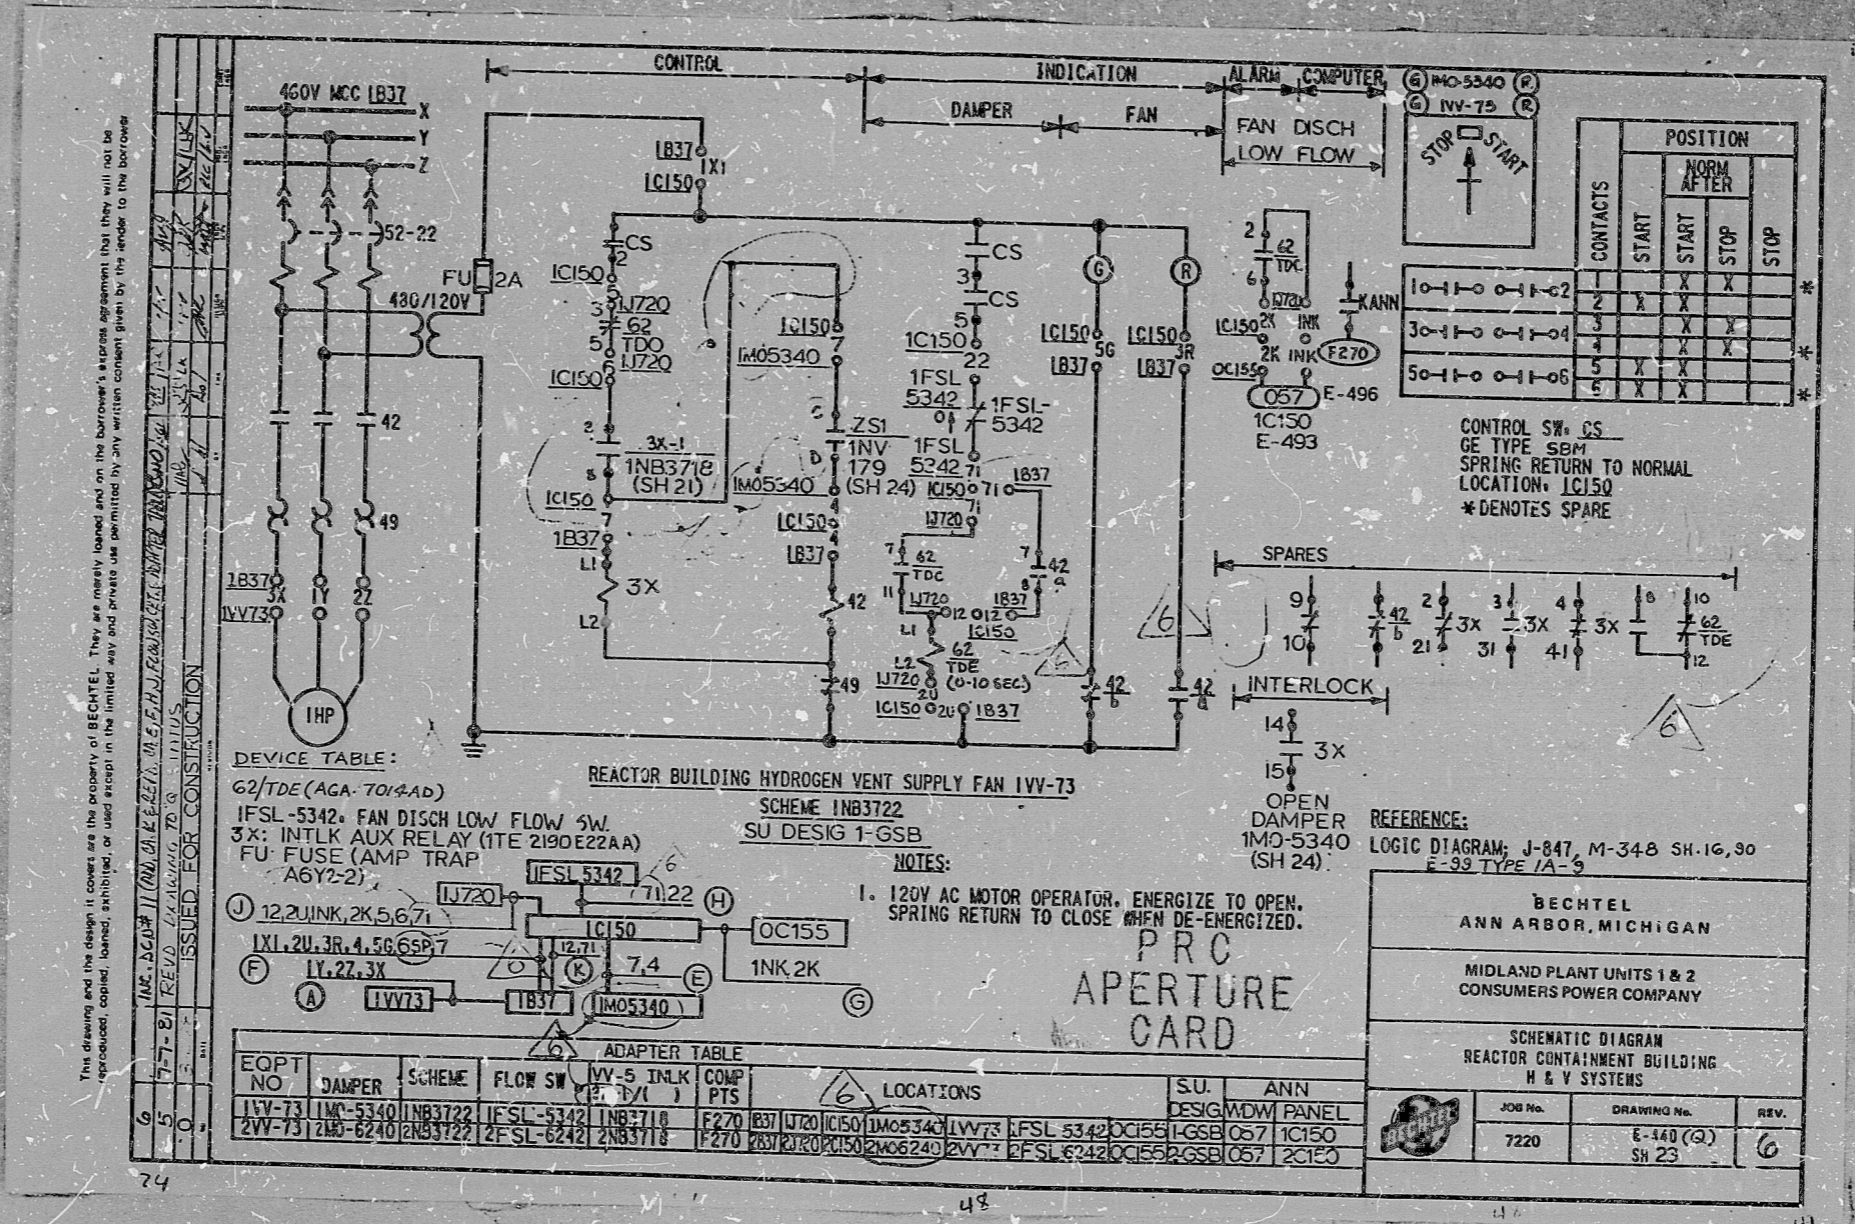

8.5

11

17

8.5

11

17

RIDS

8302090162

