


10407

13-E-SIB-052

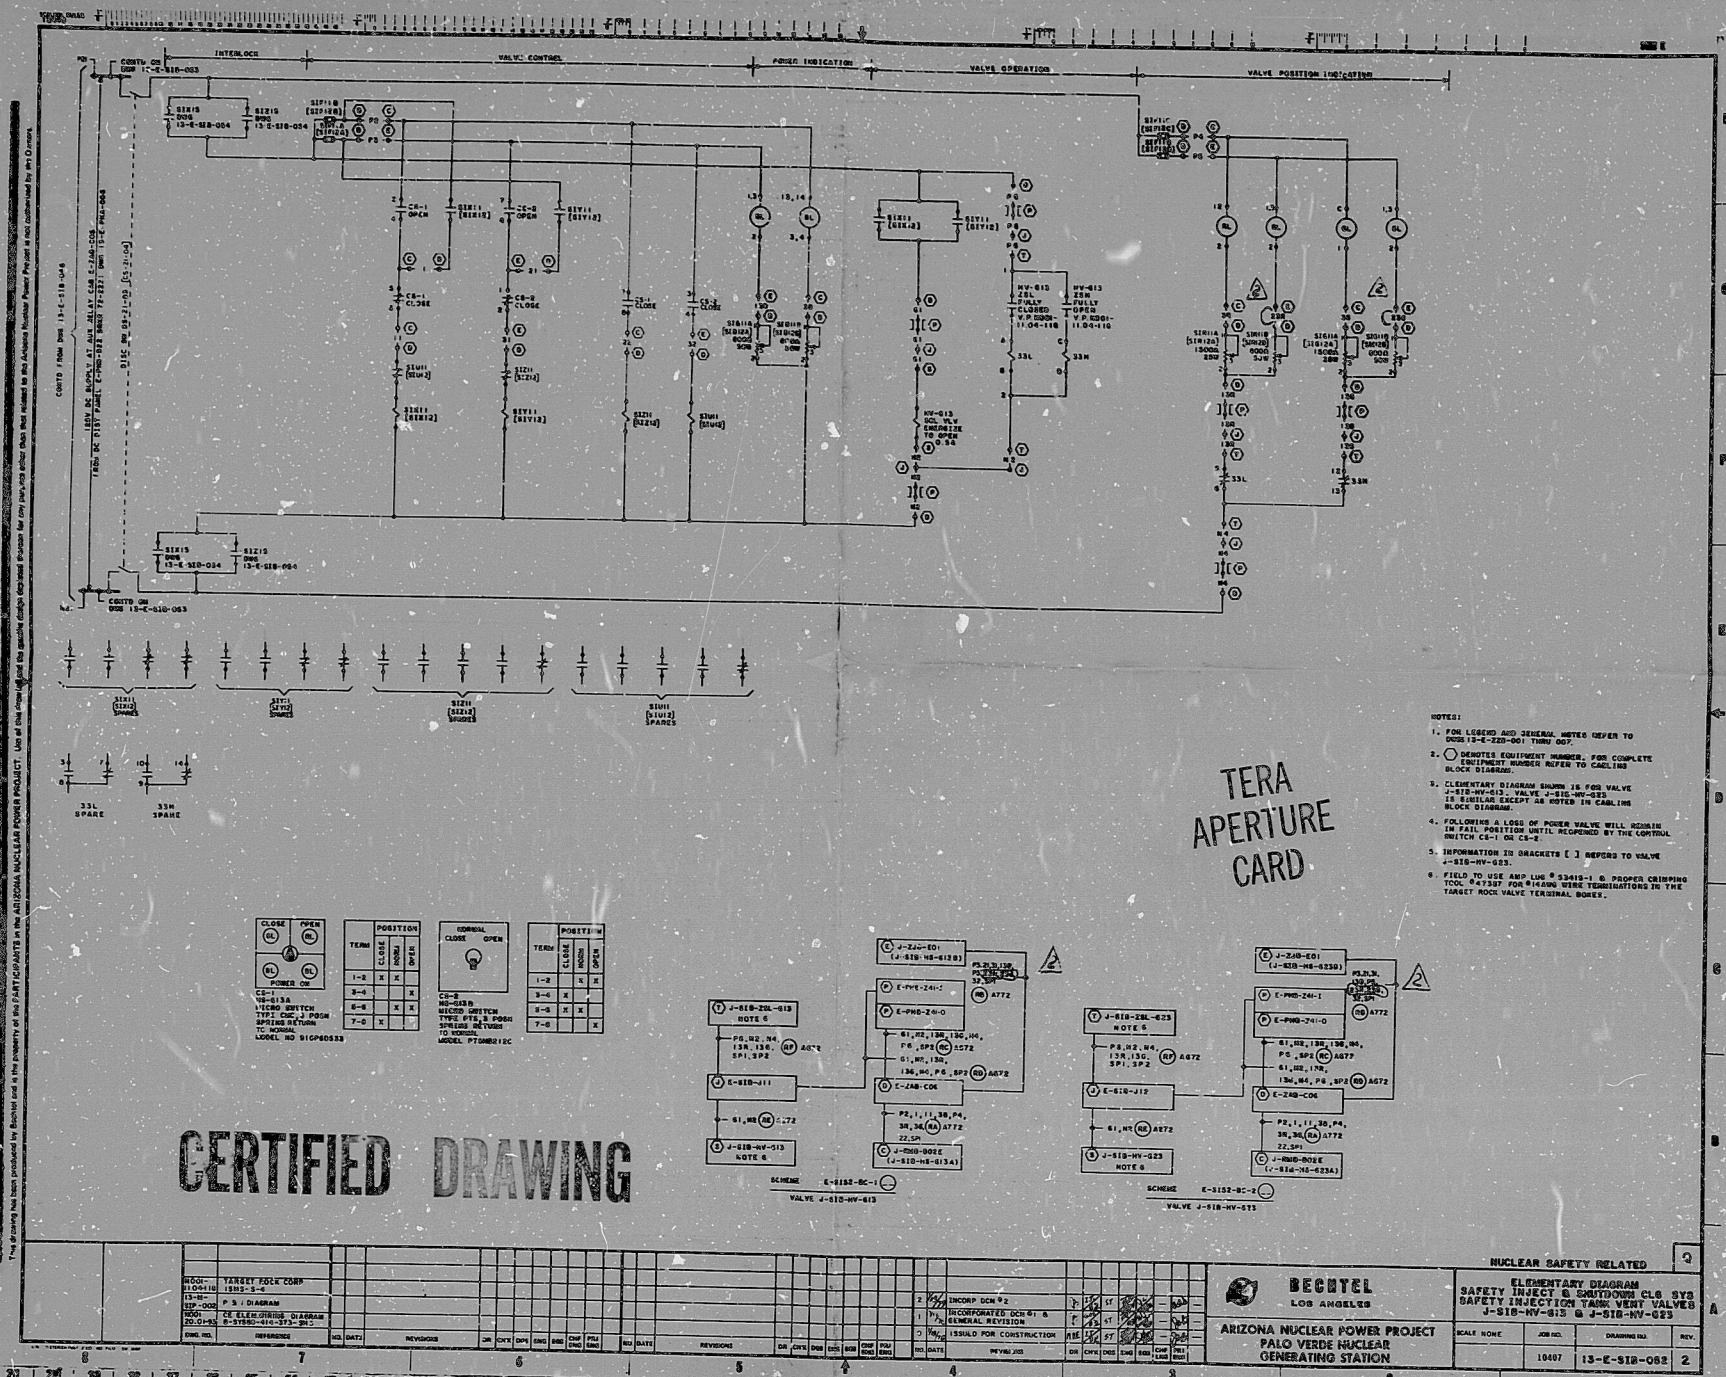

RDS

8109180522

