


The drawing and the design it covers are the property of BECHTEL. They are hereby loaned and on the borrower's express agreement that they will not be reproduced, copied, loaned, exhibited, or used except in the limited way and extent permitted by any written consent given by the lender to the borrower.

REV. 26	SU, TRAC NO. 70 RESPECTIVE DAMPERS	10/11/72	10/11/72	10/11/72	10/11/72
5	REV. 26	10/11/72	10/11/72	10/11/72	10/11/72
0	ISSUED FOR CONSTRUCTION	10/11/72	10/11/72	10/11/72	10/11/72

DEVICE TABLE:
FU: FUSE (BUSS NON. 6A)

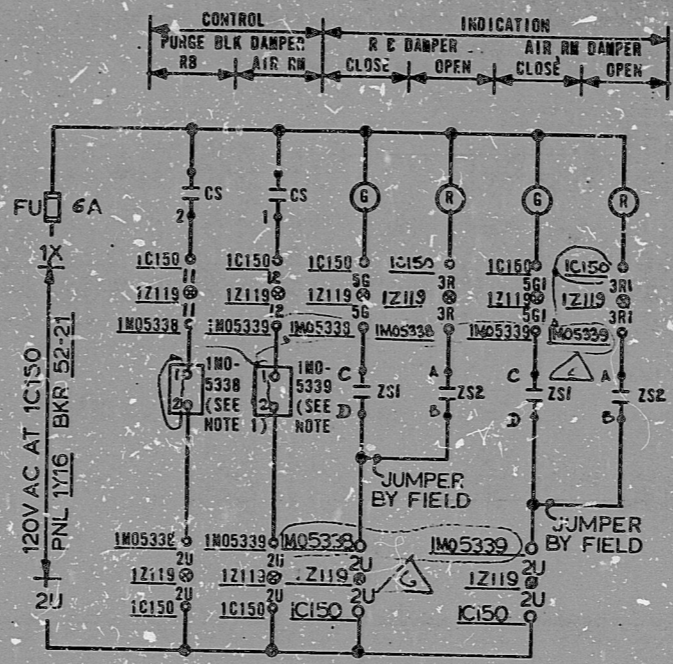

- NOTES:
- 120V AC MOTOR OPERATOR ENERGIZE TO OPEN SPRING RETURN TO CLOSE WHEN DE-ENERGIZED.
- REFERENCE:
- LOGIC DIAGRAM: J-844
 - V.P. 7220-M34B-79,33

PURGE BLOCK DAMPER IMO-5338 & IMO-5339
SCHEME INV014
SU DESIG 1-GTB
PRC APERTURE CARD

BECHTEL ANN ARBOR, MICHIGAN		
MIDLAND PLANT UNITS 1 & 2 CONSUMERS POWER COMPANY		
SCHEMATIC DIAGRAM REACTOR CONTAINMENT BUILDING H & V SYSTEMS		
JOB No.	DRAWING No.	REV.
7220	E-440 (G) 3A 25	6

RID'S

8302090164

