

17

11

8.5

8.5

11

17

17

11

8.5


8.5

11

17

This drawing and the design it covers are the property of B.F. FUEL. They are made, known, and on the holder's express agreement that they will not be reproduced, copied, loaned, exhibited, or used except in the limited way and purpose set forth in the agreement given by the holder to the licensee.

REV	DATE	BY	CHKD	REVISIONS
1	12-1-51	REVISIONS TO STATUS LIMIT SWITCH COUNT		11/20/51
2	12-2-51	11/20/51		
3	12-2-51	ISSUED FOR CONSTRUCTION		

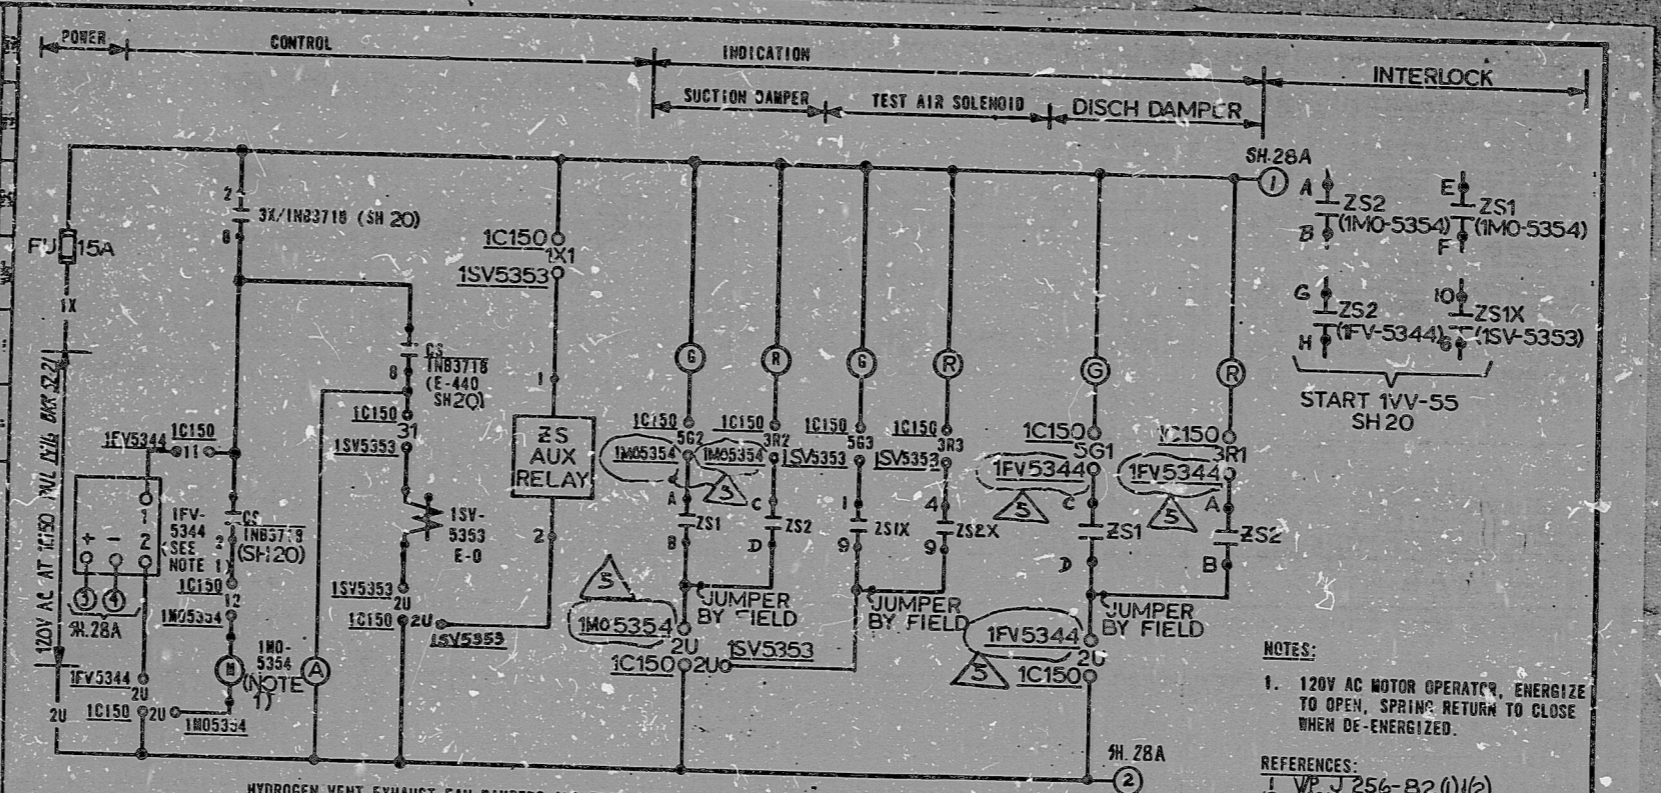

HYDROGEN VENT EXHAUST FAN DAMPERS AND TEST AIR SOLENOID
 SCHEME 1N1013
 SU DESIG 1-633

DEVICE TABLE
 FU: FUSE (BUSC NON 15A)

- NOTES:
- 1. 120V AC MOTOR OPERATOR, ENERGIZE TO OPEN, SPRING RETURN TO CLOSE WHEN DE-ENERGIZED.
- REFERENCES:
- 1 VP 7256-B2 (1)(2)
 - 2 LOGIC DIAGRAM: 1-346, 1-429
 - 3 VP 7220-M 348-27,17,18

PRG
 APERTURE
 CARD

BECHTEL ANN ARBOR, MICHIGAN		
MIDLAND PLANT UNITS 1 & 2 CONSUMERS POWER COMPANY		
SCHEMATIC DIAGRAM REACTOR CONTAINMENT BLDG H & V SYSTEMS		
JOB No. 7220	DRAWING No. E-240 (Q) SH 27	REV. 5

RIDS

8302090169

