

17"

11"

8.5"

8.5"

11"

17"

17"


11"

8.5"

8.5"

11"

17"

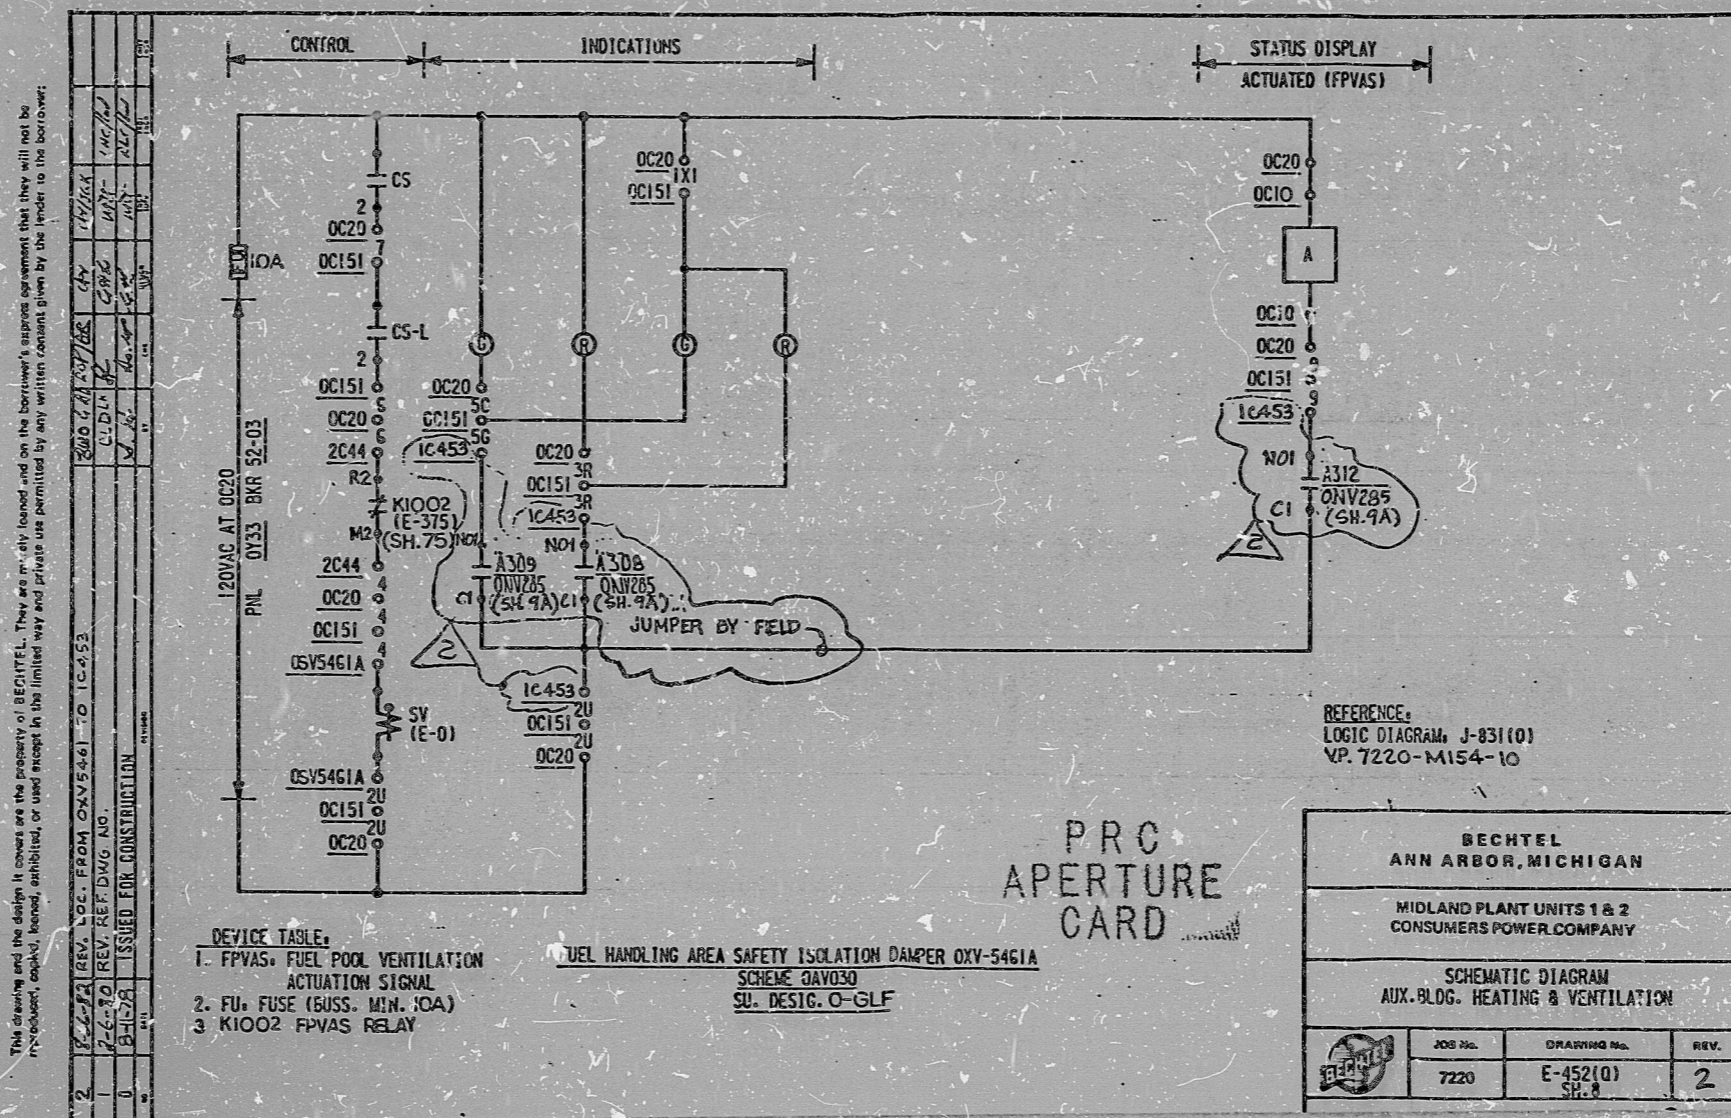

This drawing and the design it covers are the property of BECHTEL. They are not to be loaned, used, or on the borrower's, without agreement that they will not be reproduced, copied, lent, exhibited, or used except in the limited way and under the conditions given by the lender to the borrower.


- DEVICE TABLE:**
- 1. FPVAS FUEL POOL VENTILATION ACTUATION SIGNAL
 - 2. FU FUSE (BUSS. MIN. 10A)
 - 3. K1002 FPVAS RELAY
- FUEL HANDLING AREA SAFETY ISOLATION DAMPER OXY-54G1A**
 SCHEME 0AV030
 SU. DESIG. O-GLF

BECHTEL ANN ARBOR, MICHIGAN		
MIDLAND PLANT UNITS 1 & 2 CONSUMERS POWER COMPANY		
SCHEMATIC DIAGRAM AUX. BLDG. HEATING & VENTILATION		

I certify that the image contained on this frame was made in the normal and regular course of business, on the date stated below and that it is an accurate reproduction of the document submitted to reprographics.

RDS

8302090214

