


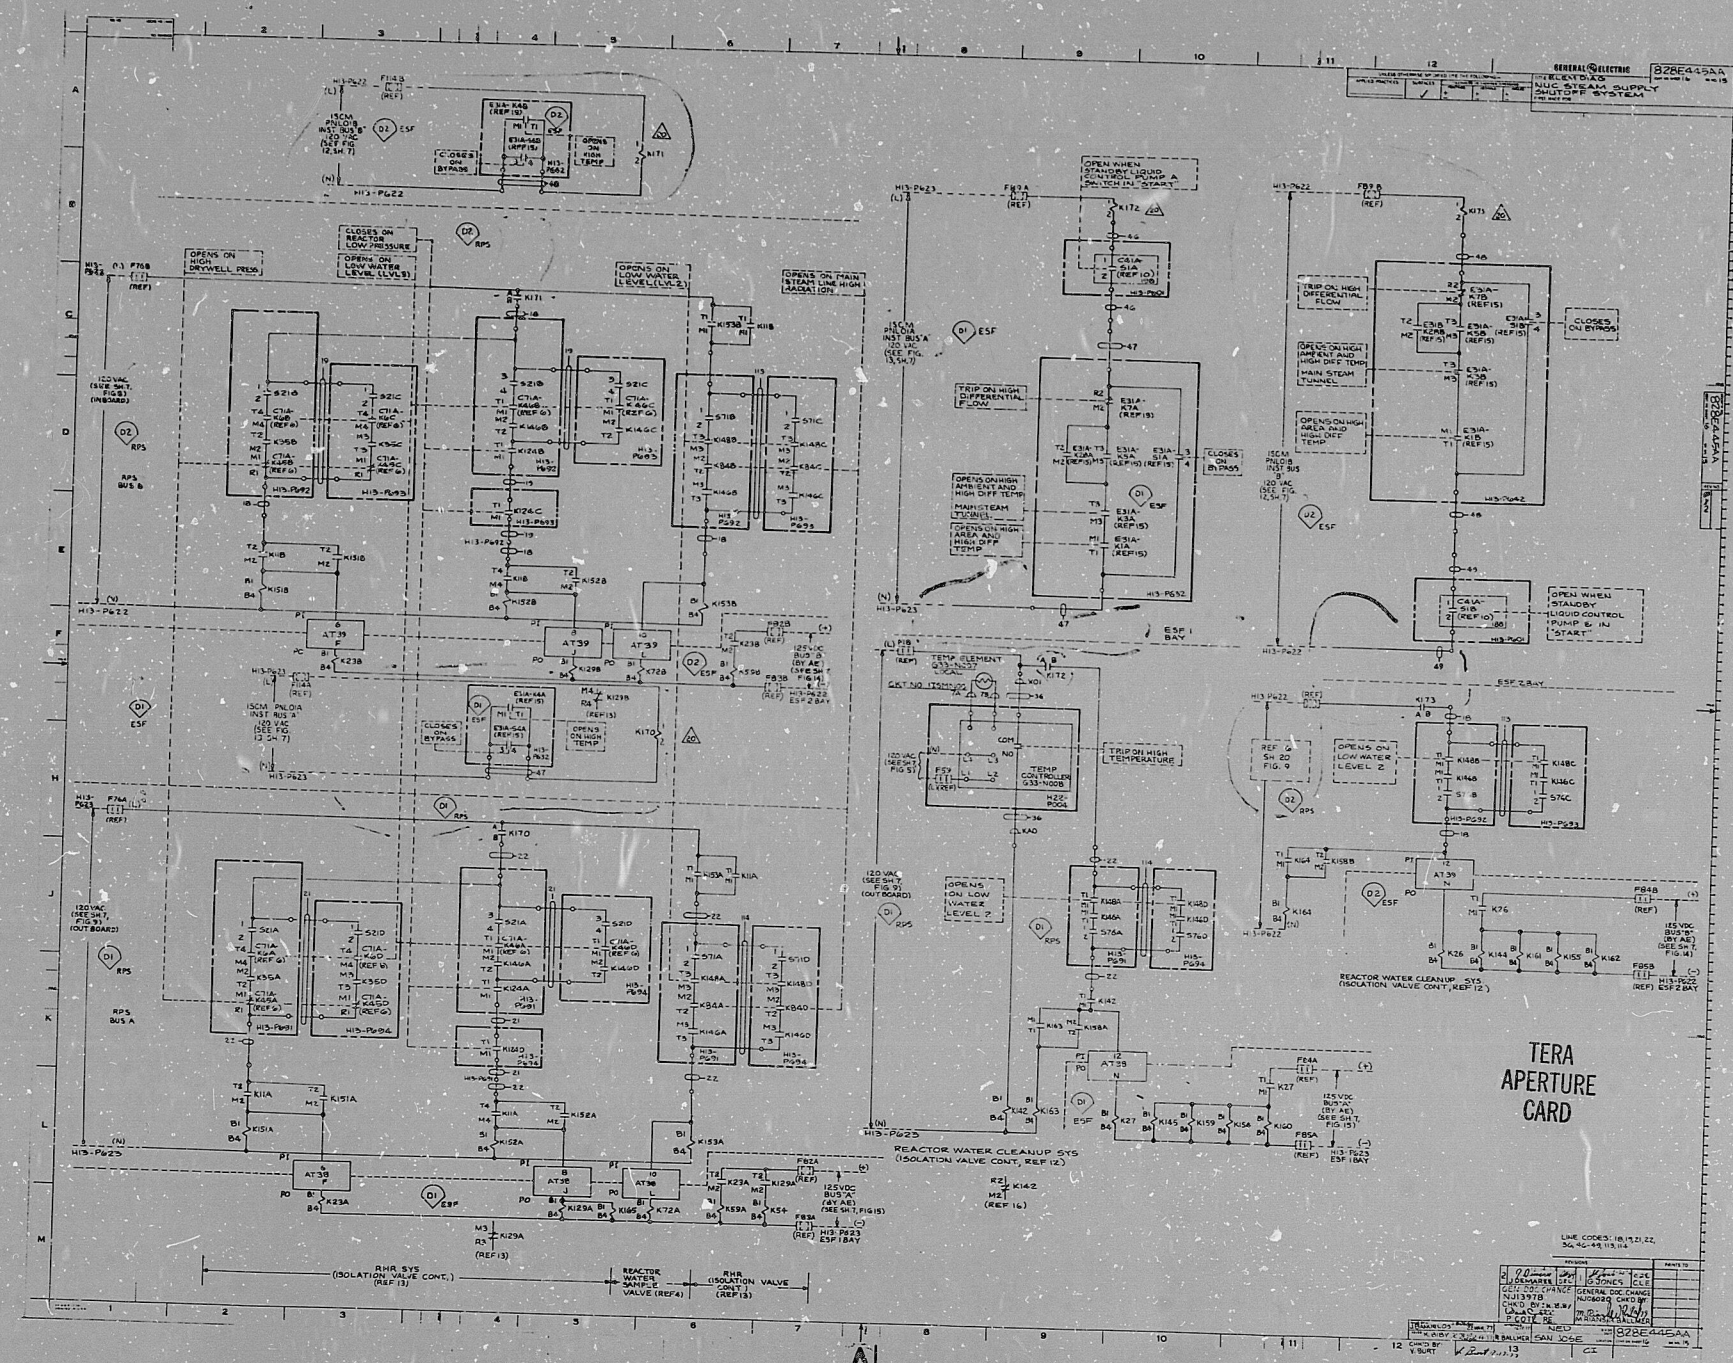

RIDS

8109180548

