

17"

11"

8.5"

8.5"

11"

17"

17"

11"


8.5"

8.5"

11"

17"

This drawing and its design are the property of BECHTEL. They are hereby loaned and on the borrower's express agreement that they will not be reproduced, copied, stored, or utilized in any way without the prior written consent given by the lender to the borrower.

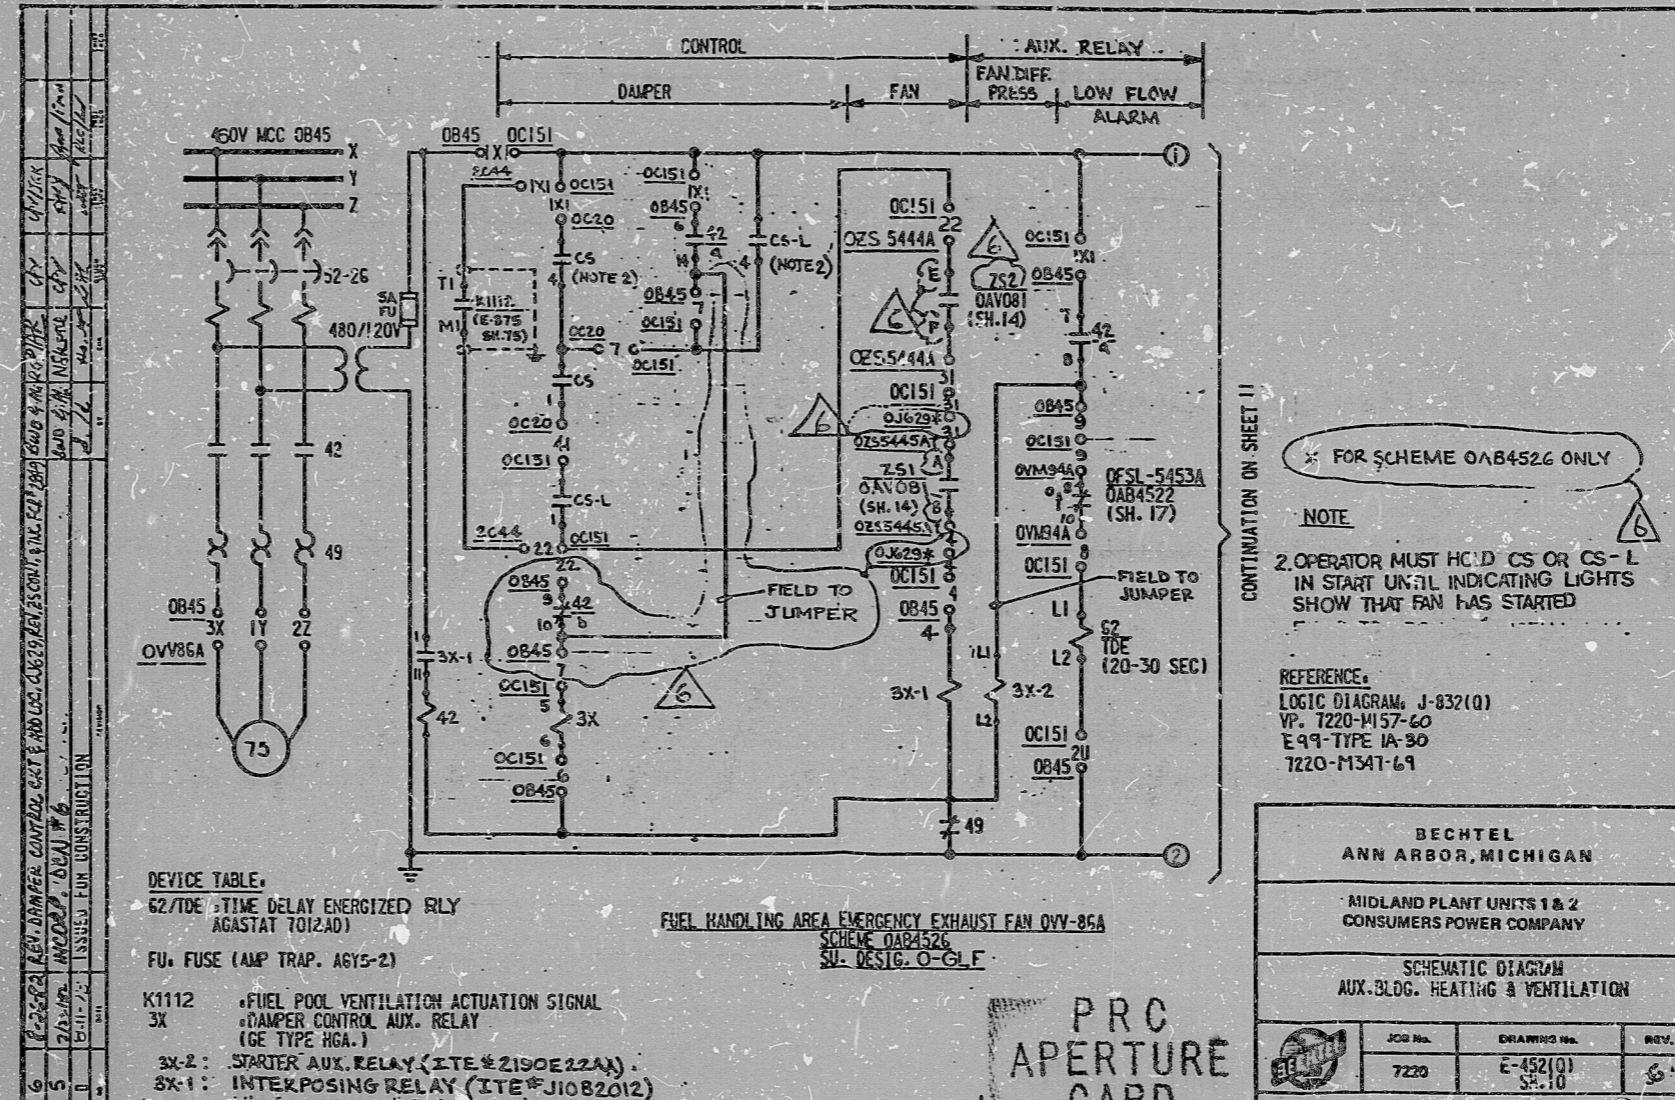

DEVICE TABLE:
 62/TDE TIME DELAY ENERGIZED RLY
 AGASTAT 7012AD)
 FU FUSE (AMP TRAP. AGY5-2)
 K1112 FUEL POOL VENTILATION ACTUATION SIGNAL
 3X DAMPER CONTROL AUX. RELAY
 (GE TYPE HGA-1)
 3X-2 STARTER AUX. RELAY (ITE #2190E22A)
 3X-1 INTERPOSING RELAY (ITE #J10B2012)

FUEL HANDLING AREA EMERGENCY EXHAUST FAN OVV-86A
 SCHEME 0AB4526
 SU-025TG. 0-CLF

CONTINUATION ON SHEET 11

* FOR SCHEME 0AB4526 ONLY
 NOTE
 2. OPERATOR MUST HOLD CS OR CS-L IN START UNTIL INDICATING LIGHTS SHOW THAT FAN HAS STARTED
 REFERENCE:
 LOGIC DIAGRAM, J-832(0)
 VP. 7220-M157-60
 E99-TYPE IA-30
 7220-M1341-69

BECHTEL ANN ARBOR, MICHIGAN		
MIDLAND PLANT UNITS 1 & 2 CONSUMERS POWER COMPANY		
SCHEMATIC DIAGRAM AUX. BLOC. HEATING & VENTILATION		
JOB No.	DRAWING No.	REV.
7220	E-452(0) SH. 10	5

PRC
APERTURE
CARD

I certify that the image contained on this frame was made in the normal and regular course of business, on the date stated below and that it is an accurate reproduction of the document submitted to reprographics.

RIDG

8392090218

