


This drawing and the design it covers are the property of BECHTEL. They are loaned and not the borrower's express agreement that they will not be reproduced, copied, loaned, exhibited, or used except in the limited way and private use permitted by any written consent given by the lender to the borrower.

REV.	DATE	BY	CHKD.	REASON
1	11/28/78	ISSUED FOR CONSTRUCTION
2

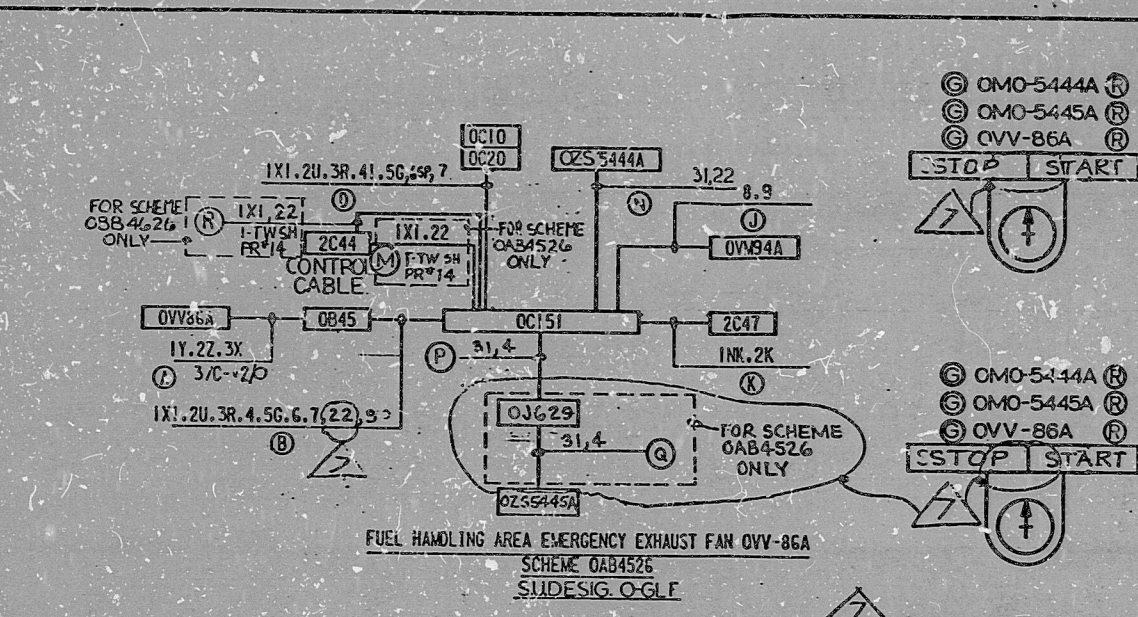

FUEL HANDLING AREA EMERGENCY EXHAUST FAN OVV-86A
SCHEME OAB4526
SIDESIG. O-GLF

EQUIP. NUMBER	SCHEME	INTERLOCK		SCHEME	RELAY	CHAN	SH. NO.	LIMIT SW. ZS2	ZS2 CONT.
		ZS/Z	FLOW SW.						
OVV-86A	OAB4526	OAV081	DFSL-5453A	OAB4522	K1112	A	75	OZS5444A	E,F
OVV-86B	OBB4626	OBV081	DFSL-5453B	OBB4522	K1112	B	76	OZS5444B	G,H

LOCATIONS									
OC20	2C44	OVV86A	OC151	OB45	OZS5445A	OZS5444A	OVV84A	2C47	OJ629
OC20	2C44	OVV86B	OC151	OB46	OZS5445B	OZS5444B	OVV84B	2C47	--

PRC
APERTURE
CARD

STOP NORMAL START

STOP	NORMAL	START
○ ○ ○ ○	○ ○ ○ ○	○ ○ ○ ○
○ ○ ○ ○	○ ○ ○ ○	○ ○ ○ ○

CONTROL SW. CS
GE TYPE CR2940
SPRING RETURN TO NORMAL
LOCATION: OC20

STOP NORMAL START

STOP	NORMAL	START
○ ○ ○ ○	○ ○ ○ ○	○ ○ ○ ○
○ ○ ○ ○	○ ○ ○ ○	○ ○ ○ ○

CONTROL SW. CS-1
GE TYPE CR2940
SPRING RETURN TO NORMAL
LOCATION: OC151

NOTE:
1. FIELD TO PROVIDE AND REPLACE NAME PLATES AT SW CS-1, SEE E-63.

BECHTEL ANN ARBOR, MICHIGAN		
MIDLAND PLANT UNITS 1 & 2 CONSUMERS POWER COMPANY		
SCHEMATIC DIAGRAM AUX. BLDG. HEATING & VENTILATION		
JOB No. 7220	DRAWING No. E452(O)SH12	REV. 7

I certify that the image contained on this frame was made in the normal and regular course of business, on the date stated below and that it is an accurate reproduction of the document submitted to reprographics.

RIDS

8302090221

