

17"

11"

8.5"

8.5"

11"

17"

17"

11"

8.5"

8.5"

11"

17"

32


THIS DRAWING AND THE DESIGN IT COVERS ARE THE PROPERTY OF BECHTEL. THEY ARE LOANED TO YOU BY BECHTEL. YOU WILL NOT REPRODUCE, COPY, REUSE, OR TRANSMIT THIS INFORMATION IN ANY MANNER WITHOUT THE WRITTEN CONSENT OF BECHTEL.

1-24-73 AND QUOTE LOCATION IN 60001 FOR 2-20-73 NEW INTLK CONTROL

3-5-73 REVISED W/REG NOS.

5-11-73 ISSUED FOR CONSTRUCTION

NO.	REV.	DATE	BY	CHKD.
1				
2				
3				
4				
5				
6				

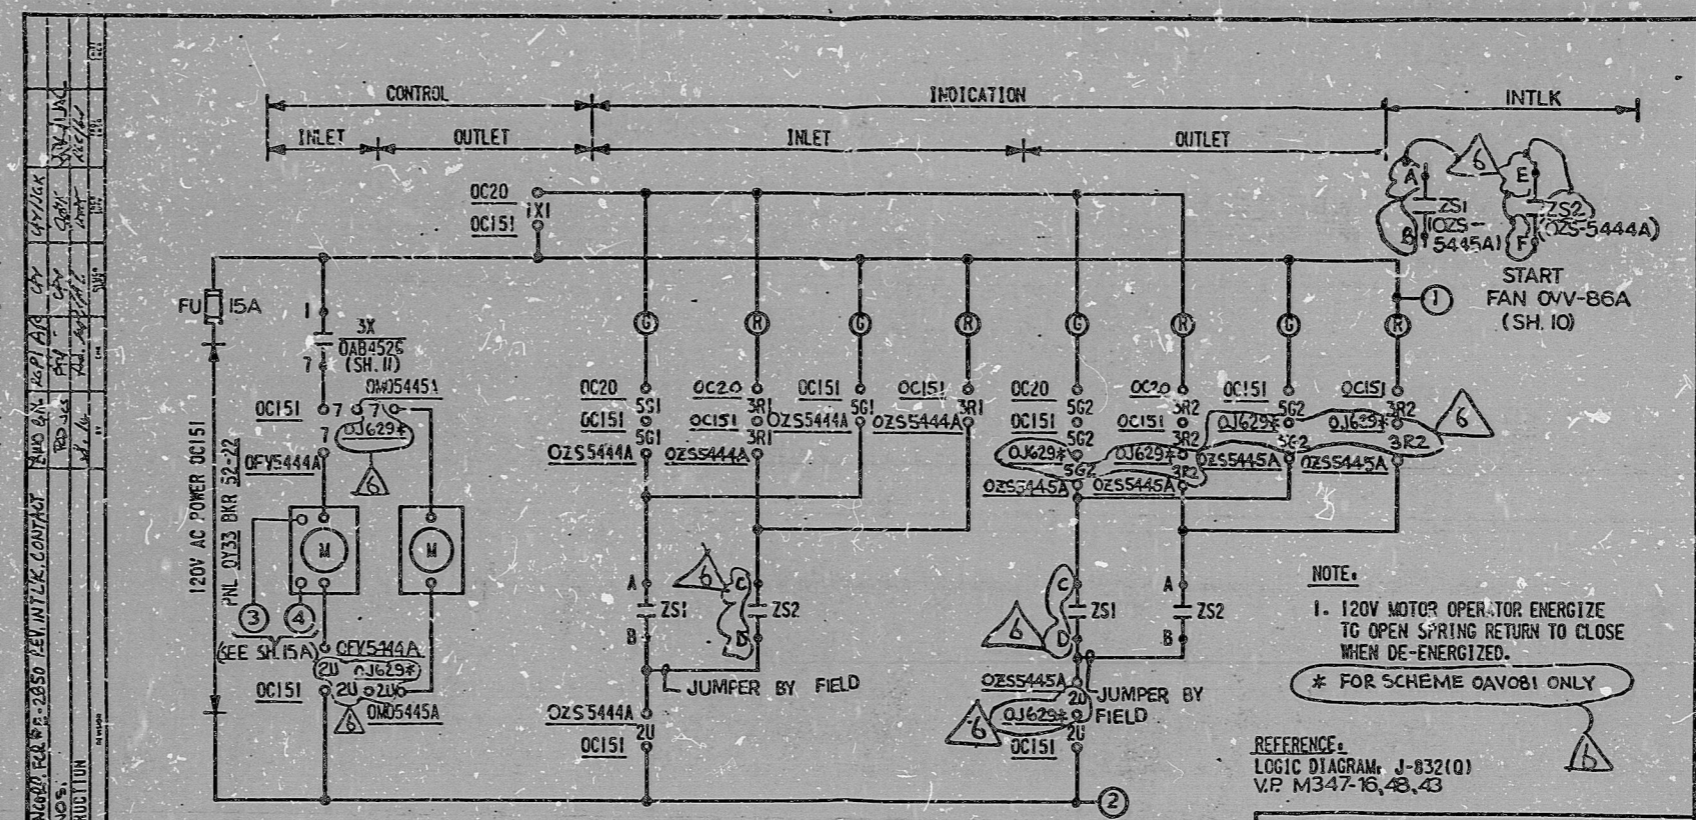

FUEL HANDLING AREA EMERGENCY EXHAUST FAN DAMPERS OFV-5444A & OMD-5445A  
 SCHEME QAV081  
 SH. DESIG C-GLF

DEVICE TABLE:  
 FU: FUSE (BUSS. MIN. 15A)

PRC  
 APERTURE  
 CARD

NOTE:  
 1. 120V MOTOR OPERATOR ENERGIZE TO OPEN SPRING RETURN TO CLOSE WHEN DE-ENERGIZED.  
 \* FOR SCHEME QAV081 ONLY

REFERENCE:  
 LOGIC DIAGRAM, J-832(1)  
 V.P. M347-16, 48, 43

BECHTEL ANN ARBOR, MICHIGAN		
MIDLAND PLANT UNITS 1 & 2 CONSUMERS POWER COMPANY		
SCHEMATIC DIAGRAM AUX. BLDG. HEATING & VENTILATION		
JOB NO. 7220	DRAWING NO. E-452(1) SH.14	REV. 6

I certify that the image contained on this frame was made in the normal and regular course of business, on the date stated below and that it is an accurate reproduction of the document submitted to reprographics.

RIDS

830209 9223

