


17"
11"
8.5"

17"
11"
8.5"

This drawing and the design it covers are the property of BECHTEL. They are hereby loaned and on the borrower's express agreement that they will not be reproduced, copied, loaned, exhibited, or used except in the limited way and pursuant to the written consent given by the lender to the borrower.
 4-19-77 REV. S.U. DESIG. ISSUED FOR CONSTRUCTION
 3-19-77 REV. S.U. DESIG. ISSUED FOR CONSTRUCTION
 1-19-77 REV. S.U. DESIG. ISSUED FOR CONSTRUCTION
 1-19-77 REV. S.U. DESIG. ISSUED FOR CONSTRUCTION

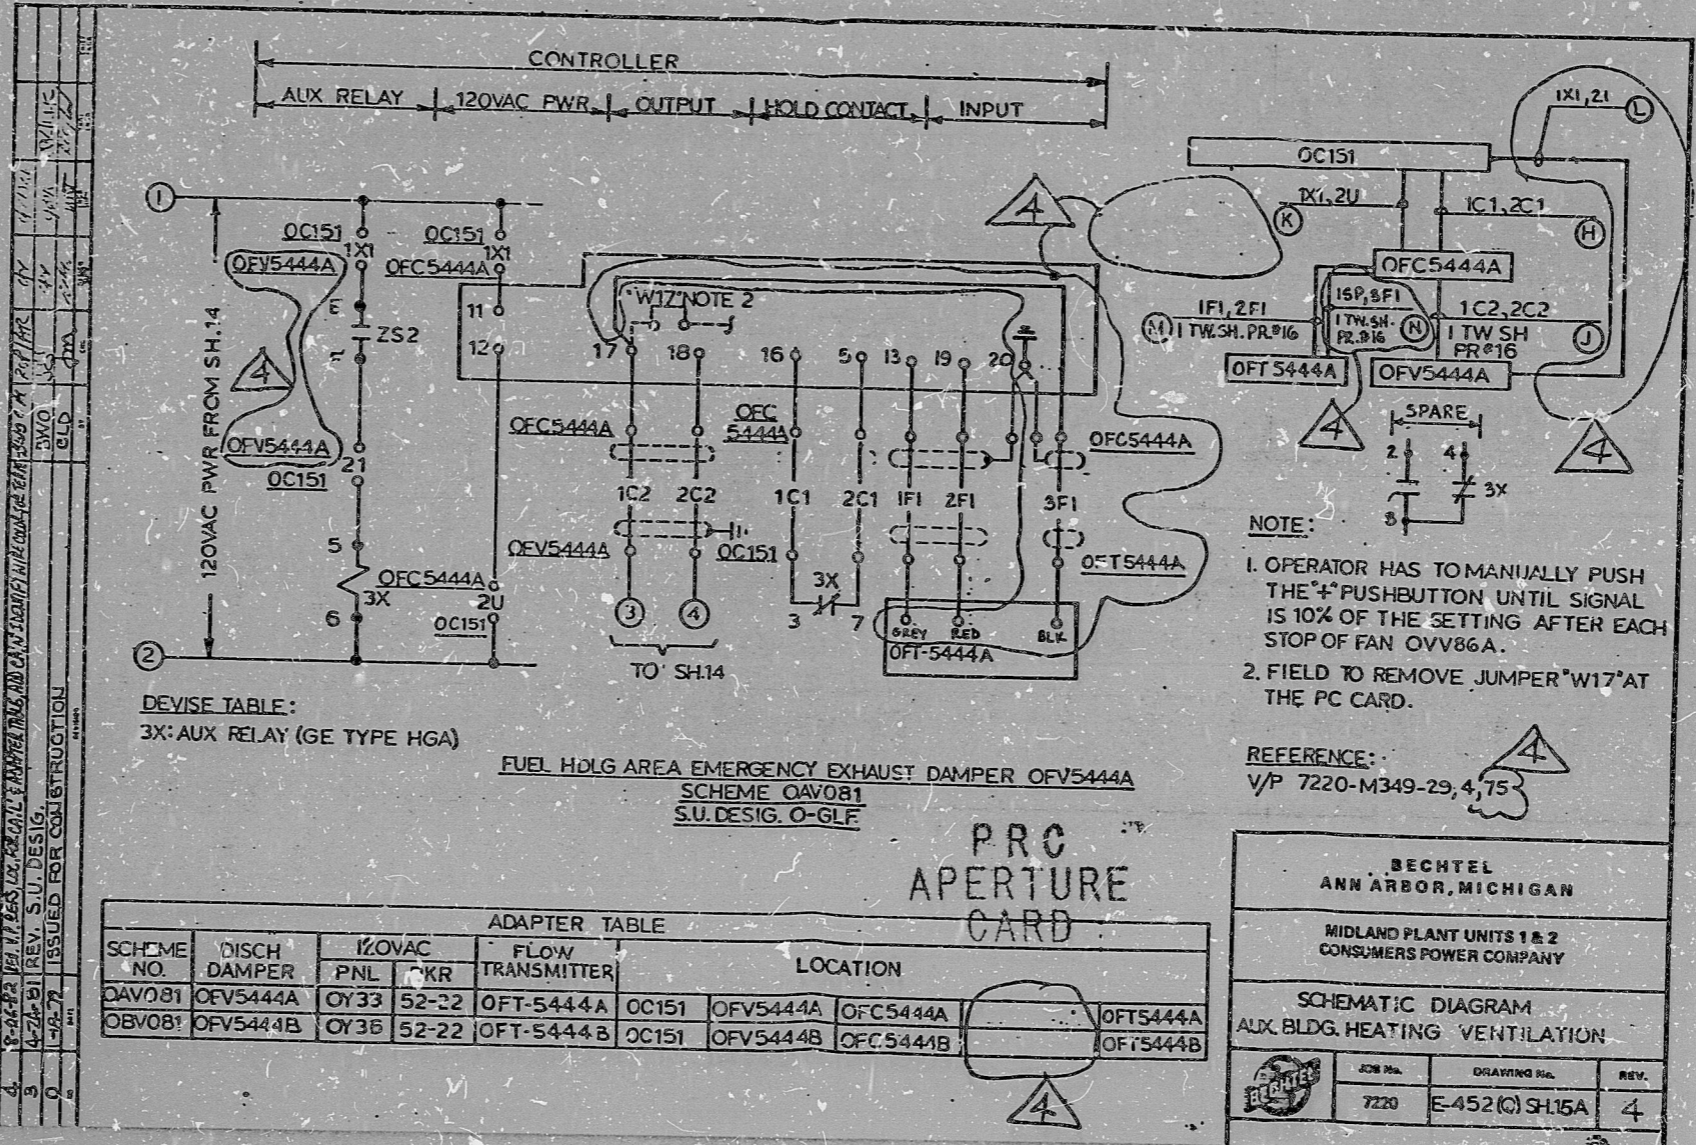

DEVISE TABLE:
 3X: AUX RELAY (GE TYPE HGA)

SCHEME NO.	DISCH DAMPER	120VAC		FLOW TRANSMITTER	LOCATION			
		PNL	KR		OC151	OFV5444A	OFC5444A	OFT5444A
OAV081	OFV5444A	OY33	52-22	OFT-5444A	OC151	OFV5444A	OFC5444A	OFT5444A
OAV081	OFV5444B	OY35	52-22	OFT-5444B	OC151	OFV5444B	OFC5444B	OFT5444B

BECHTEL
 ANN ARBOR, MICHIGAN

MIDLAND PLANT UNITS 1 & 2
 CONSUMERS POWER COMPANY

SCHEMATIC DIAGRAM
 AUX. BLDG. HEATING VENTILATION

JOB No.	DRAWING No.	REV.
7220	E-452 (C) SH.15A	4

I certify that the image contained on this frame was made in the normal and regular course of business, on the date stated below and that it is an accurate reproduction of the document submitted to reprographics.

8.5"
11"
17"

8.5"
11"
17"

RIDS

8302090228

