


11
8.5
8.5
11
17

11
8.5
8.5
11
17

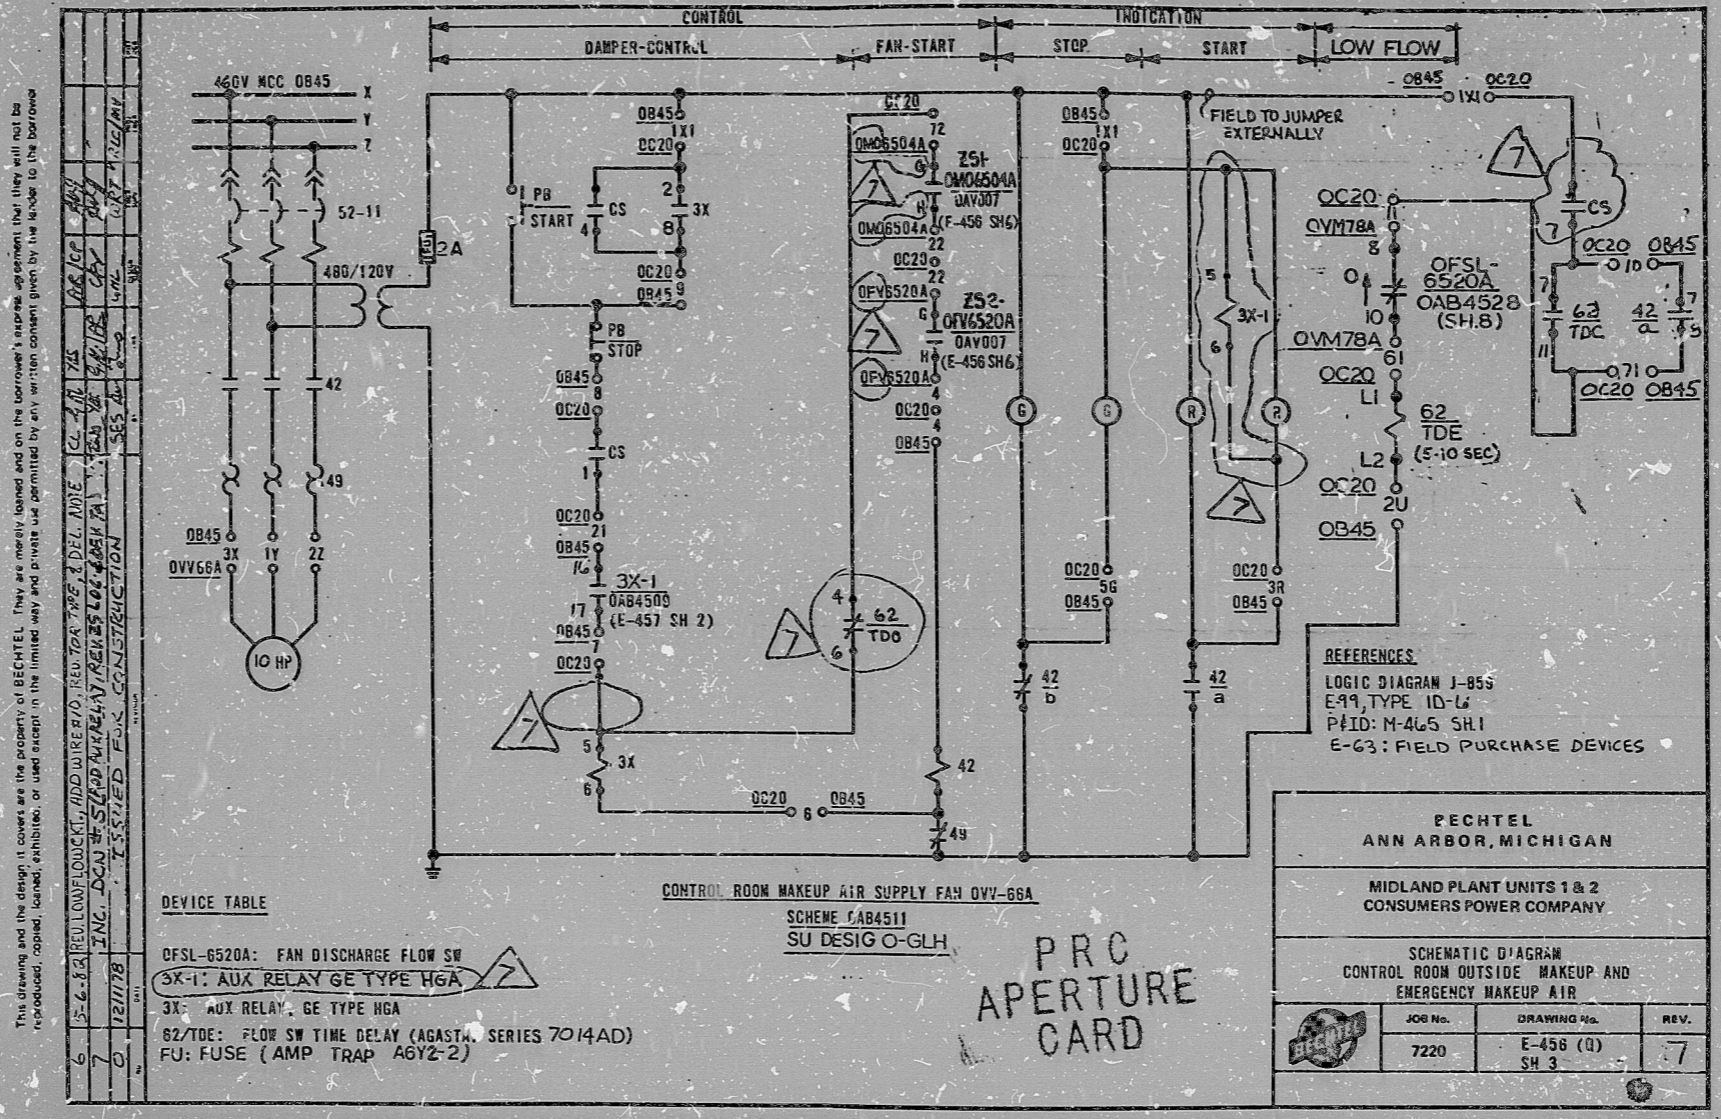

This drawing and the design it depicts are the property of BECHTEL. They are hereby loaned and on the borrower's separate agreement that they will not be reproduced, copied, loaned, exhibited, or used except in the limited way and private use permitted by any written consent given by the borrower.

8 12/11/78 ISSUED FOR CONSTRUCTION

DEVICE TABLE

DFSL-6520A:	FAN DISCHARGE FLOW SW
3X-1:	AUX RELAY GE TYPE HGA
3X:	AUX RELAY GE TYPE HGA
62/TDE:	FLOW SW TIME DELAY (AGASTA, SERIES 7014AD)
FU:	FUSE (AMP TRAP AGY2-2)

16X

CERTIFICATE OF MICROFILMING

" I certify that the image contained on this frame was made in the normal and regular course of business, on the date stated below and that it is an accurate reproduction of the document submitted to the contractor for filming, by Bechtel Power Corporation."

11-03-82 Rose Spires Sue Crockett
DATE CAMERA OPERATOR CONTRACTOR SUPERVISOR

RIDS

8302090239

