

17"

11"

8.5"

8.5"

11"

17"

17"

11"

8.5"


8.5"

11"

17"

This drawing and the design it covers are the property of BECHTEL. They are hereby loaned and on the borrower's express agreement that they will not be reproduced, copied, loaned, exhibited or used except in the limited way and within the limitations set forth in the contract between the parties to the contract.

1. INC. OCA/RS (REV 3) D/4/2/77 REV 3/1/78 CAP  
 2. 3-6-81 ADDED REF-DWG  
 3. 12/1/78 ISSUED FOR CONSTRUCTION

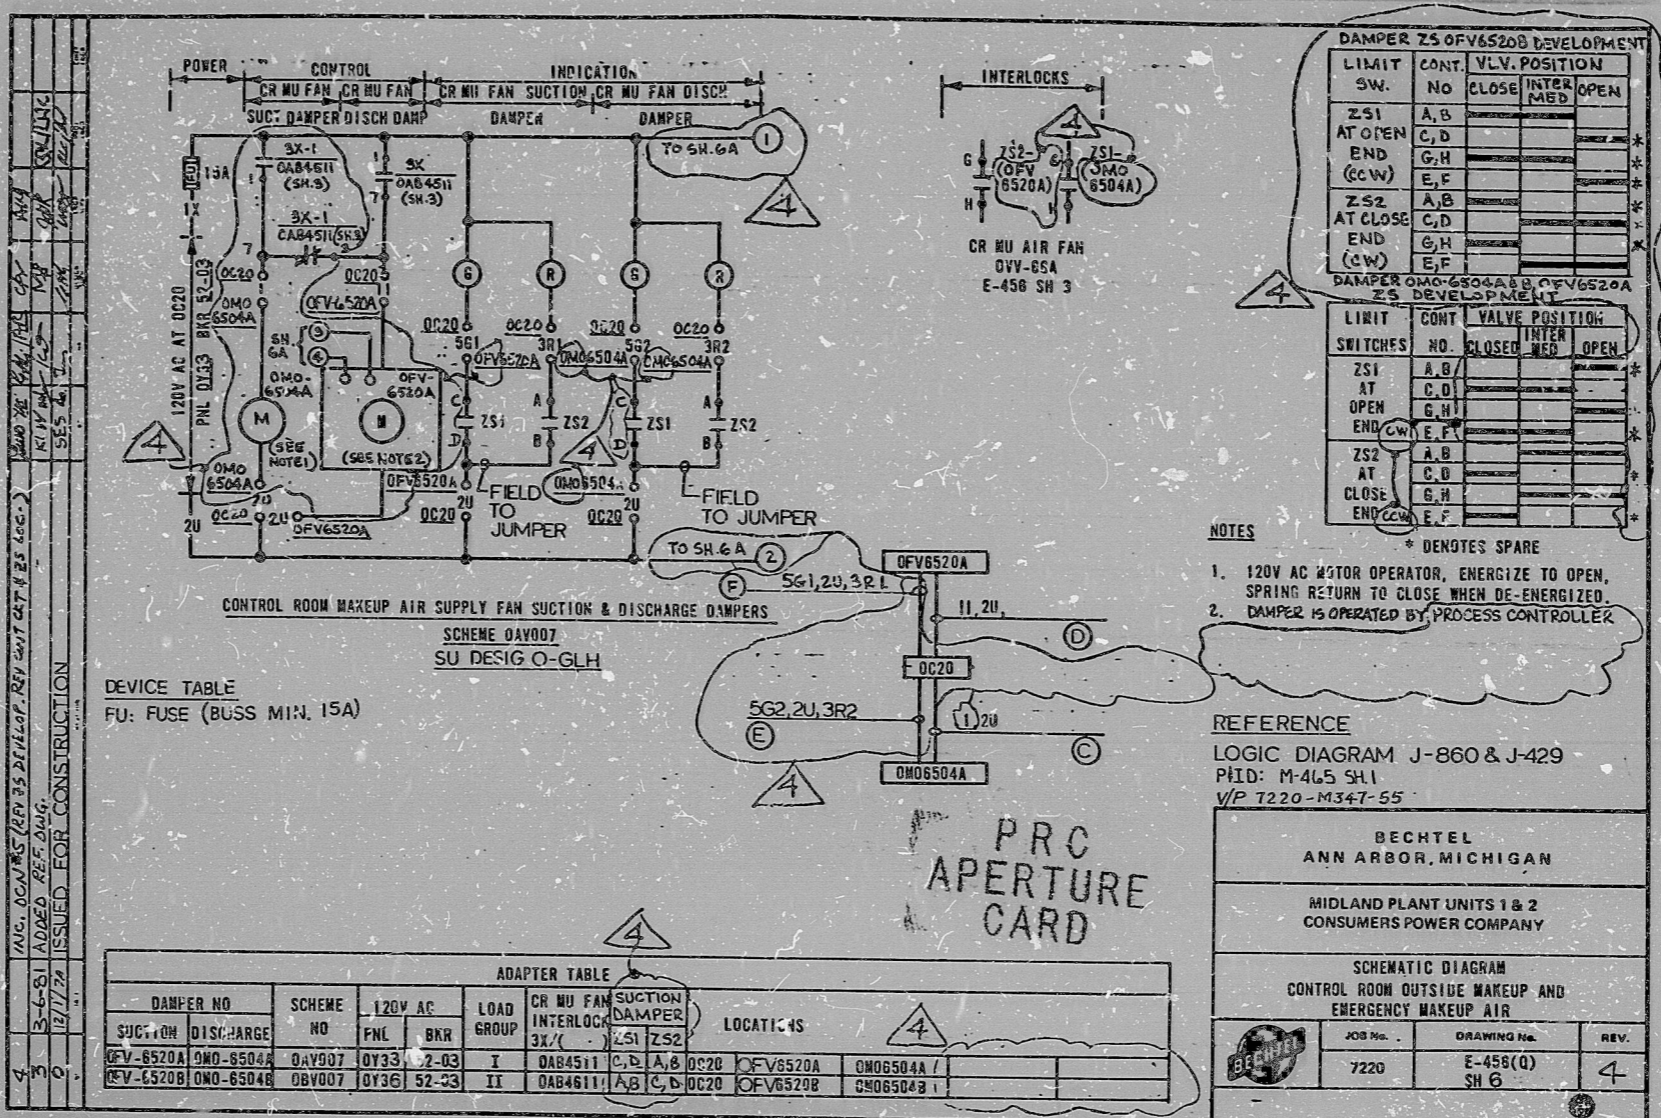

16X

**CERTIFICATE OF MICROFILMING**

"I certify that the image contained on this frame was made in the normal and regular course of business, on the date stated below and that it is an accurate reproduction of the document submitted to the contractor for filming, by Bechtel Power Corporation."

11-03-82 Rose Spres Sue Crockett  
 DATE CAMERA OPERATOR CONTRACTOR SUPERVISOR

**RIDS**

8302090243

