


17"  
11"  
8.5"

17"  
11"  
8.5"

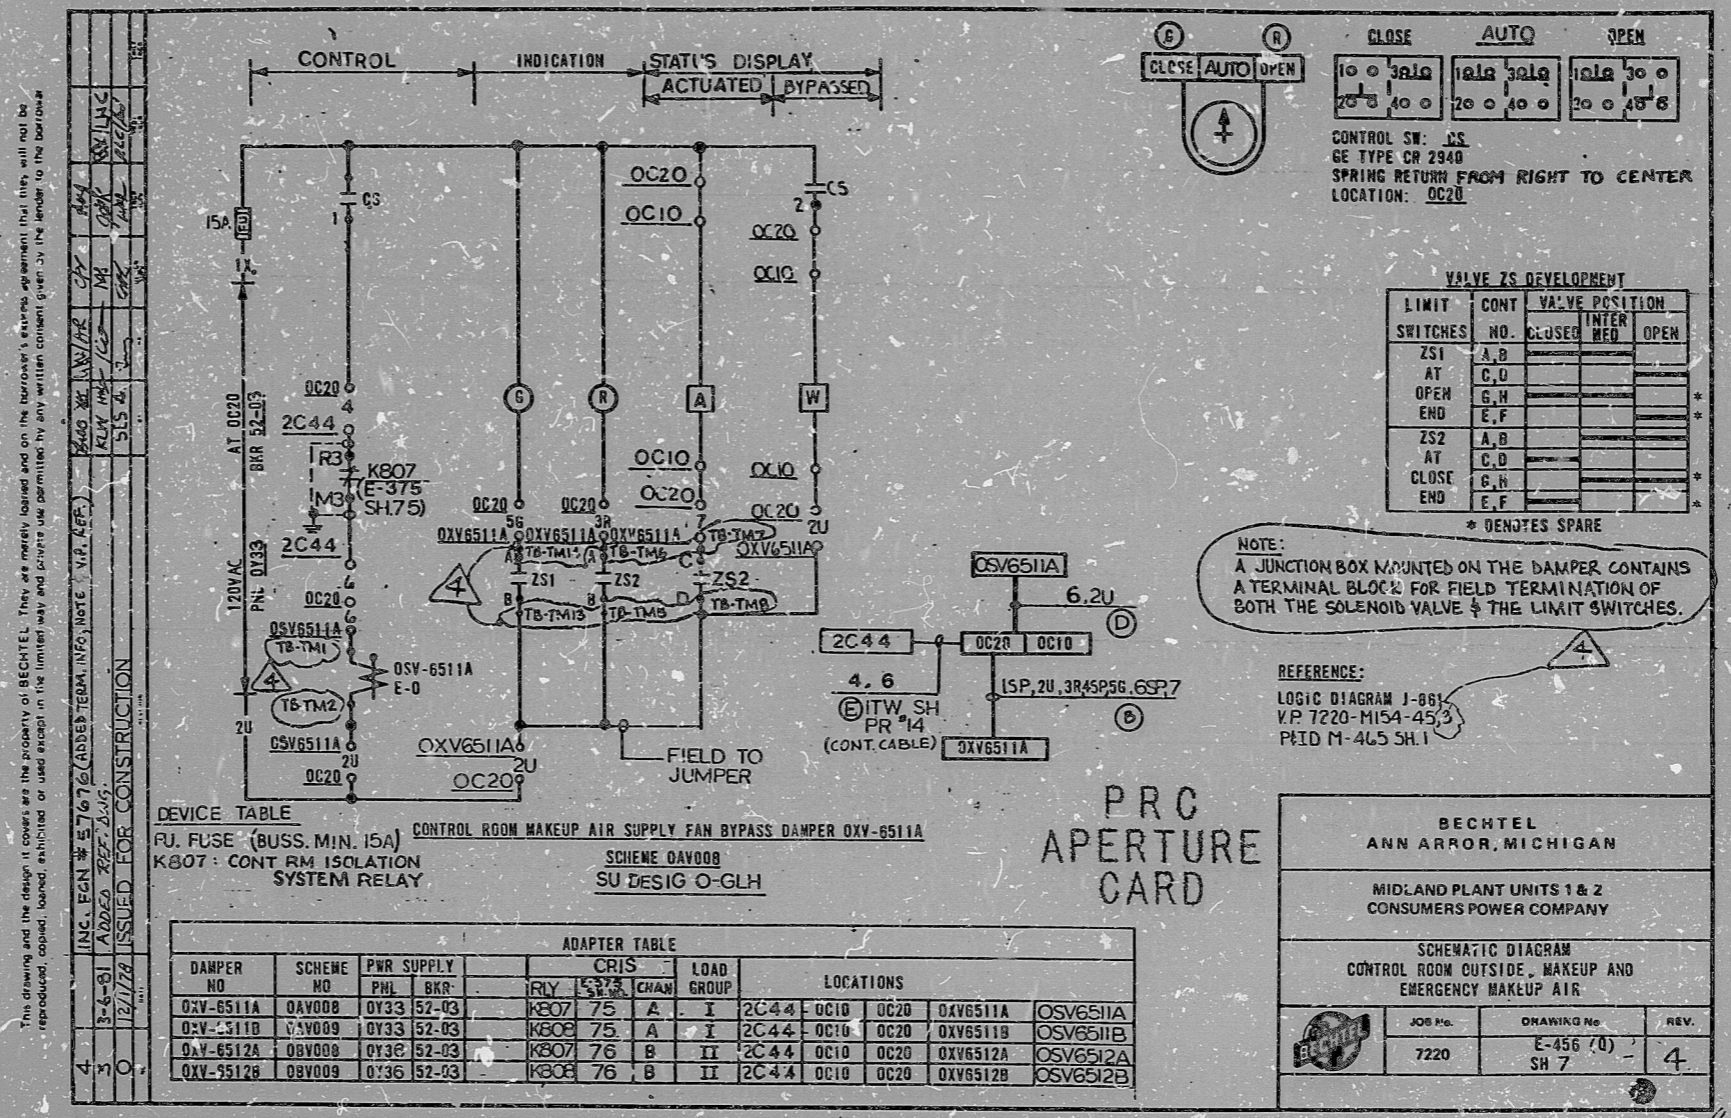

This drawing and the design it covers are the property of BECHTEL. They are hereby loaned and on the borrower's express agreement that this will not be reproduced, copied, loaned, exhibited or used except in the limited way and phrase use permitted by any written consent given by the lender to the borrower.

INC. EGN # 57676 (ADDED TERMINAL INFO, NOTE V.P. REF.)	DATE	BY	CHK
ADDED REF. TAGS	12/1/77	W. H. R.	W. H. R.
ISSUED FOR CONSTRUCTION			

**DEVICE TABLE**  
 FU. FUSE (BUSS. MIN. 15A) CONTROL ROOM MAKEUP AIR SUPPLY FAN BYPASS DAMPER OXV-6511A  
 K807: CONT RM ISOLATION SYSTEM RELAY  
 SCHEME 04V008  
 SU DESIG O-GLH

**ADAPTER TABLE**

DAMPER NO	SCHEME NO	PWR SUPPLY PHL BKR	CRIS RLY	LOAD GROUP	LOCATIONS
OXV-6511A	04V008	0Y33 52-03	K807 75 A I	I	2C44 OC10 OC20 OXV6511A OSV6511A
OXV-6511B	04V009	0Y33 52-03	K808 75 A I	I	2C44 OC10 OC20 OXV6511B OSV6511B
OXV-6512A	04V008	0Y33 52-03	K807 76 B II	II	2C44 OC10 OC20 OXV6512A OSV6512A
OXV-6512B	04V009	0Y33 52-03	K808 76 B II	II	2C44 OC10 OC20 OXV6512B OSV6512B

16X

**CERTIFICATE OF MICROFILMING**

"I certify that the image contained on this frame was made in the normal and regular course of business, on the date stated below and that it is an accurate reproduction of the document submitted to the contractor for filming, by Bechtel Power Corporation."

DATE 11-03-82 CAMERA OPERATOR Rose Spres CONTRACTOR SUPERVISOR Sue Crockett

8.5"  
11"  
17"

8.5"  
11"  
17"



RIDS

8302090246

