

11

11


8.5

11

11

8.5

This drawing and the design it covers are the property of BECHTEL. They are hereby loaned and on the borrower's express agreement that they will not be reproduced, copied, loaned, exhibited, or used except in the limited way and under the conditions permitted by any written consent given by the lender to the borrower.

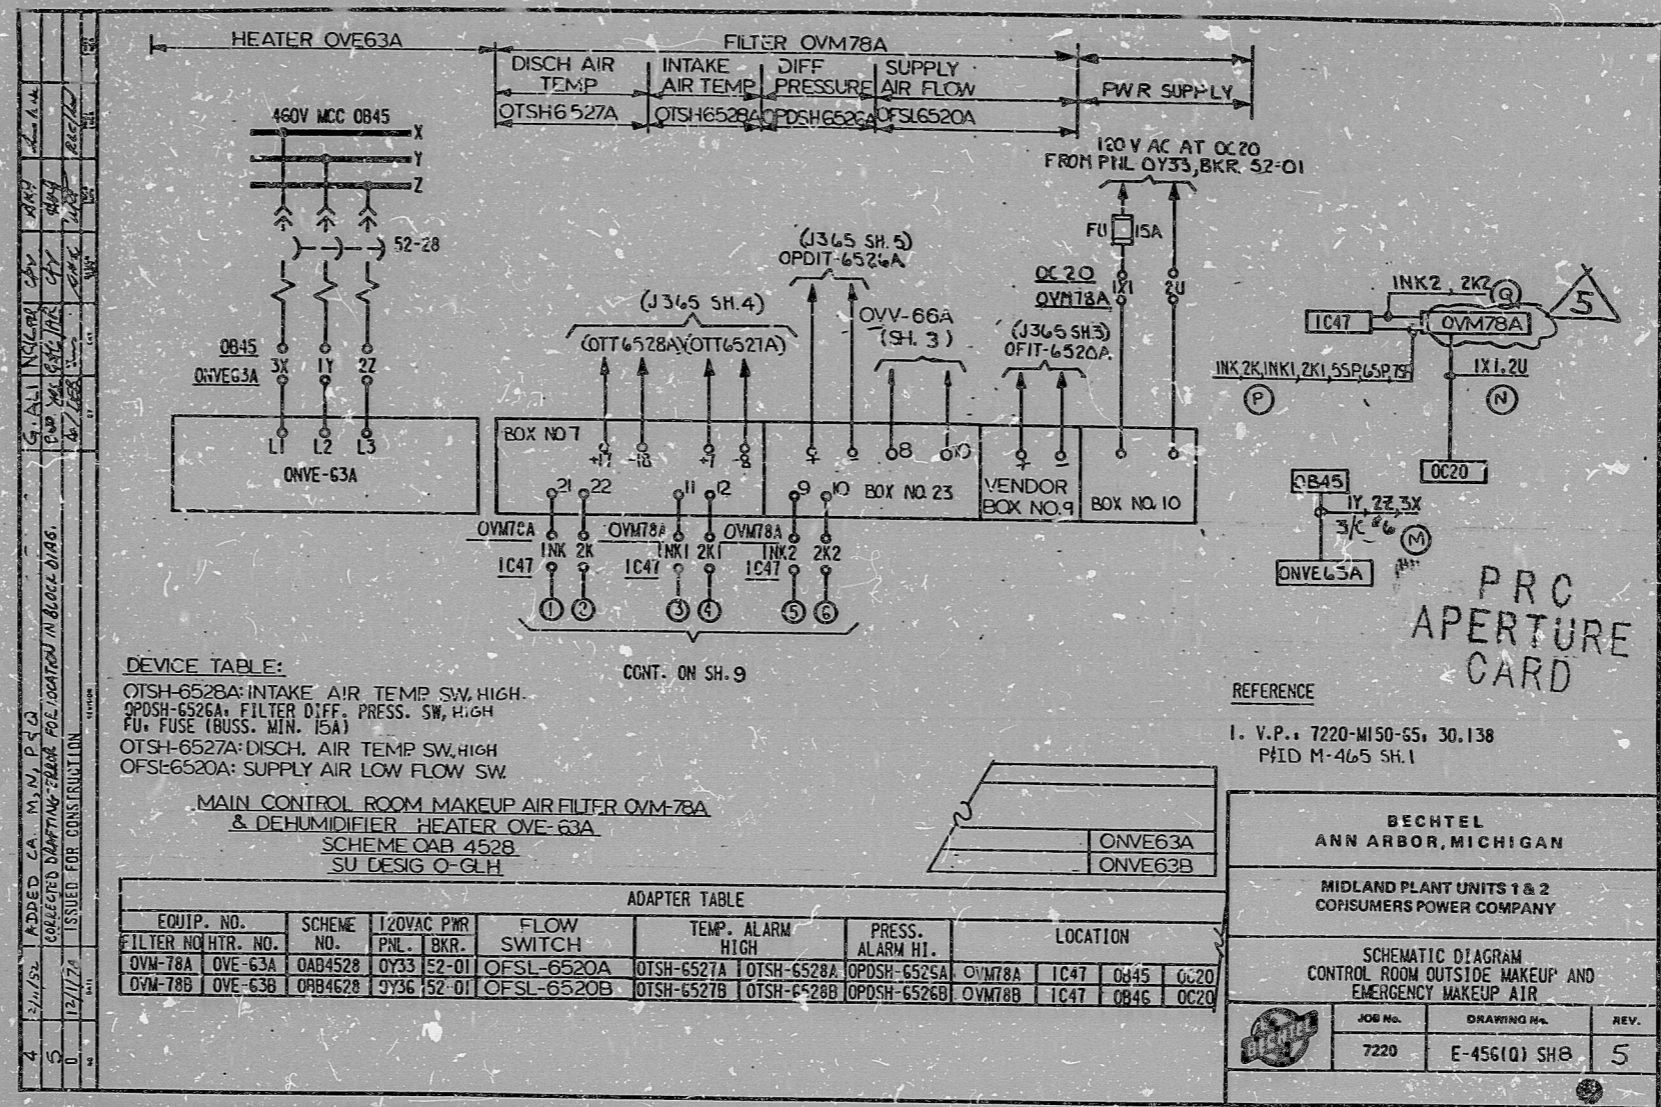

DEVICE TABLE:
 OTSH-6528A: INTAKE AIR TEMP SW. HIGH
 OPDSH-6526A: FILTER DIFF. PRESS. SW. HIGH
 FU: FUSE (BUSS. MIN. 15A)
 OTSH-6527A: DISCH. AIR TEMP SW. HIGH
 OFSE-6520A: SUPPLY AIR LOW FLOW SW.

MAIN CONTROL ROOM MAKEUP AIR FILTER OVM-78A
 & DEHUMIDIFIER HEATER OVE-63A
 SCHEME OAB 4528
 SU DESIG O-GLH

ADAPTER TABLE

EQUIP. NO.	SCHEME NO.	120VAC PWR PNL. BKR.	FLOW SWITCH	TEMP. ALARM HIGH	PRESS. ALARM HI.	LOCATION
OVMT8A	OAB4528	OY33 52-01	OFSL-6520A	OTSH-6527A	OTSH-6528A	OPDSH-6526A
OVMT8B	OAB4628	OY36 52-01	OFSL-6520B	OTSH-6527B	OTSH-6528B	OPDSH-6526B

REFERENCE
 I. V.P. 7220-M150-65, 30,138
 PHID M-465 SH.1

BECHTEL
 ANN ARBOR, MICHIGAN

MIDLAND PLANT UNITS 1 & 2
 CONSUMERS POWER COMPANY

SCHEMATIC DIAGRAM
 CONTROL ROOM OUTSIDE MAKEUP AND
 EMERGENCY MAKEUP AIR

JOB No.	DRAWING No.	REV.
7220	E-4561(1) SHB	5

16X

CERTIFICATE OF MICROFILMING

"I certify that the image contained on this frame was made in the normal and regular course of business, on the date stated below and that it is an accurate reproduction of the document submitted to the contractor for filming, by Bechtel Power Corporation."

11-03-82 Rose Spires Sue Crockett
 DATE CAMERA OPERATOR CONTRACTOR SUPERVISOR

8.5"

11"

17"

8.5"

11"

17"

RIDS

8302090248

