

17"

11"

8.5"

8.5"

11"

17"

17"

11"

8.5"


8.5"

11"

17"

The drawing and the design it covers are the property of BECHTEL. They are hereby loaned and in the borrower's extreme agreement that they will not be reproduced, copied, altered, exhibited, or used in any way without the prior written consent given by the lender to the borrower.

5-1-62 RELATIONSHIP ADDRESS # 51, 52, 53, 1000.

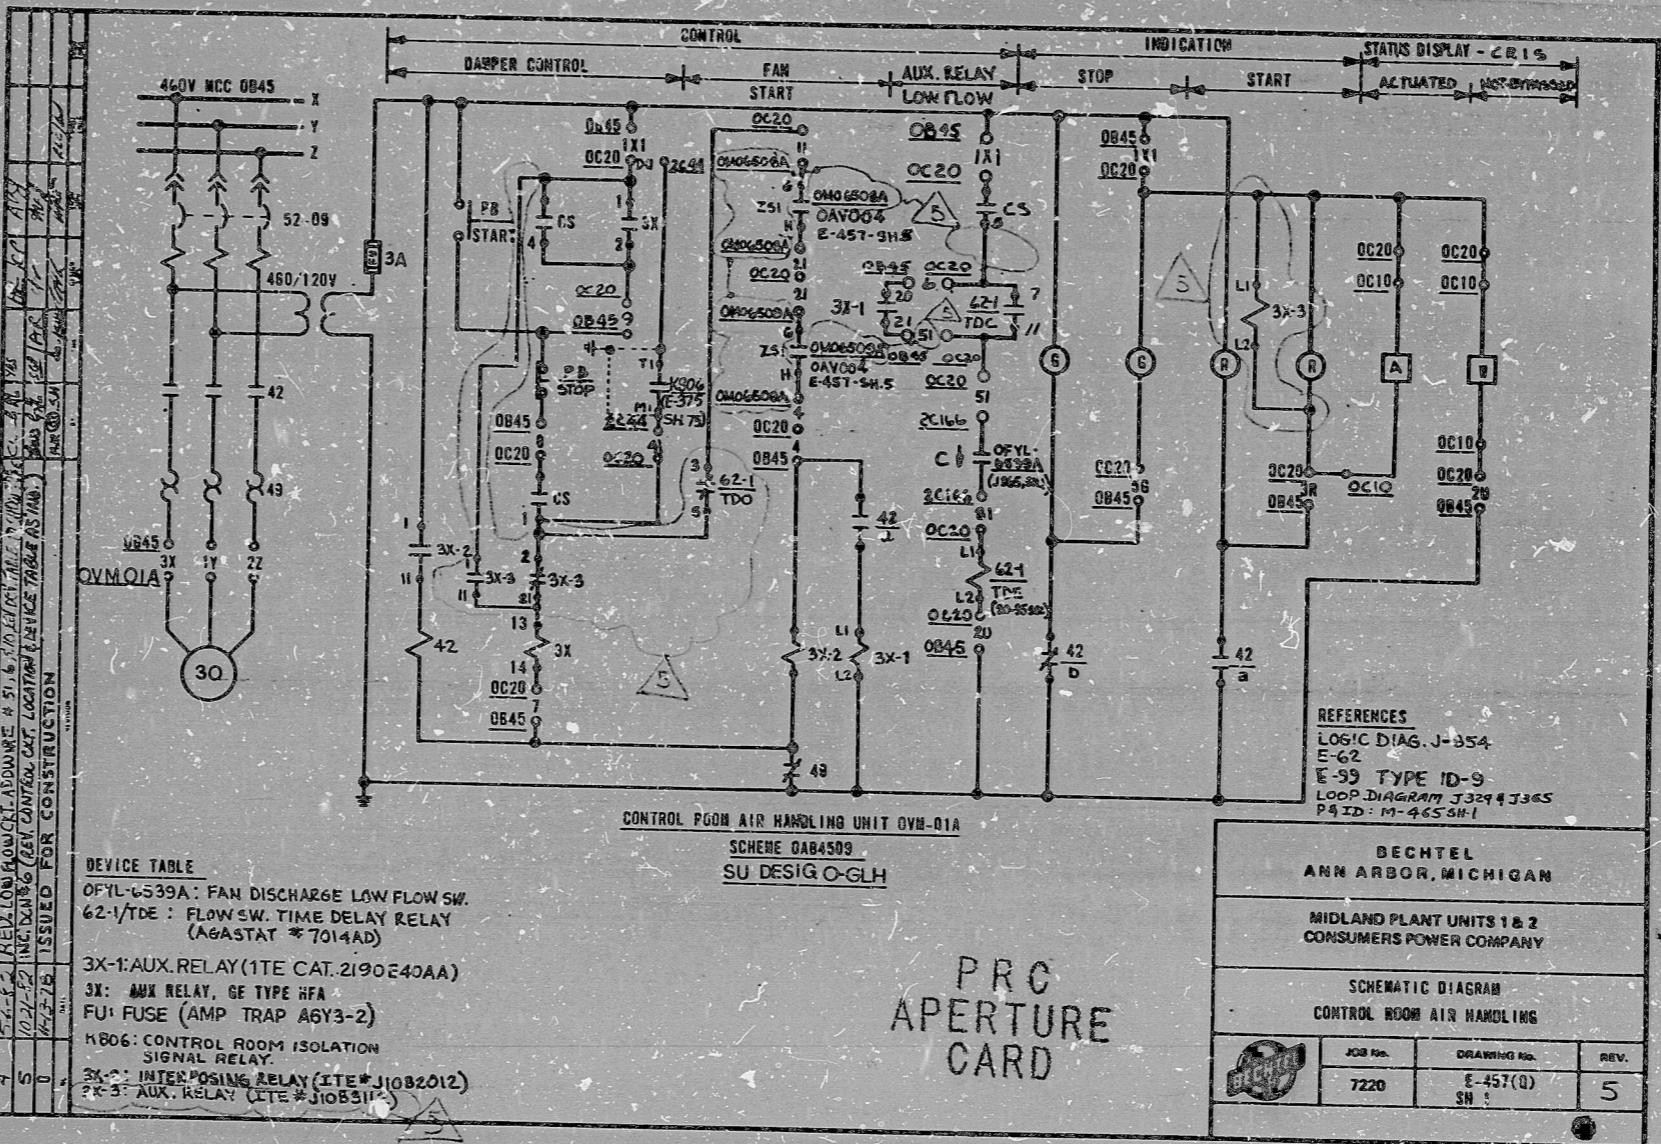

DEVICE TABLE

OFYL-6539A	FAN DISCHARGE LOW FLOW SW.
62-1/TDE	FLOW SW. TIME DELAY RELAY (AGASTAT *7014AD)
3X-1	AUX. RELAY (1TE CAT. 2190E4JAA)
3X	AUX. RELAY, GE TYPE HFA
FU	FUSE (AMP TRAP AGY3-2)
K806	CONTROL ROOM ISOLATION SIGNAL RELAY
3X-2	INTERPOSING RELAY (ITE # J1082012)
3X-3	AUX. RELAY (ITE # J108311)

CONTROL ROOM AIR HANDLING UNIT OVM-01A
 SCHEME 0AB4509
 SU DESIG O-GLH

PRO
 APERTURE
 CARD

REFERENCES
 LOGIC DIAG. J-354
 E-62
 E-99 TYPE 1D-9
 LOOP DIAGRAM J3294 J365
 P4 ID: M-465 SH-1

BECHTEL ANN ARBOR, MICHIGAN		
MIDLAND PLANT UNITS 1 & 2 CONSUMERS POWER COMPANY		
SCHEMATIC DIAGRAM CONTROL ROOM AIR HANDLING		
JOB No.	DRAWING No.	REV.
7220	E-457(D) SN	5

16X

I certify that the image contained on this frame was made in the normal and regular course of business, on the date stated below and that it is an accurate reproduction of the document submitted to the contractor for filming, by Bechtel Power Corporation.

DATE: 10-22-62
 CAMERA OPERATOR: [Signature]
 CONTRACTOR'S SUPERVISOR OR MANAGER: [Signature]

RIDS

8302090265

