

17"

11"


8.5"

17"

11"

8.5"

This drawing and the design it covers are the property of BECHTEL. They are made, issued, and on file in accordance with the agreement that they will not be reproduced, copied, loaned, exhibited, or used (except in the limited way and for the purpose intended) by any person other than those named in the title block to the hardware.

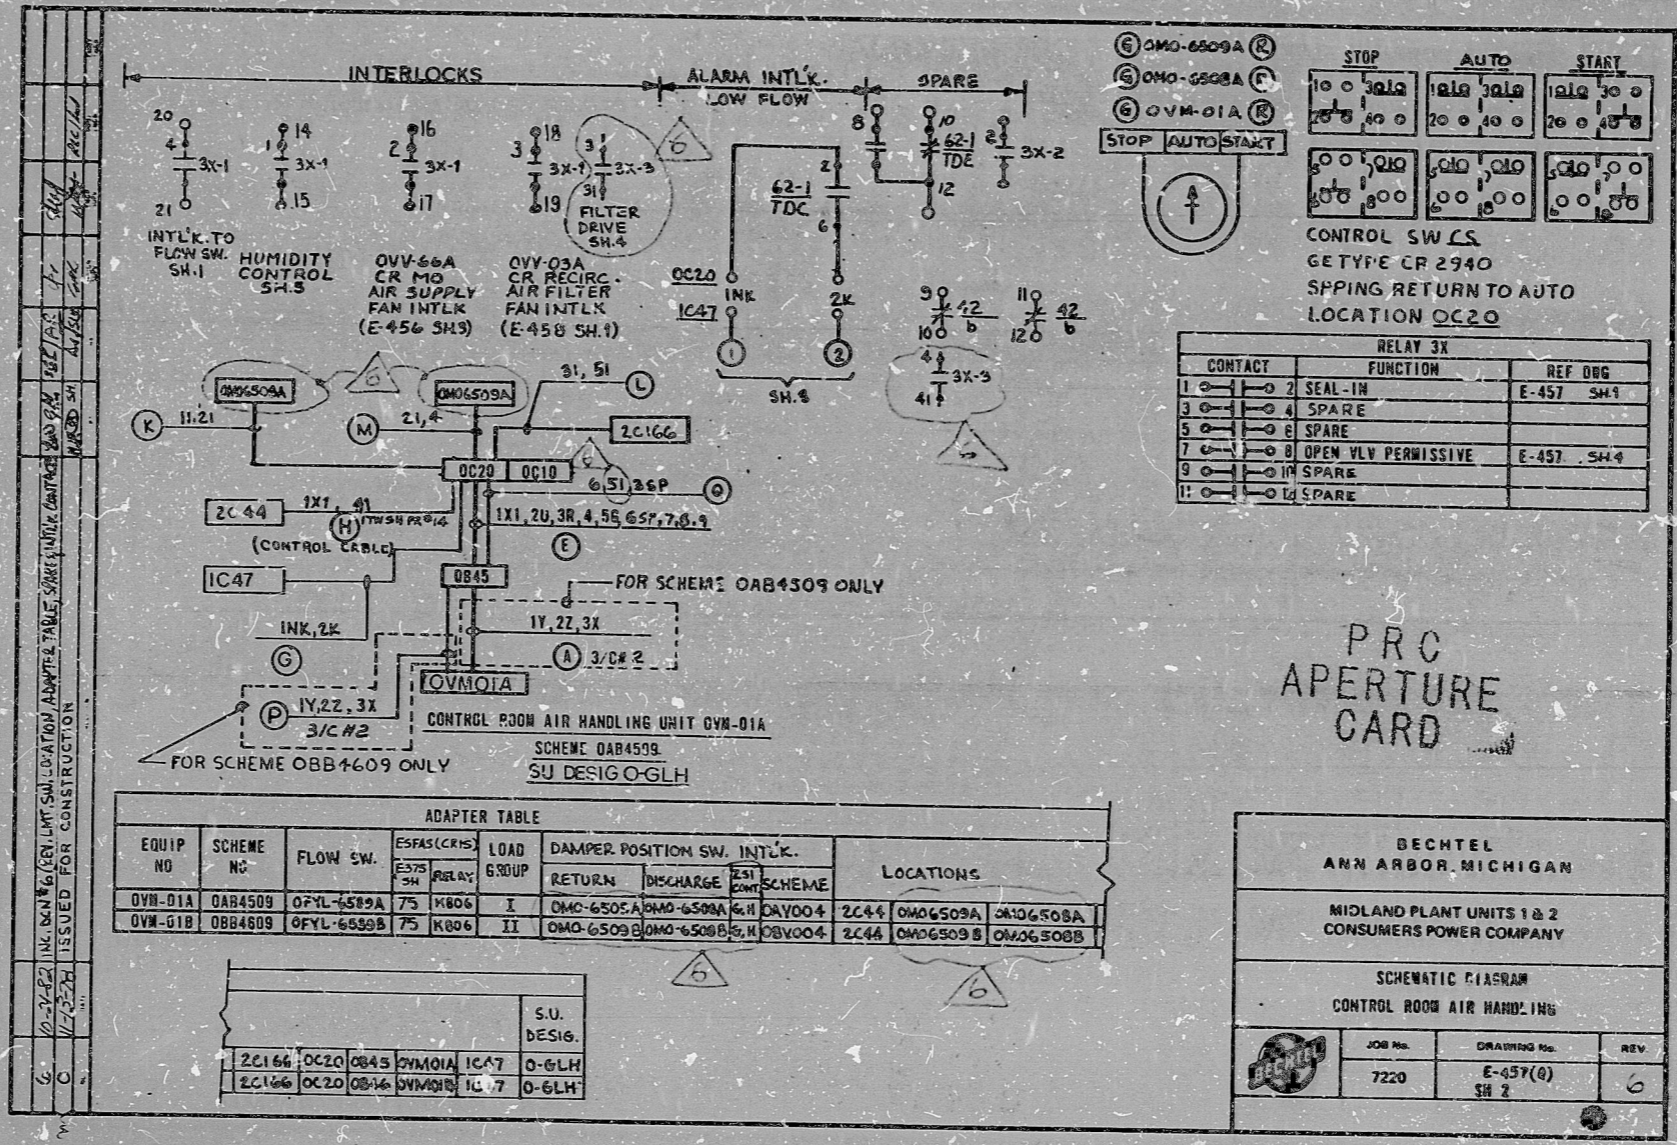

PRC APERTURE CARD

BECHTEL ANN ARBOR, MICHIGAN		
MIDLAND PLANT UNITS 1 & 2 CONSUMERS POWER COMPANY		
SCHEMATIC DIAGRAM CONTROL ROOM AIR HANDLING		
JOB No.	DRAWING No.	REV.
7220	E-457(8) SH 2	6

16X

I certify that the image contained on this frame was made in the normal and regular course of business, on the date stated below and that it is an accurate reproduction of the document submitted to the contractor for filing, by Bechtel Power Corporation.

DATE: 10-3-82  
CAMERA OPERATOR: R. Ripelle  
CONTRACTOR'S SUPERVISOR OR MANAGER: [Signature]

8.5"

11"

17"

8.5"

11"

17"

**RIDS**

8302090266

