


This drawing and the design it covers are the property of BECHTEL. They are hereby loaned and on the borrower's express agreement that they will not be reproduced, copied, loaned, exhibited, or used except in the limited way and private use permitted by any written consent given by the lender to the borrower.

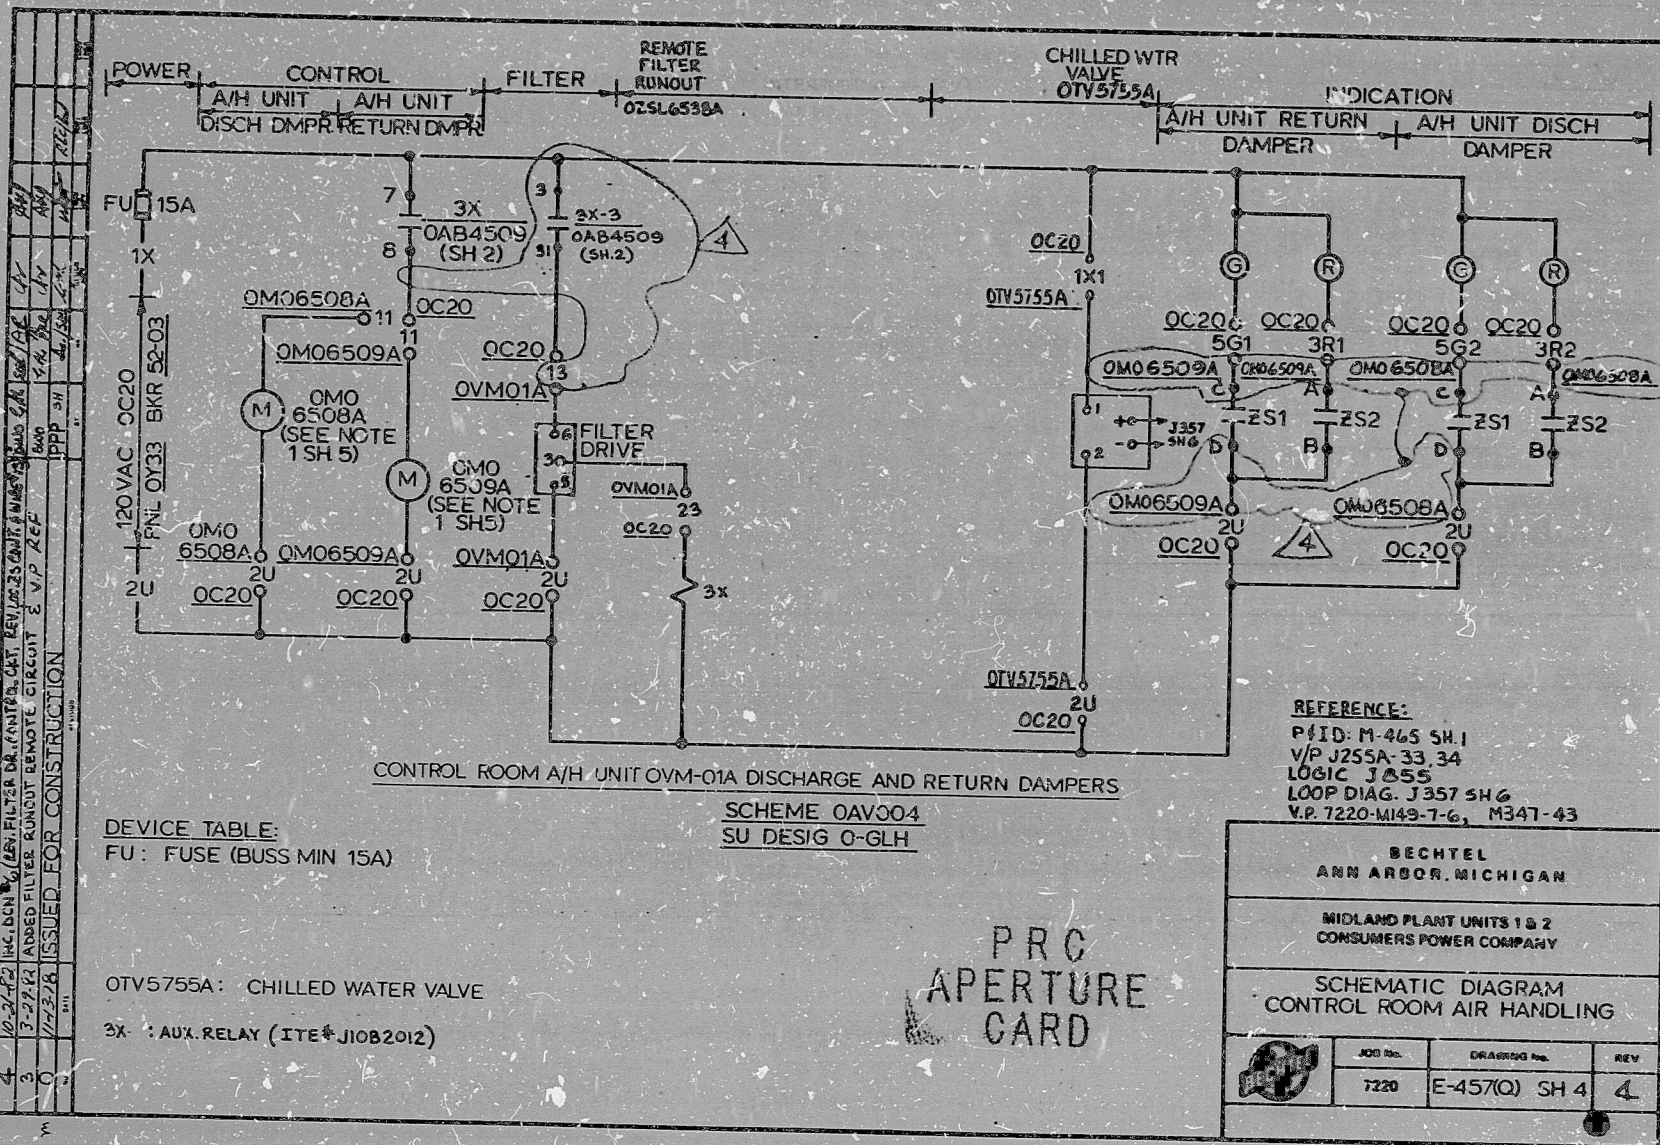

DEVICE TABLE:
 FU: FUSE (BUSS MIN 15A)

0TV5755A: CHILLED WATER VALVE
 3X: AUX. RELAY (ITE# J10B2012)

SCHEME 0AV004
 SU DESIG 0-GLH

PRC
 APERTURE
 CARD

REFERENCE:
 P.I.D. M-465 SH.1
 V.P. J255A-33, 34
 LOGIC J 055
 LOOP DIAG. J357 SH 6
 V.P. 7220-M149-T-6, M347-43

| | | |
|------------------------------------------------------|------------------------------|----------|
| BECHTEL ANN ARBOR, MICHIGAN | | |
| MIDLAND PLANT UNITS 1 & 2 CONSUMERS POWER COMPANY | | |
| SCHEMATIC DIAGRAM CONTROL ROOM AIR HANDLING | | |
| JOB No. 7220 | DRAWING No. E-457(Q) SH 4 | REV 4 |

16X

I certify that the image contained on this frame was made in the normal and regular course of business, on the date stated below and that it is an accurate reproduction of the document submitted to the contractor for filming, by Bechtel Power Corporation.

DATE: 10/28/52
 CAMERA OPERATOR: [Signature]
 CONTRACTOR'S SUPERVISOR OR MANAGER: [Signature]

RIDS

8302090269

