


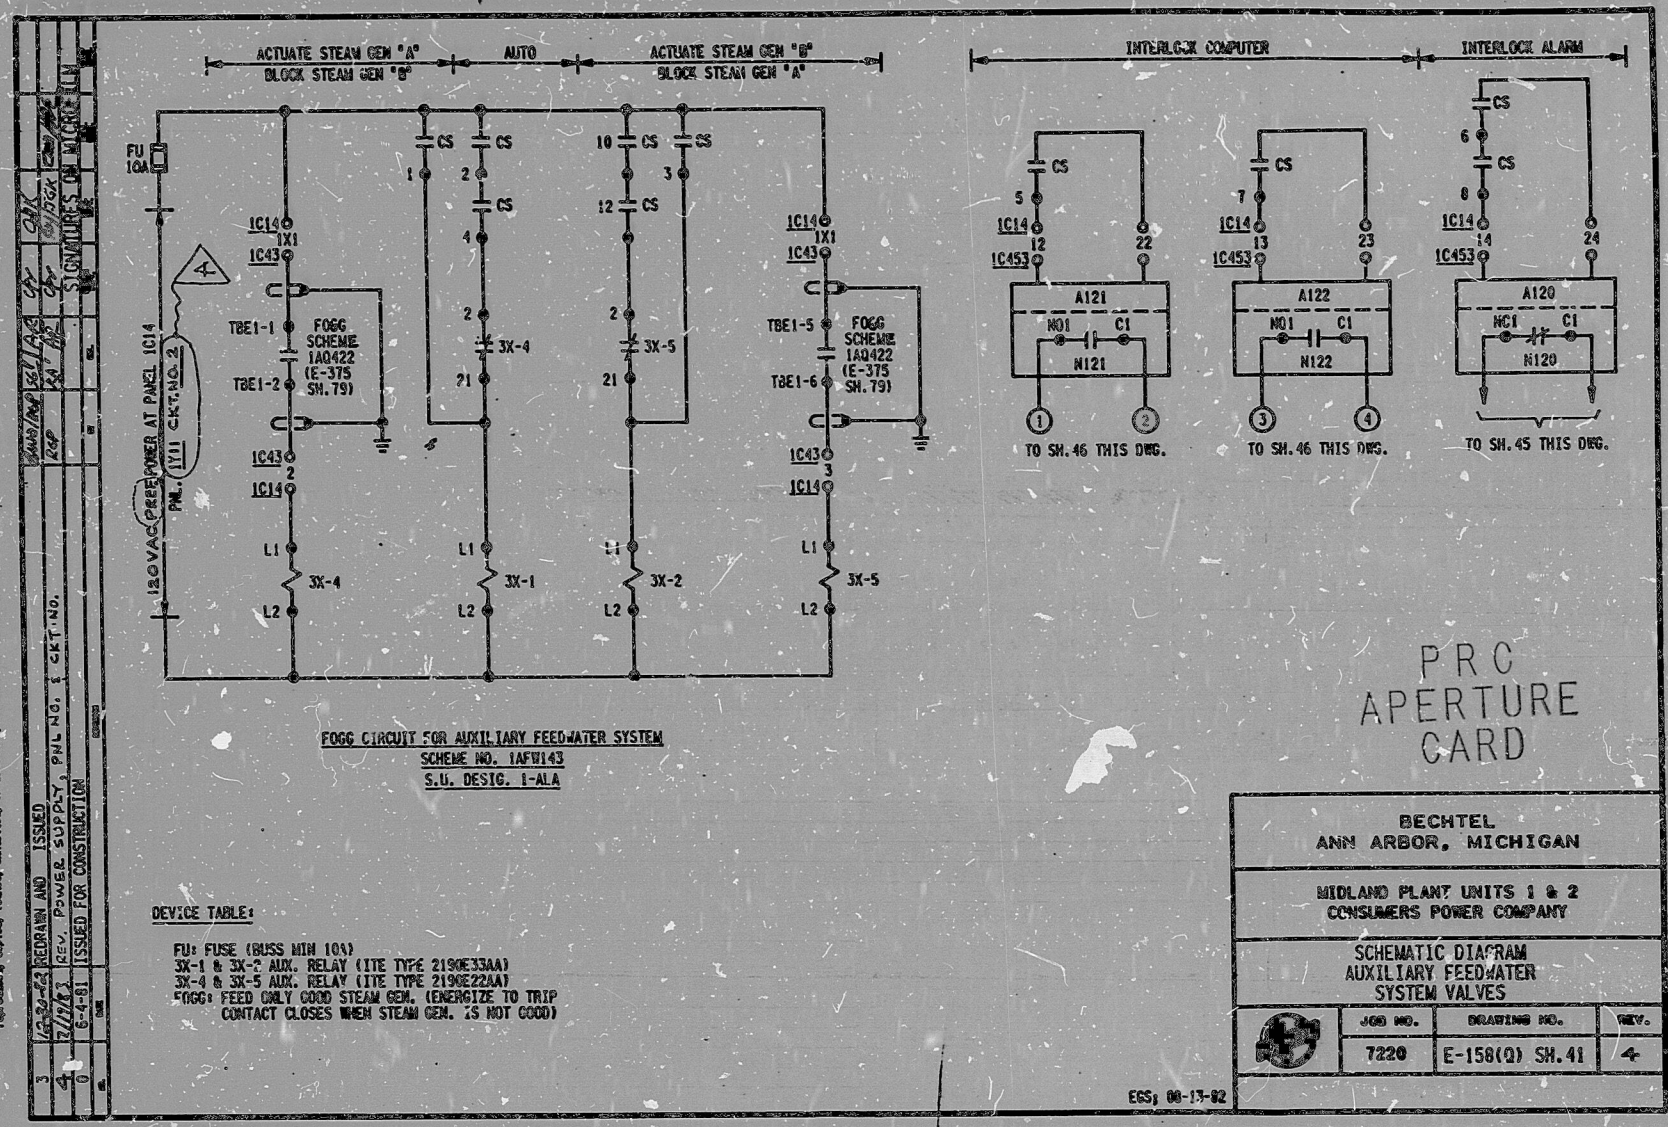

I certify that the image contained on this frame was made in the normal and regular course of business, on the date stated below and that it is an accurate reproduction of the document submitted to reprographics.

8-5-83
DATE

A. K. Kiser
CAMERA OPERATOR

Supervisor of
Micrographics

10X

PDR RIDS

8401170516

