




I certify that the image contained on this frame was made in the normal and regular course of business, on the date stated below and that it is an accurate reproduction of the document submitted to reprographics.

8-5-63 *G. Kaiser*
DATE CAMERA OPERATOR
3-12-68 *L. J. Stegman*
SUPERVISOR OF MICROGRAPHY

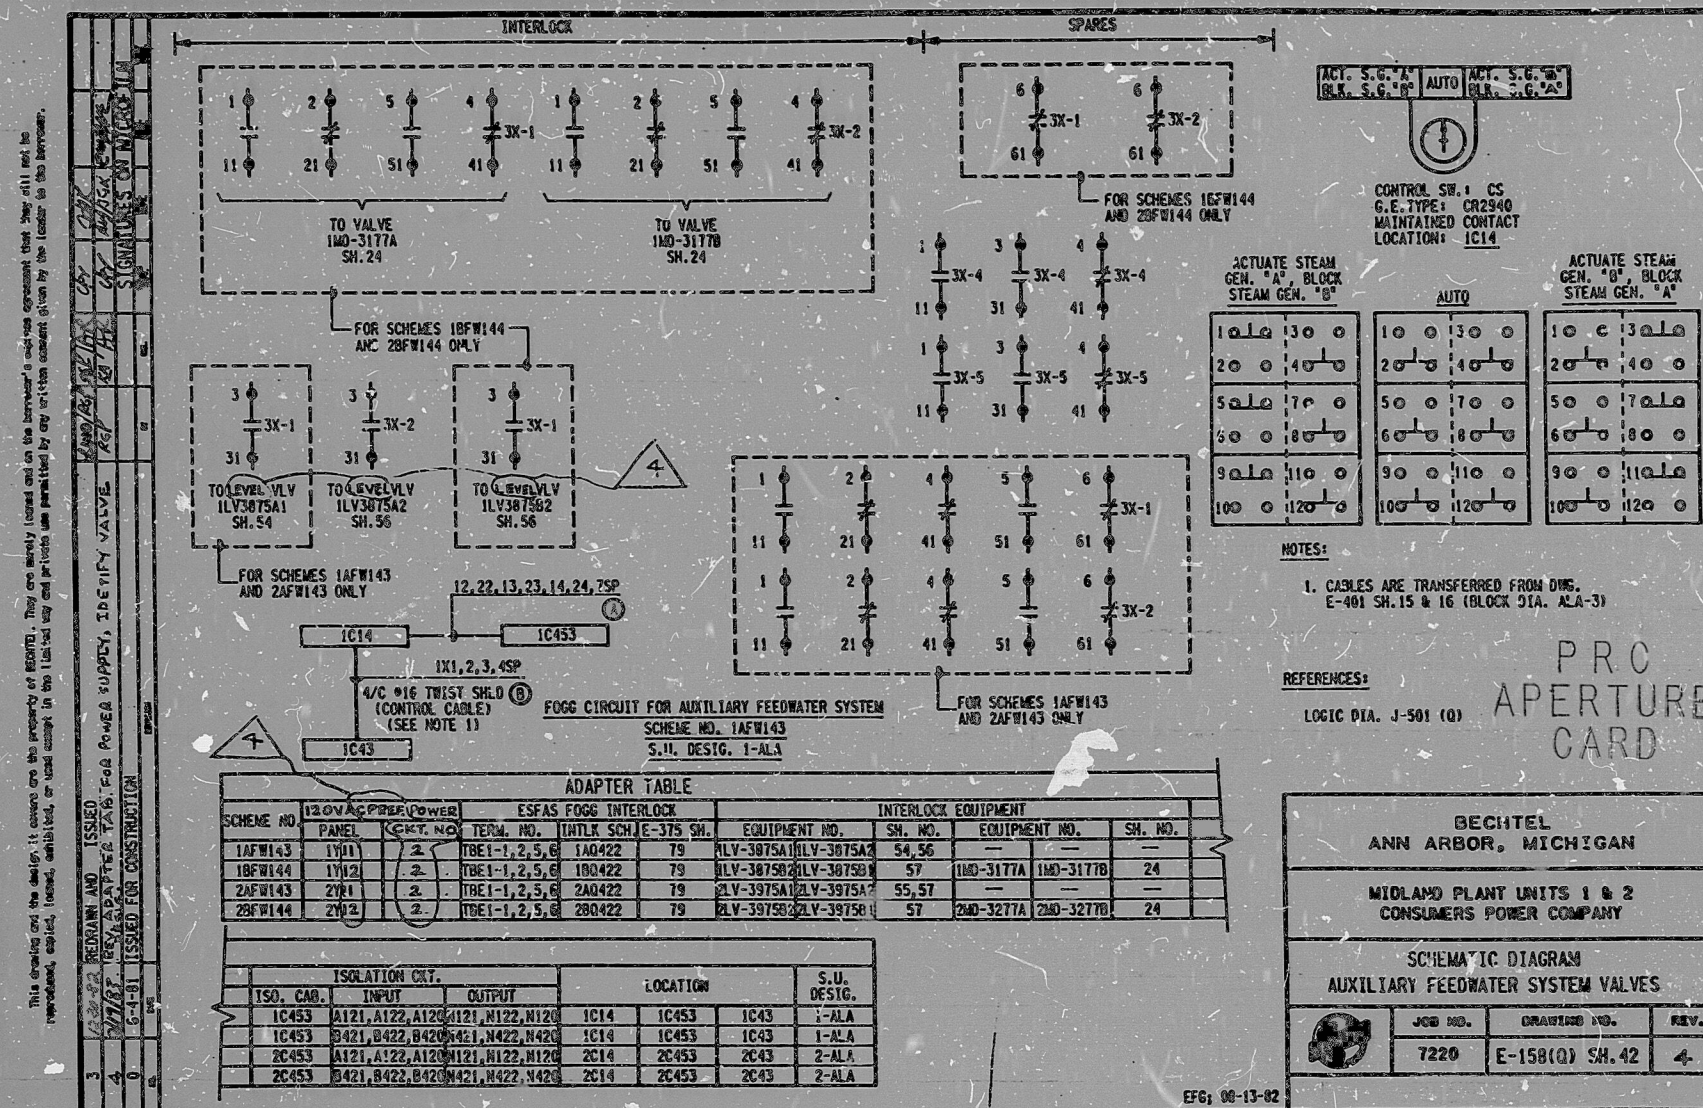

PDR RIDS

84 01170535

