
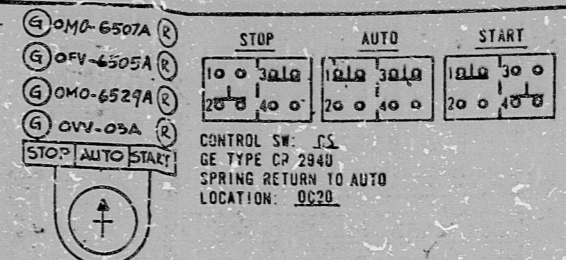


This drawing and the design it covers are the property of BECHTEL. They are hereby loaned to the borrower's service, agreement and they will not be reproduced, copied, loaned, exhibited or used except in the limited way and private use permitted by any written contract given by the lender to the borrower.

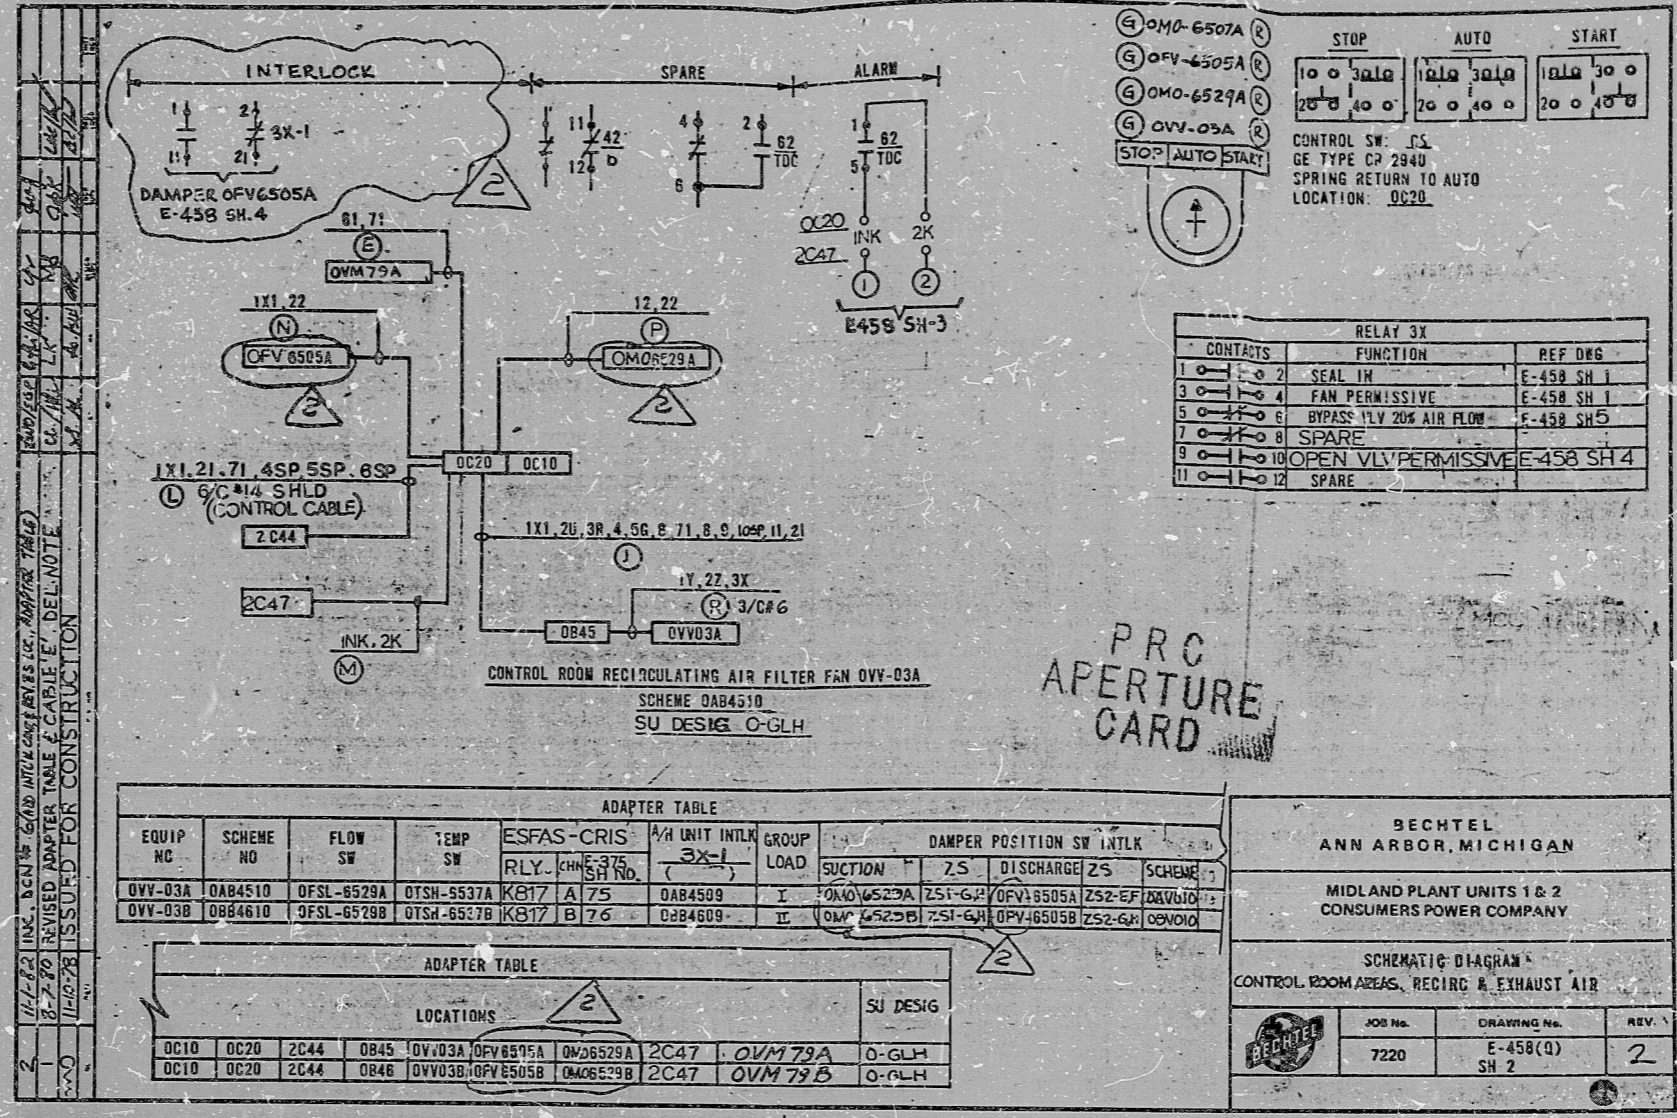

RELAY 3X		
CONTACTS	FUNCTION	REF DWG
1-2	SEAL IN	E-458 SH 1
3-4	FAN PERMISSIVE	E-458 SH 1
5-6	BYPASS VLV 20% AIR FLOW	E-458 SH 5
7-8	SPARE	
9-10	OPEN VLV PERMISSIVE	E-458 SH 4
11-12	SPARE	

PRC
 APERTURE
 CARD

ADAPTER TABLE												
EQUIP NO	SCHEME NO	FLOW SW	TEMP SW	ESFAS-CRIS RLY. CH. E-375 SH NO.	A/H UNIT INTLK (3X-1)	GROUP LOAD	DAMPER POSITION SW INTLK			SCHEME NO		

ADAPTER TABLE										
LOCATIONS										

BECHTEL
 ANN ARBOR, MICHIGAN

MIDLAND PLANT UNITS 1 & 2
 CONSUMERS POWER COMPANY

SCHEMATIC DIAGRAM
 CONTROL ROOM AREAS, RECIRC & EXHAUST AIR

JOB No.	DRAWING No.	REV.
7220	E-458(1) SH 2	2

RIDS

8302090278

