


This drawing and the design it covers are the property of BECHTEL. They are hereby loaned and on the borrower's extreme agreement that they will not be reproduced, copied, loaned, antitised, or used except in the limited way and for the purposes specified by the lender or the borrower.

1-8-61 REV. PNL & FROM OYAS TO OYSC  
 11-25-52 REV. PNL & FROM OYAS TO OYSC  
 8-27-50 ISSUED FOR CONSTRUCTION

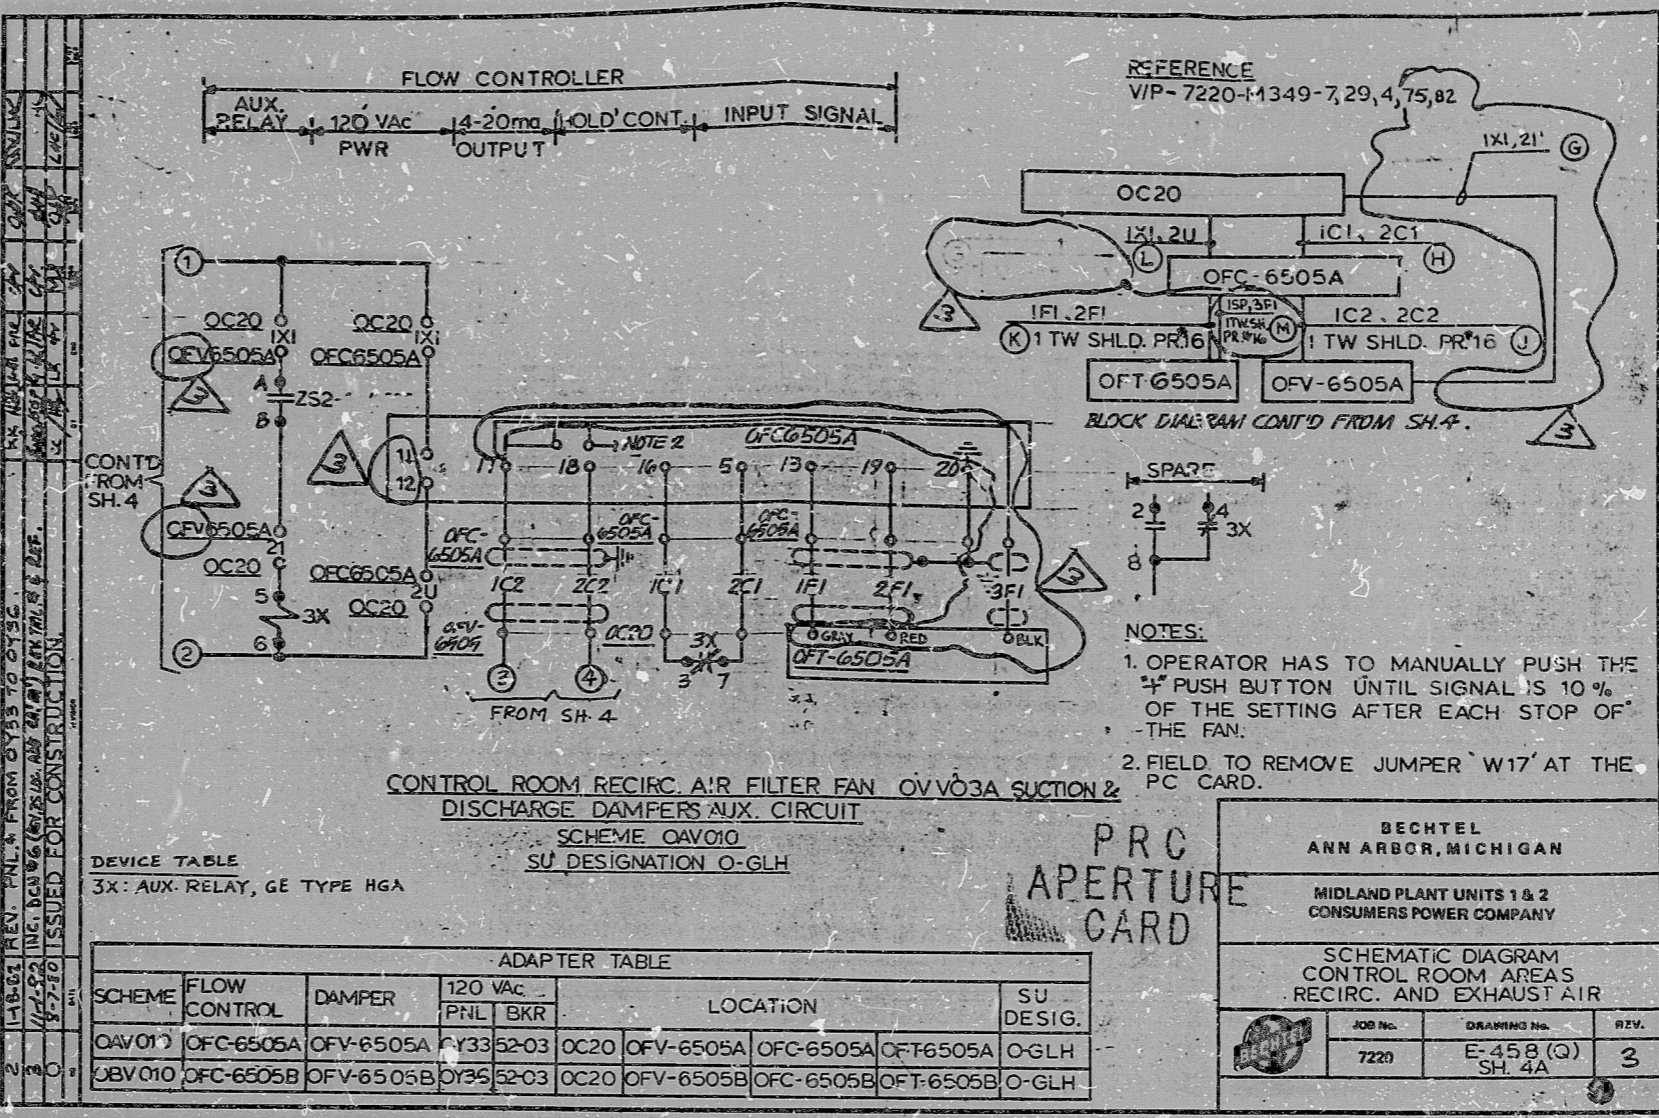

DEVICE TABLE  
3X - AUX. RELAY, GE TYPE HGA

ADAPTER TABLE

| SCHEME | FLOW CONTROL | DAMPER    | 120 VAC |       | LOCATION                           | SU DESIGN. |
|--------|--------------|-----------|---------|-------|------------------------------------|------------|
|        |              |           | PNL     | BKR   |                                    |            |
| OAV017 | OFC-6505A    | OFV-6505A | FY33    | 52-03 | OC20 OFV-6505A OFC-6505A OFT-6505A | O-GLH      |
| UBV010 | OFC-6505B    | OFV-6505B | DY35    | 52-03 | OC20 OFV-6505B OFC-6505B OFT-6505B | O-GLH      |

PRC APERTURE CARD

BECHTEL  
ANN ARBOR, MICHIGAN

MIDLAND PLANT UNITS 1 & 2  
CONSUMERS POWER COMPANY

SCHEMATIC DIAGRAM  
CONTROL ROOM AREAS  
RECIRC. AND EXHAUST AIR

|         |                      |      |
|---------|----------------------|------|
| JOB No. | DRAWING No.          | REV. |
| 7220    | E-45 B (Q)<br>SH. 4A | 3    |



RIDS

8302090282

