


The drawing and the design it covers are the property of BECHTEL. They are hereby loaned and on the borrower's express agreement that they will not be reproduced, copied, altered, exhibited, or used except in the limited way and under the conditions permitted by the written consent given by the lender or the borrower.

1	11-1-72	REVISED FROM IE TO IAH-1E (RISE CAT. COORD. 4-55)	BY: K.E. FISHER
2	11-1-72	INC. NEW WT (ECCAS) CONTROL	BY: K.E. FISHER
3	11-6-78	ISSUED FOR CONSTRUCTION	BY: J. H. ...

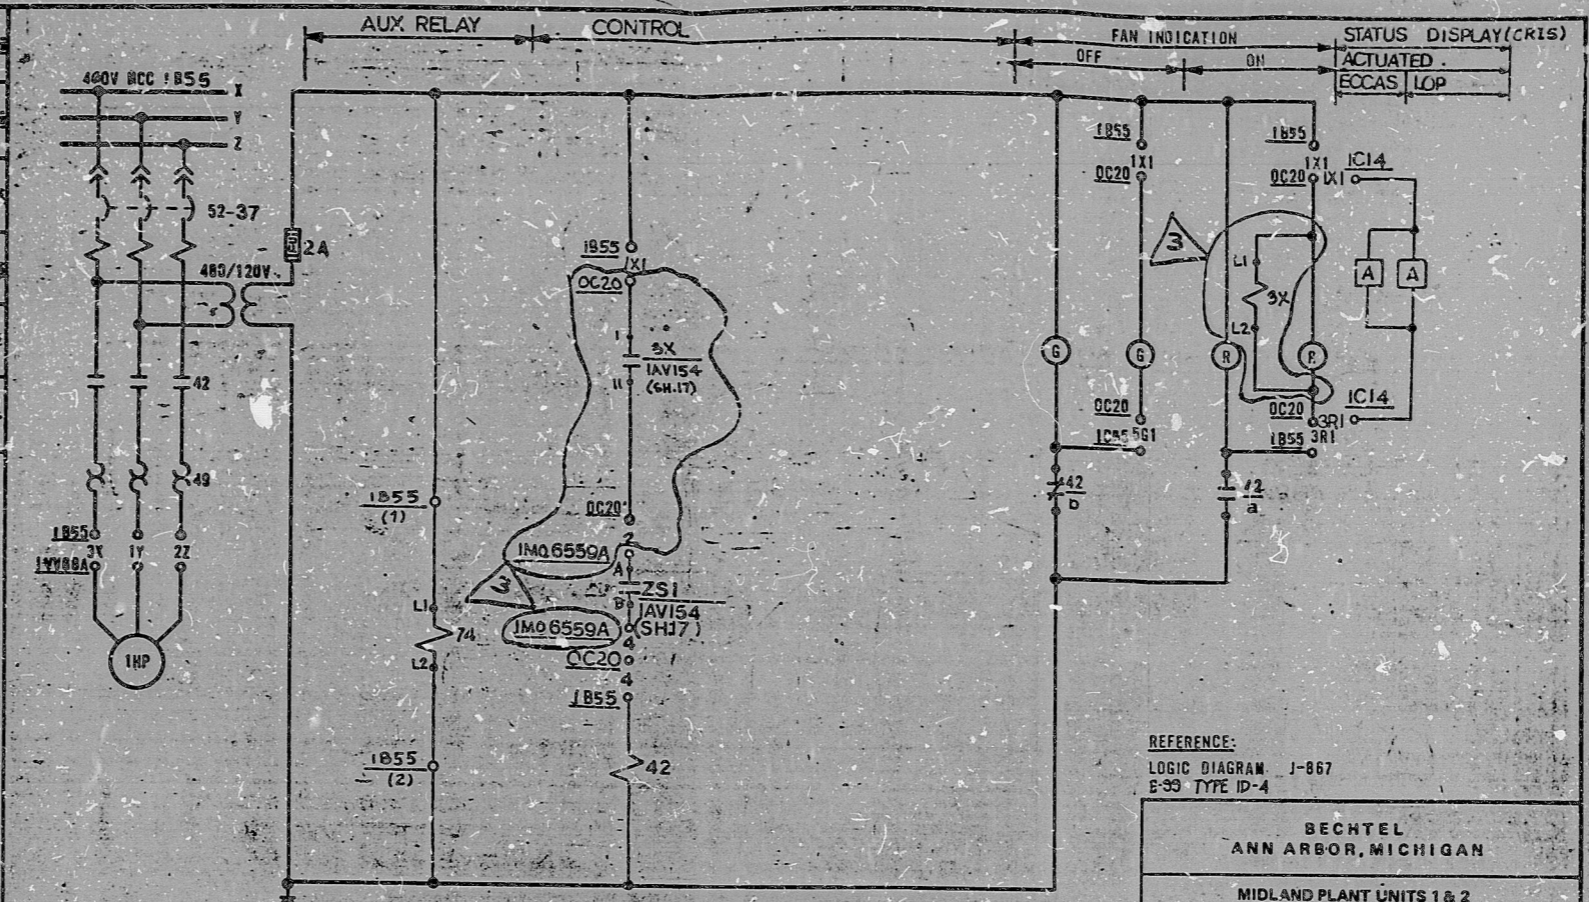

DEVICE TABLE

74:	PWR AVAILABLE AUX RELAY (ITE-2190E22AA)
3X:	AUX. RELAY (ITE-VZTS0ET1AA)

BATTERY ROOM EXHAUST FAN IVV-68A  
 SCHEME: IAB537  
 SU. DESIG. O-CLJ

PRC  
 APERTURE  
 CARD

REFERENCE:  
 LOGIC DIAGRAM J-867  
 E-53 TYPE ID-4

BECHTEL ANN ARBOR, MICHIGAN		
MIDLAND PLANT UNITS 1 & 2 CONSUMERS POWER COMPANY		
SCHEMATIC DIAGRAM CONTROL ROOM AREAS RECIRC & EXHAUST AIR		
JOB No.	DRAWING No.	REV.
7220	E-458(D) SH 14	3

17"  
11"  
8.5"  
8.5"  
11"  
17"

17"  
11"  
8.5"  
8.5"  
11"  
17"

RIDS

8302090293

