


This drawing and the design it covers are the property of BECHTEL. They are hereby loaned and on the borrower's express agreement that they will not be reproduced, copied, loaned, exhibited, or used except in the limited way and extent as permitted by any written consent given by the lender to the borrower.

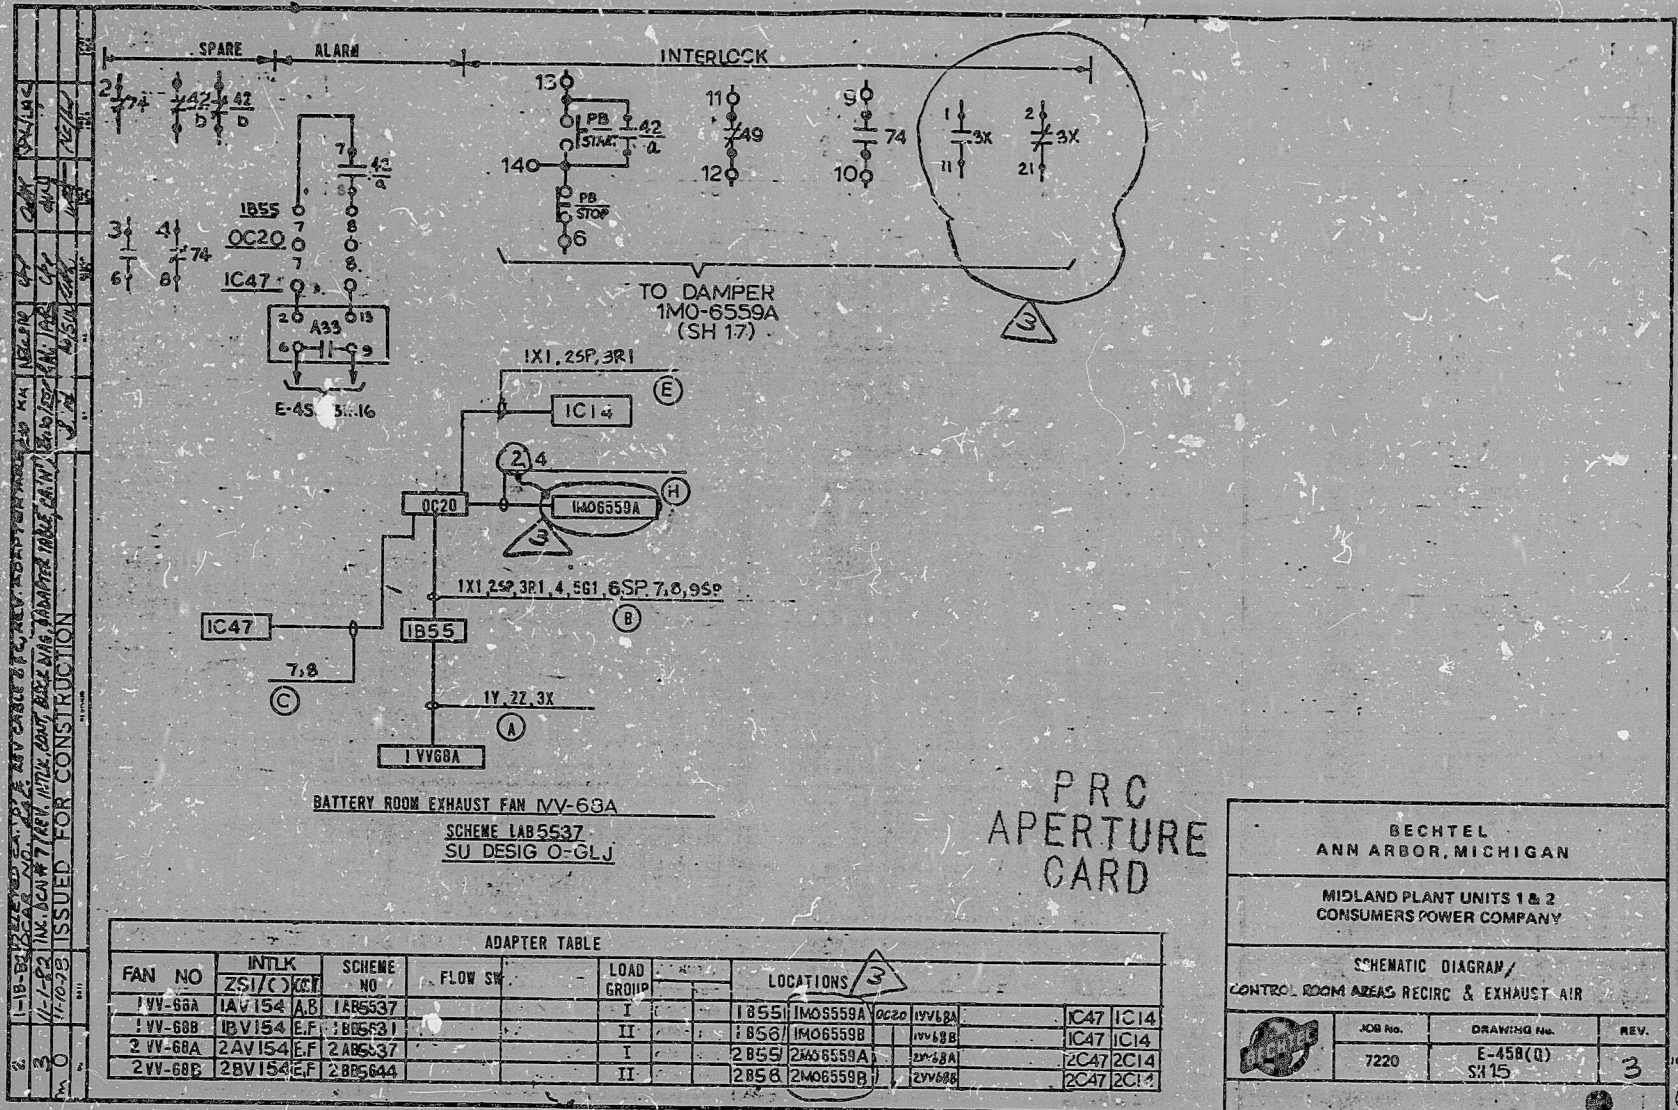

ADAPTER TABLE						
FAN NO	INTLK	SCHEME NO	FLOW SW	LOAD GROUP	LOCATIONS	
1 VV-68A	1AV154 AB	1AB5537		I	1B55	1M06559A OC20 1V68A
1 VV-68B	1BV154 EF	1B06531		II	1B56	1M06559B 1V68B
2 VV-68A	2AV154 EF	2AB5537		I	2B55	2M06559A 2V68A
2 VV-68B	2BV154 EF	2B06544		II	2B56	2M06559B 2V68B

BECHTEL ANN ARBOR, MICHIGAN		
MIDLAND PLANT UNITS 1 & 2 CONSUMERS POWER COMPANY		
SCHEMATIC DIAGRAM/ CONTROL ROOM AREAS RECIRC & EXHAUST AIR		
JOB No. 7220	DRAWING No. E-45B(D) S415	REV. 3

17"

11"

8.5"

8.5"

11"

17"

17"

11"

8.5"

8.5"

11"

17"



RIDS

8302090296

