

17

11

8.5

8.5

11

17

17

11


8.5

8.5

11

17

This drawing and the design it covers are the property of BECHTEL. They are hereby loaned and on the borrower's express agreement that they will not be reproduced, copied, loaned, exhibited, or used except in the limited way and private use permitted by the lender to the borrower.

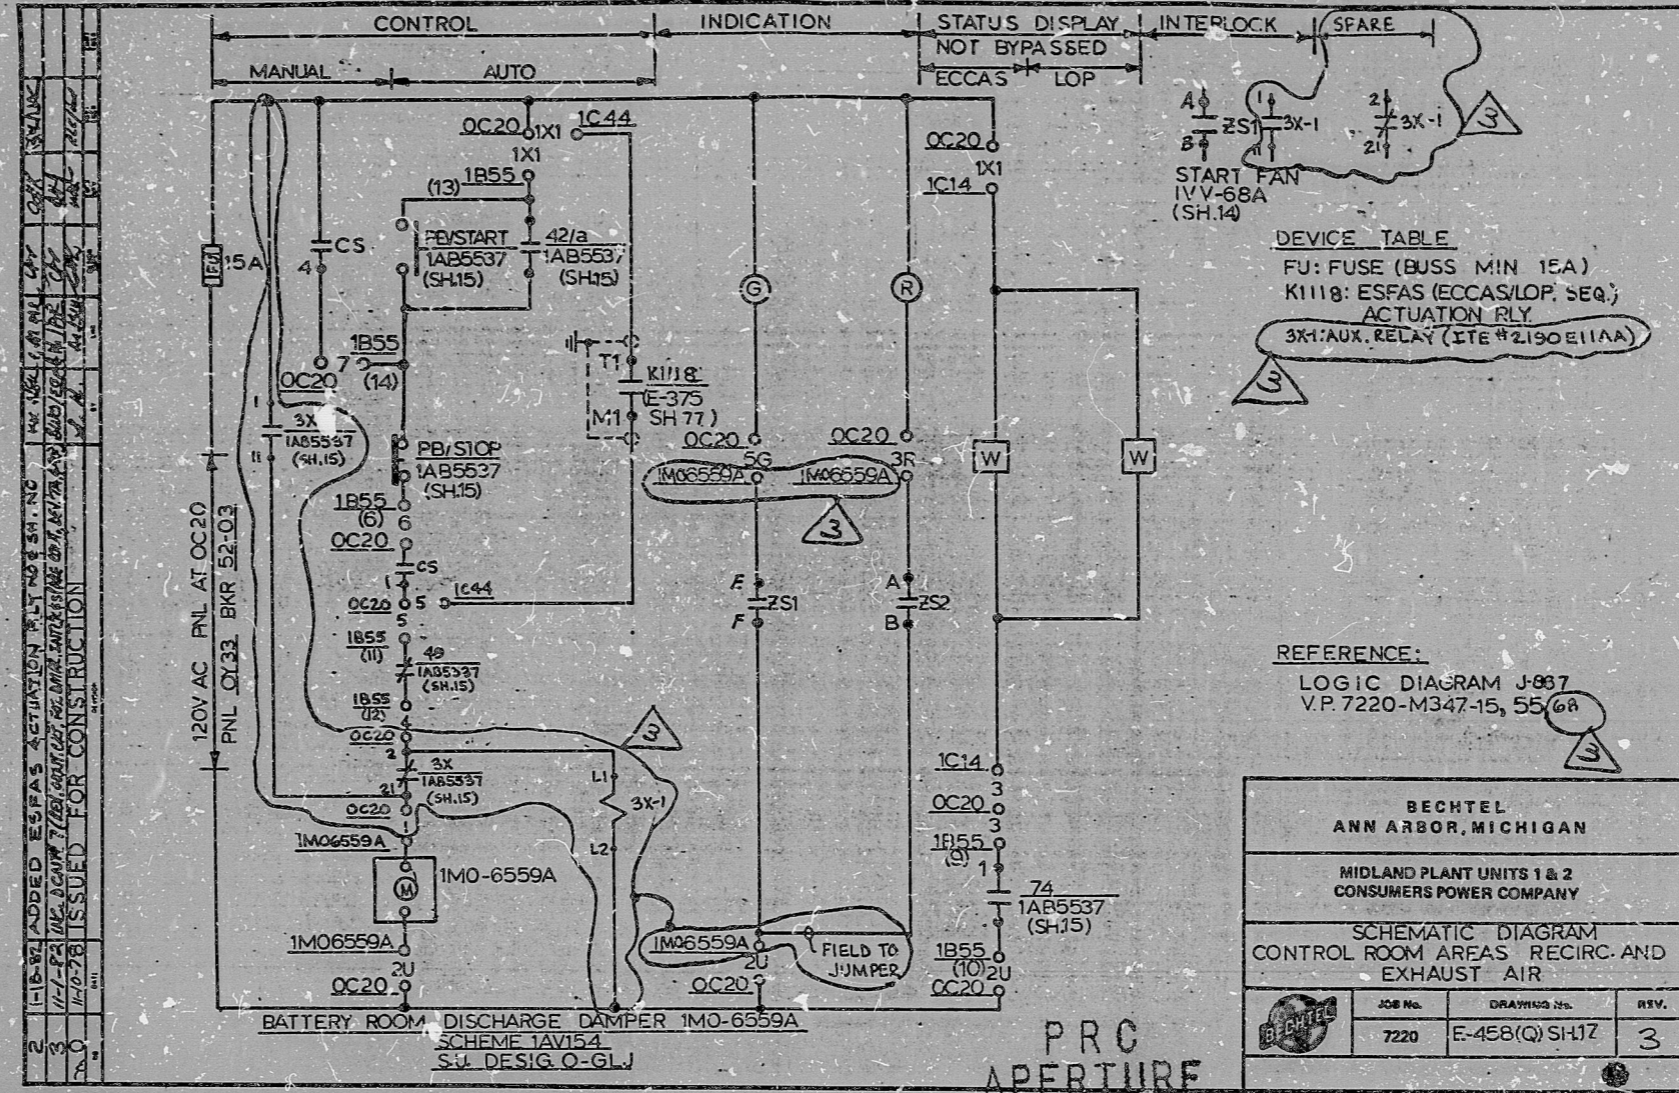

BATTERY ROOM DISCHARGE DAMPER 1M0-6559A
 SCHEME 1A154
 S.V. DESIG. O-GLJ

DEVICE TABLE

FU: FUSE (BUSS MIN 15A)
 K1118: ESFAS (ECCAS/LOP, SEQ.)
 ACTUATION RLY
 3X1: AUX. RELAY (ITE #2190E11AA)

REFERENCE:
 LOGIC DIAGRAM J-837
 V.P. 7220-M347-15, 55/6A

BECHTEL ANN ARBOR, MICHIGAN		
MIDLAND PLANT UNITS 1 & 2 CONSUMERS POWER COMPANY		
SCHEMATIC DIAGRAM CONTROL ROOM AREAS RECIRC. AND EXHAUST AIR		
JOB No.	DRAWING No.	REV.
7220	E-458(Q) SH17	3

PRC
 APERTURE
 CARD

RIDS

8302090298

