

17"


11"

8.5"

17"

11"

8.5"

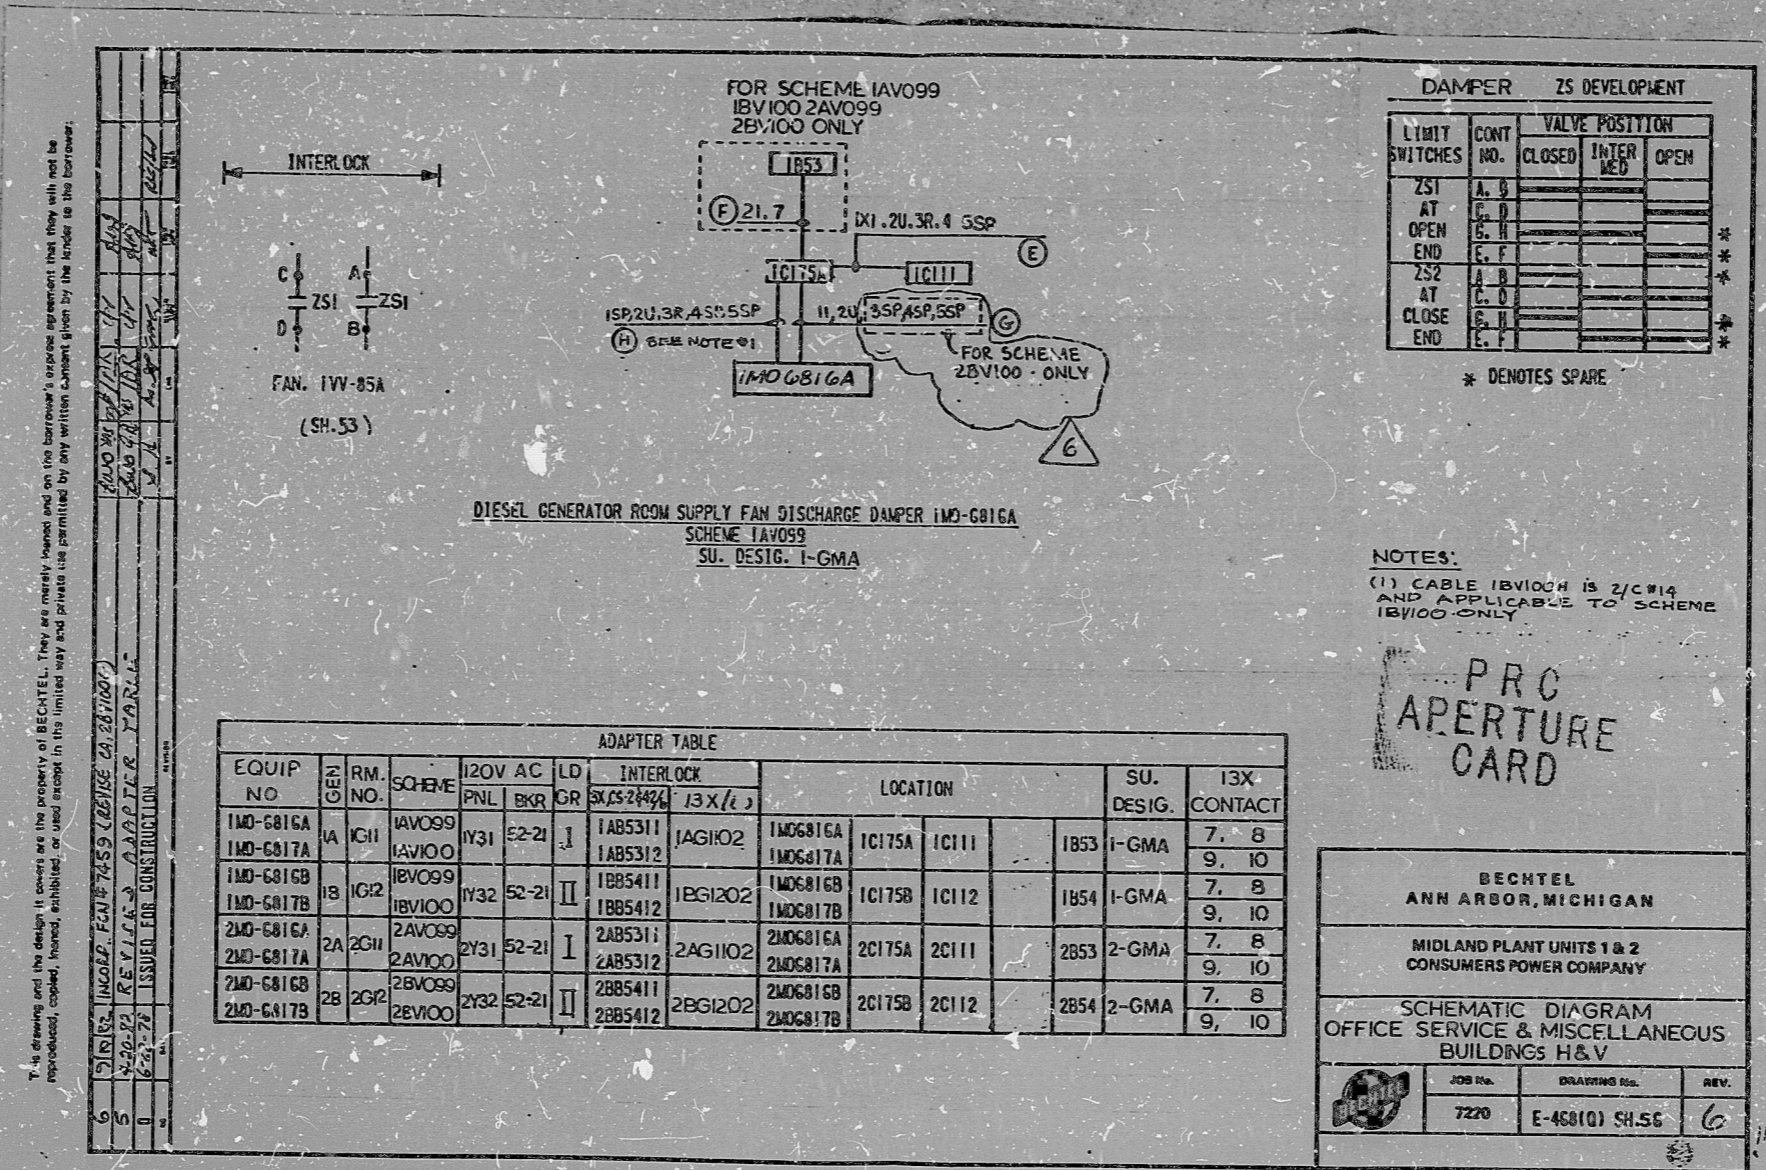

This drawing and the design it covers are the property of BECHTEL. They are merely loaned and on the borrower's expense agreement that they will not be reproduced, copied, loaned, exhibited, or used except in the limited way and under the conditions permitted by any written consent given by the lender to the borrower.



I certify that the image contained on this frame was made in the normal and regular course of business, on the date stated below and that it is an accurate reproduction of the document submitted to the contractor for filing, by Bechtel Power Corporation.

7-20-82 C. Weston
DATE CAMERA OPERATOR CONTRACTOR'S SUP'V. OR MANAGER

16X

8.5"

11"

17"

8.5"

11"

17"

RIDS

8302090317

