

17"

11"

8.5"

8.5"

11"

17"

17"

11"

8.5"

8.5"

11"

17"

This drawing and the design it covers are the property of BECHTEL. They are hereby loaned and on the borrower's express agreement that they will not be reproduced, copied, loaned, exhibited, or used except in the limited way and private use permitted by any written consent given by the lender to the borrower.

REV.	DATE	BY	CHKD.	DESCRIPTION
1	11/17/75	ISSUED FOR CONSTRUCTION
2	REV. AUX. RELAY TAG NO. IDENTIFIABLE (UNCLAR. DCM P. 7)
3	REV. REFERENCE DNG. NO. & WISE. NO.
4	REV. REFERENCE DNG. NO. & WISE. NO.

DEVICE TABLE:


OLYLL-4916; TANK LEVEL LOW-LOW INTLK RELAY

EU; FUSE (AMP TRAP A6Y2-2)

3X-1; AUXILIARY RELAY (SEE CAT. NO. 2190 E22AA)

PRIMARY WATER TRANSFER PUMP OP-54A
 SCHEME ONB4802
 SU DESIG OBLA

PRC APERTURE CARD

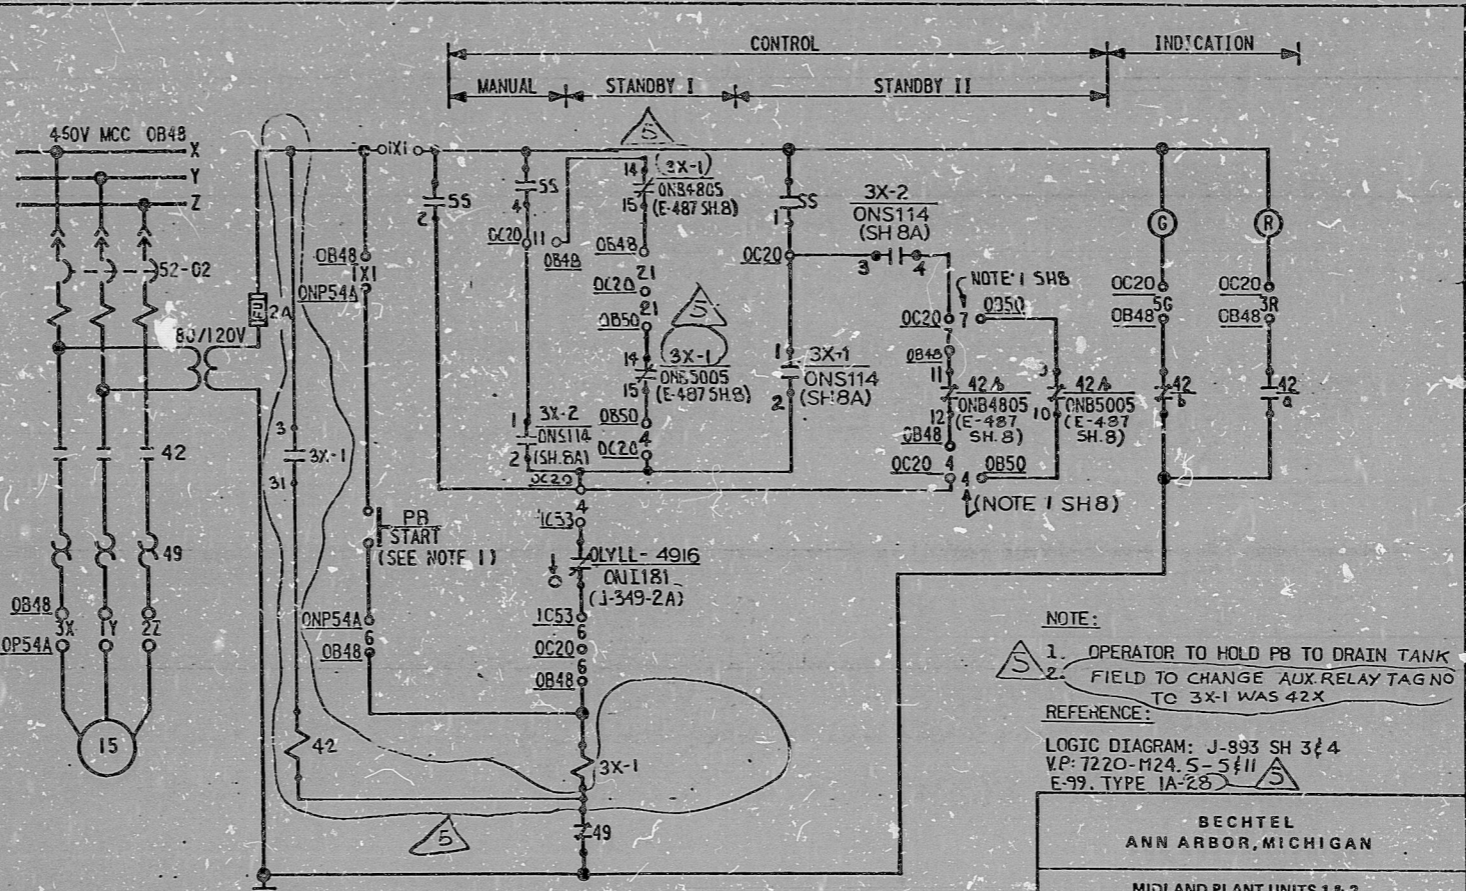

NOTE:
 1. OPERATOR TO HOLD PB TO DRAIN TANK FIELD TO CHANGE AUX RELAY TAG NO TO 3X-1 WAS 42X

REFERENCE:
 LOGIC DIAGRAM: J-993 SH 3 & 4
 V.P: 7220-M24.5-5 & II
 E-99. TYPE IA-28

BECHTEL ANN ARBOR, MICHIGAN		
MIDLAND PLANT UNITS 1 & 2 CONSUMERS POWER COMPANY		
SCHEMATIC DIAGRAM PLANT WATER STORAGE AND TRANSFER SYSTEM		
JOB No.	DRAWING No.	REV.
7220	E-487(Q)SH.7	5

I certify that the image contained on this frame was made in the normal and regular course of business, on the date stated below and that it is an accurate reproduction of the document submitted to reprographics.

RIDS

8302090358

