

17"

11"

8.5"


8.5"

11"

17"

This drawing and the design it covers are the property of BECHTEL. They are hereby loaned and on the borrower's express agreement that they will not be reproduced, copied, loaned, exhibited, or used except in the limited way and private use permitted by any written consent given by the lender to the borrower.

REV	NO	DATE	BY	CHKD	DESCRIPTION
1	0				ISSUED FOR CONSTRUCTION
2	1	12/15/79	MS	MS	REVISED REFERENCE
3	2	12/15/79	MS	MS	ADDED AUX. RELAY 3X-1 REV. DEVIS TABLE (MGRAR DON 7)
4	3	12/15/79	MS	MS	REVISED REFERENCE

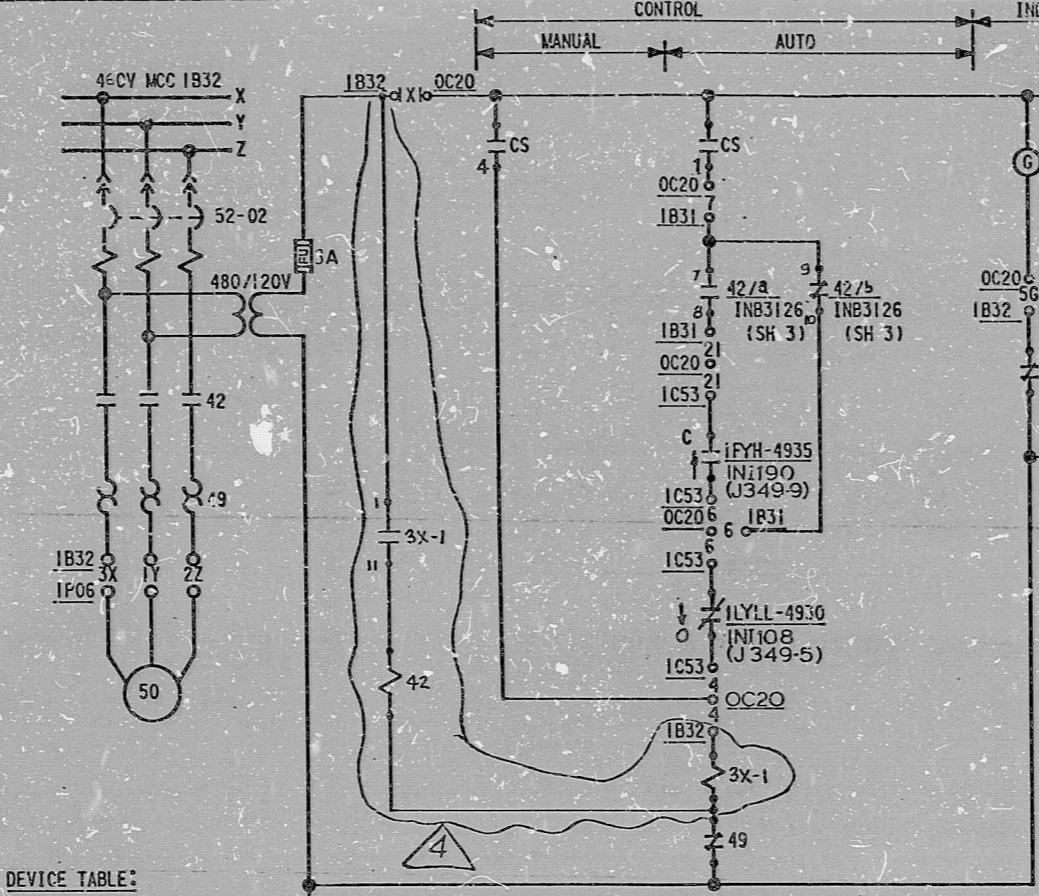

- DEVICE TABLE:
1. 1FYH-4935, HIGH FLOW INTLK RLY.
 2. 1LYLL-4930, TANK LOW-LOW LEVEL INTLK RLY.
 3. FU: FUSE (AMP TRAP) (AEY3-2)
 4. 3X-1: INTERPOSING RELAY
ITS CAT NO. JCB2012

CONDENSATE TRANSFER PUMP 1P-06
SCHEM 1NB3202
SU. DESIG. J-APB

PRC APERTURE CARD

NOTE
OPERATOR TO HOLD CS ON "START" TO DRAIN TANK

REFERENCE:
LOGIC DIAGRAM, J-893 SH5
VF: 7220-M24.1-6#12
E99, TYPE IA-23

BECHTEL ANN ARBOR, MICHIGAN		
MIDLAND PLANT UNITS 1 & 2 CONSUMERS POWER COMPANY		
SCHEMATIC DIAGRAM PLANT WATER STORAGE AND TRANSFER SYSTEM		
JOB No.	DRAWING No.	REV.
7220	E-487 (Q) SH 9	4

I certify that the image contained on this frame was made in the normal and regular course of business, on the date stated below and that it is an accurate reproduction of the document submitted to reprographics.

17"

11"

8.5"

8.5"

11"

17"

RIDS

8302090362

