


17"
11"
8.5"
8.5"
11"
17"

This drawing and the design it covers are the property of BECHTEL. They are hereby loaned and on the borrower's express agreement that they will not be reproduced, copied, loaned, exhibited, or used except in the limited way and under the conditions permitted by any written consent given by the lender to the borrower.

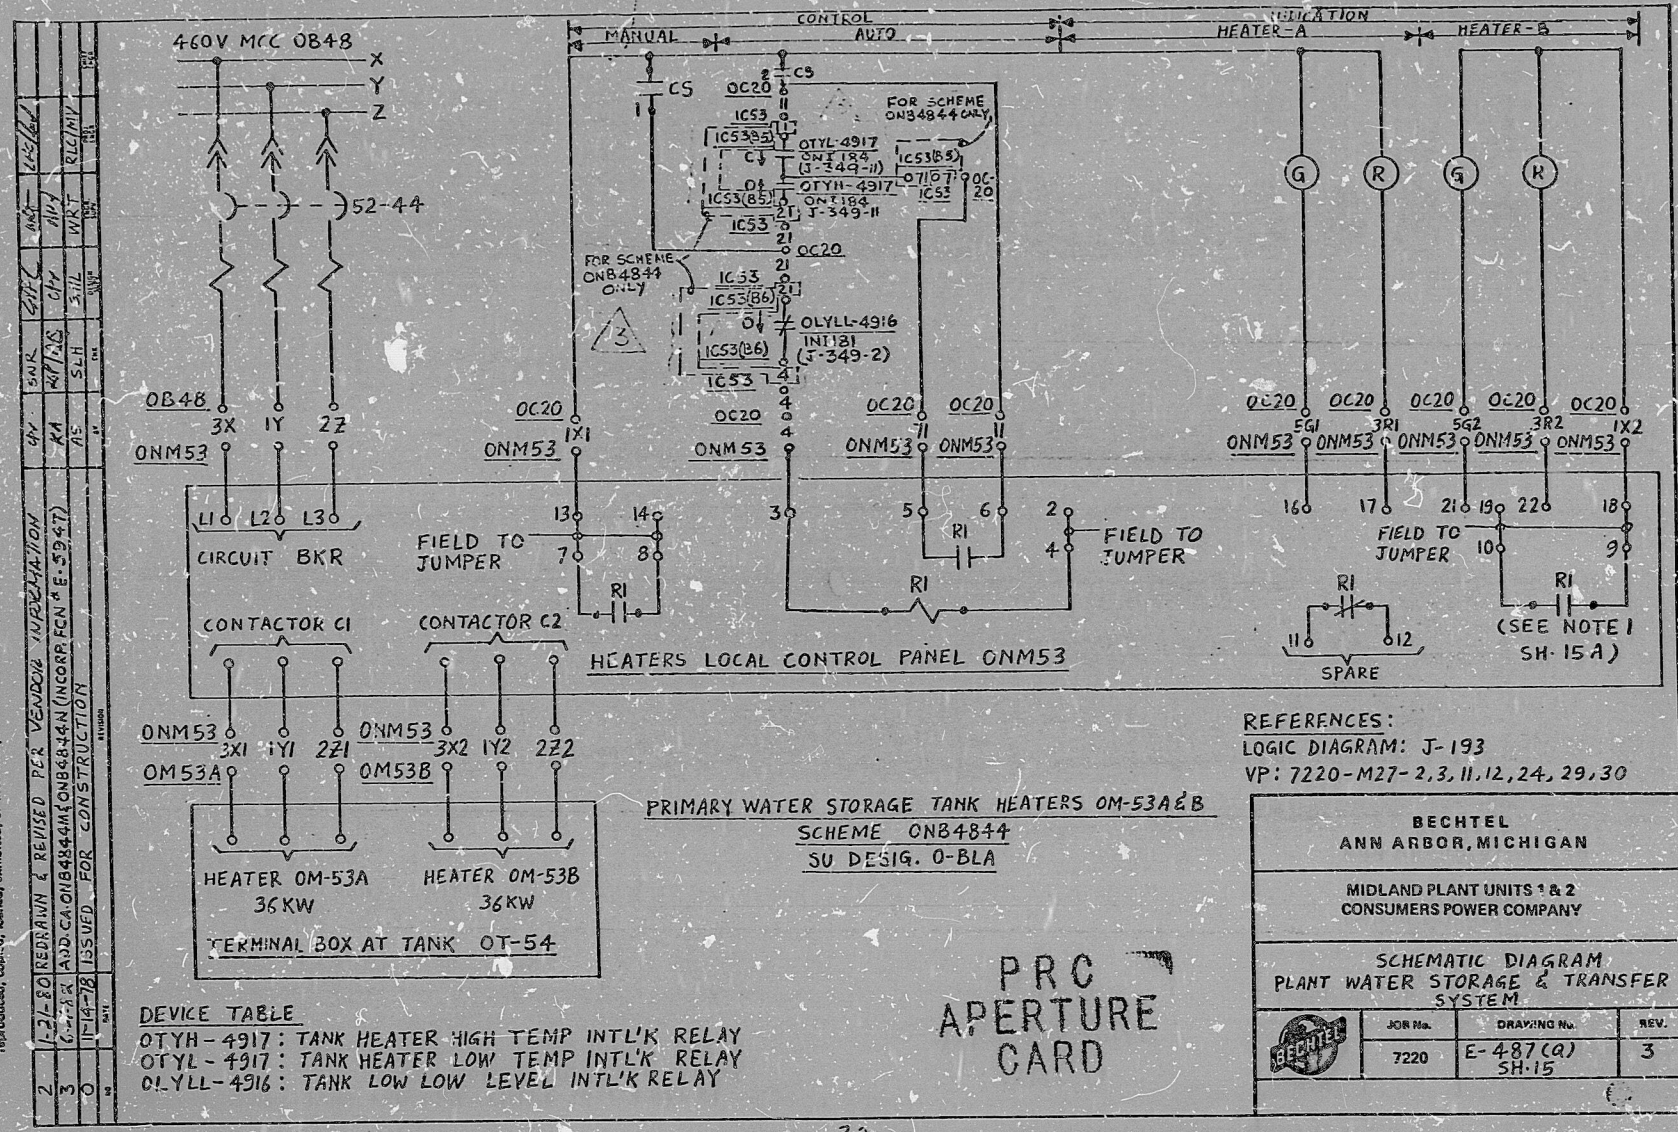

DEVICE TABLE

1	OTYH-4917	TANK HEATER HIGH TEMP INT'L'K RELAY
2	OTYL-4917	TANK HEATER LOW TEMP INT'L'K RELAY
3	OLYLL-4916	TANK LOW LOW LEVEL INT'L'K RELAY

I certify that the image contained on this frame was made in the normal and regular course of business, on the date stated below and that it is an accurate reproduction of the document submitted to reprographics.

17"
11"
8.5"
8.5"
11"
17"

RIDS

8302090367

