


17"
11"
8.5"
9.5"
11"
17"

17"
11"
8.5"
9.5"
11"
17"

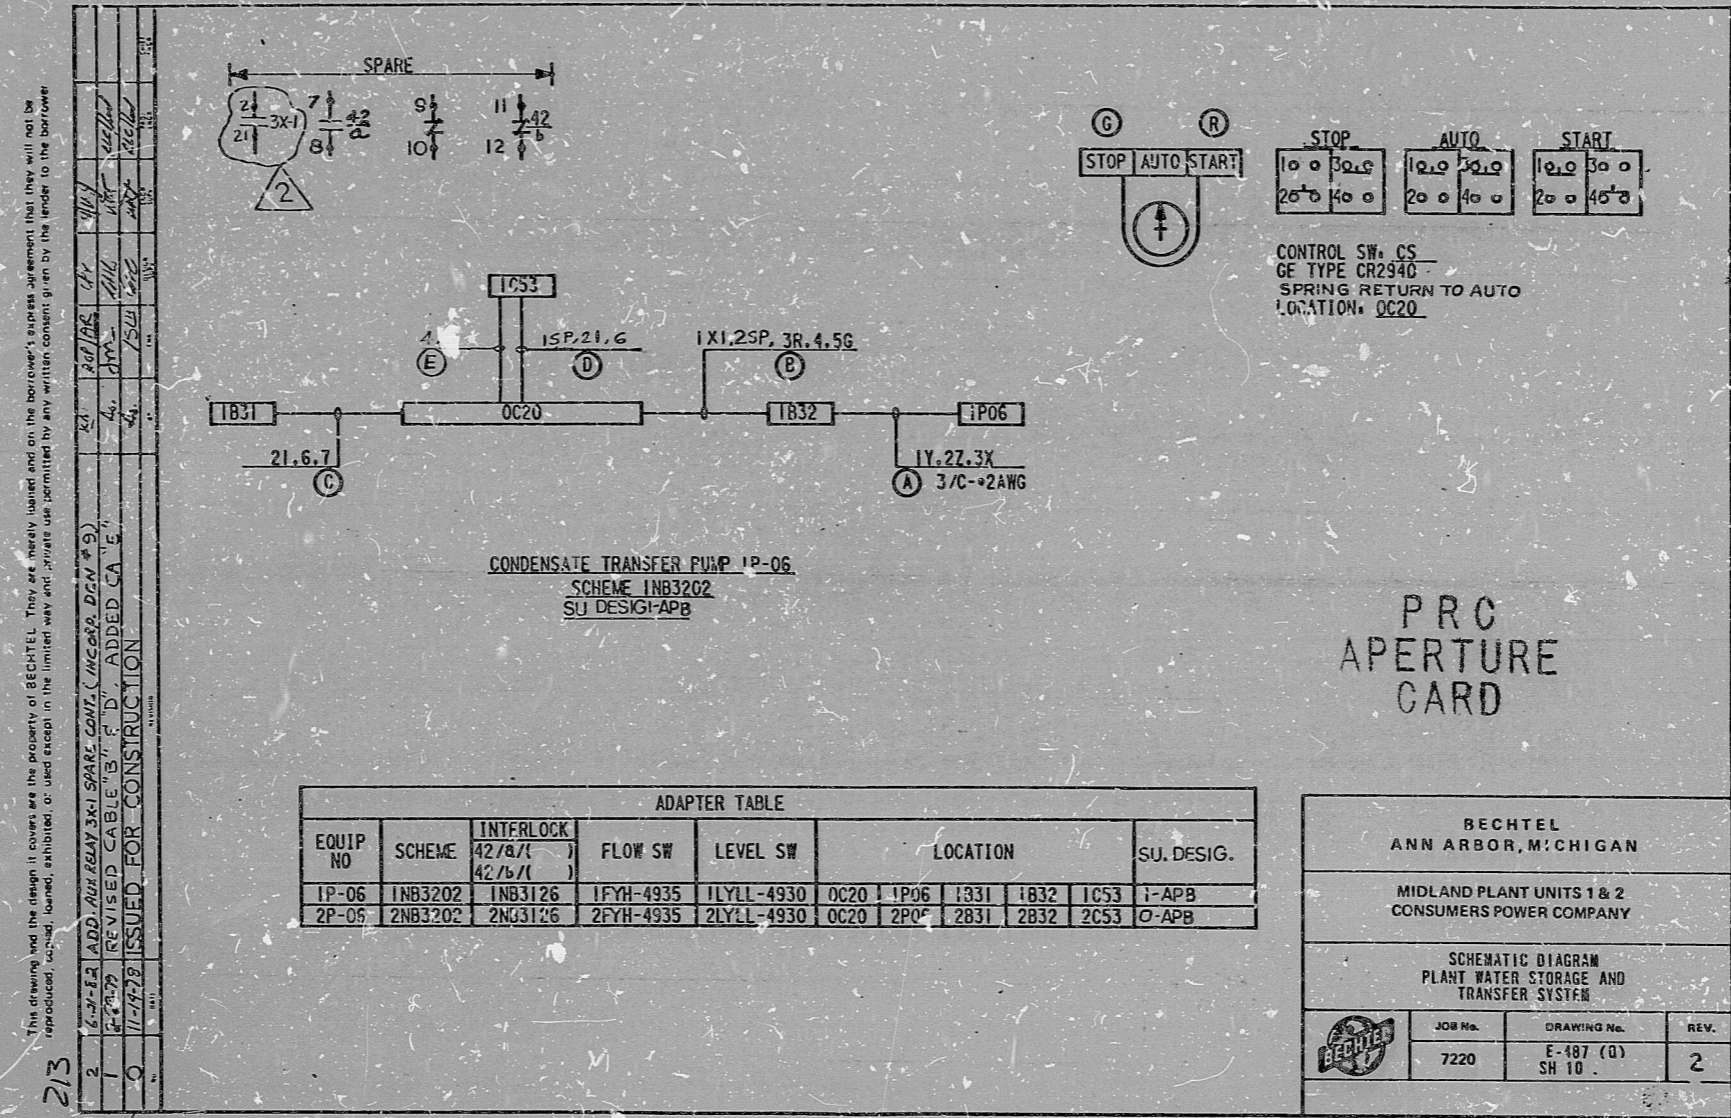

This drawing and the design it covers are the property of BECHTEL. They are hereby loaned and on the borrower's express agreement that they will not be reproduced, copied, loaned, exhibited or used except in the limited way and for the purpose intended by the lender to the borrower.

ADAPTER TABLE										
EQUIP NO	SCHEME	INTFRLOCK	FLOW SW	LEVEL SW	LOCATION					SU. DESIG.
1P-06	1NB3202	1NB3126	1FYH-4935	1LYLL-4930	OC20	1P06	1B31	1B32	1C53	1-APB
2P-06	2NB3202	2NB3126	2FYH-4935	2LYLL-4930	OC20	2P06	2B31	2B32	2C53	2-APB

BECHTEL
ANN ARBOR, MICHIGAN

MIDLAND PLANT UNITS 1 & 2
CONSUMERS POWER COMPANY

SCHEMATIC DIAGRAM
PLANT WATER STORAGE AND
TRANSFER SYSTEM

JOB No.	DRAWING No.	REV.
7220	E-487 (0) SH 10	2

I certify that the image contained on this frame was made in the normal and regular course of business, on the date stated below and that it is an accurate reproduction of the document submitted to reprographics.

RIDS

8392090370

