
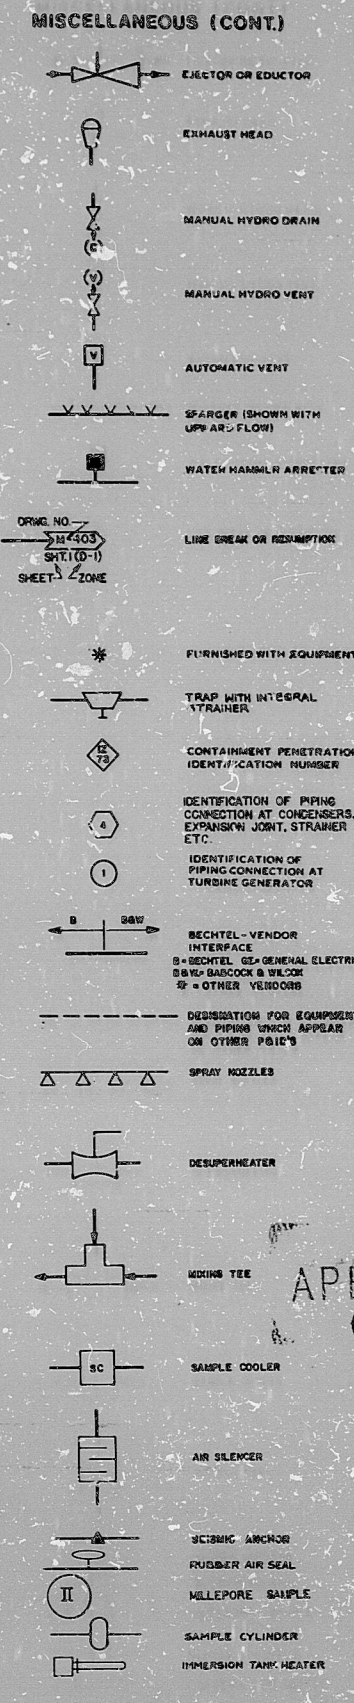
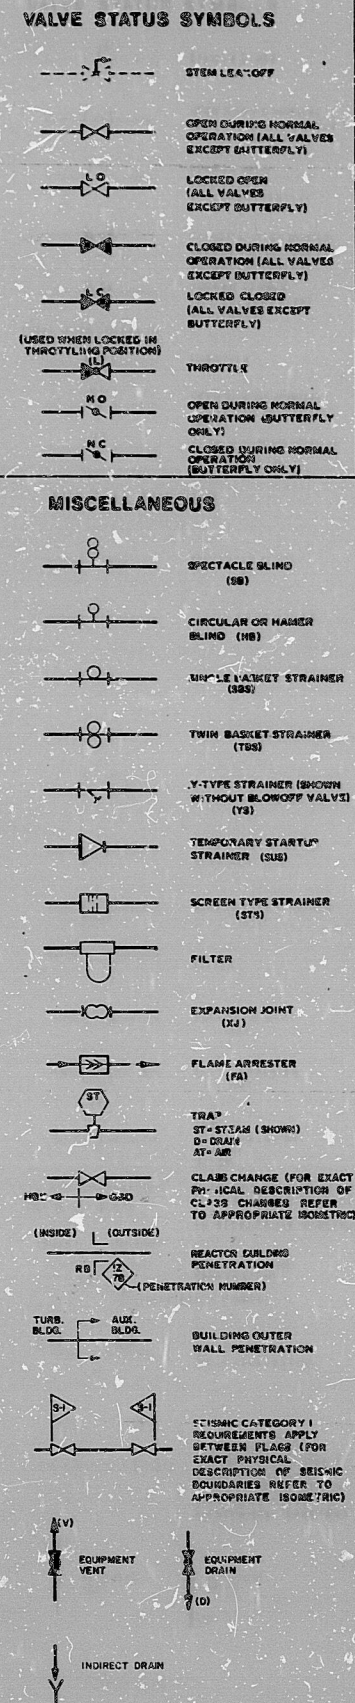
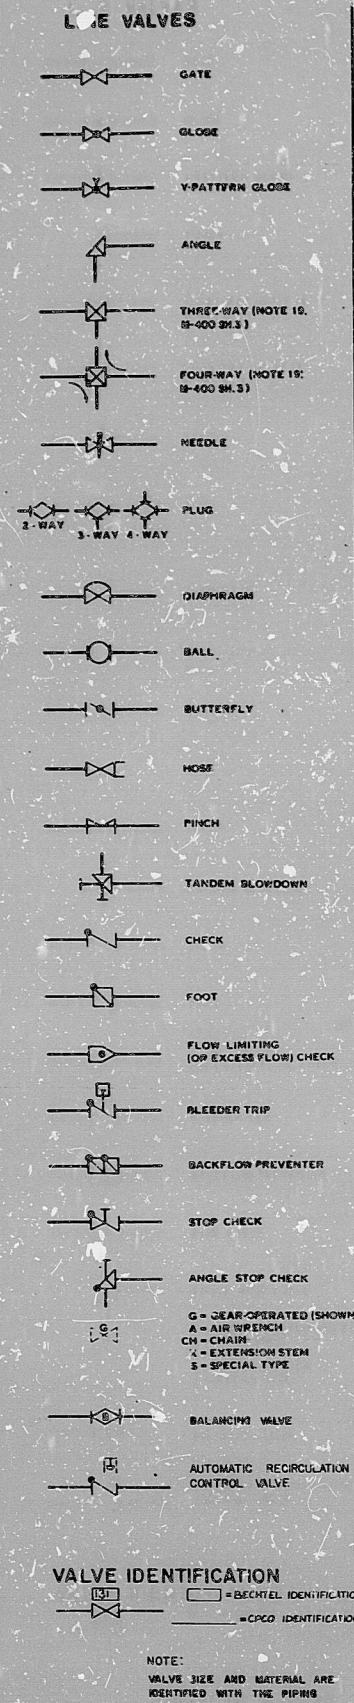
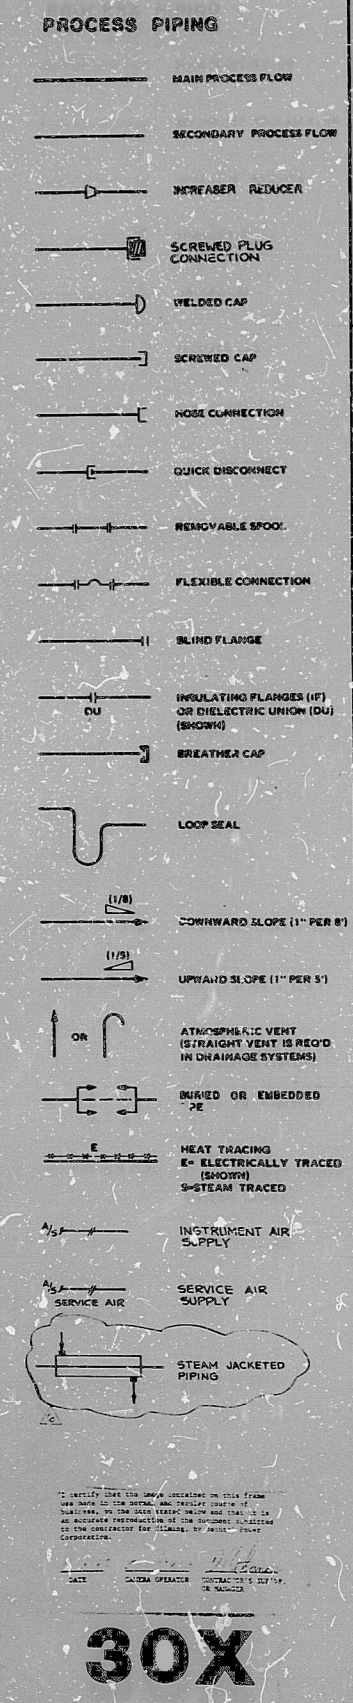


M-400 SH.2

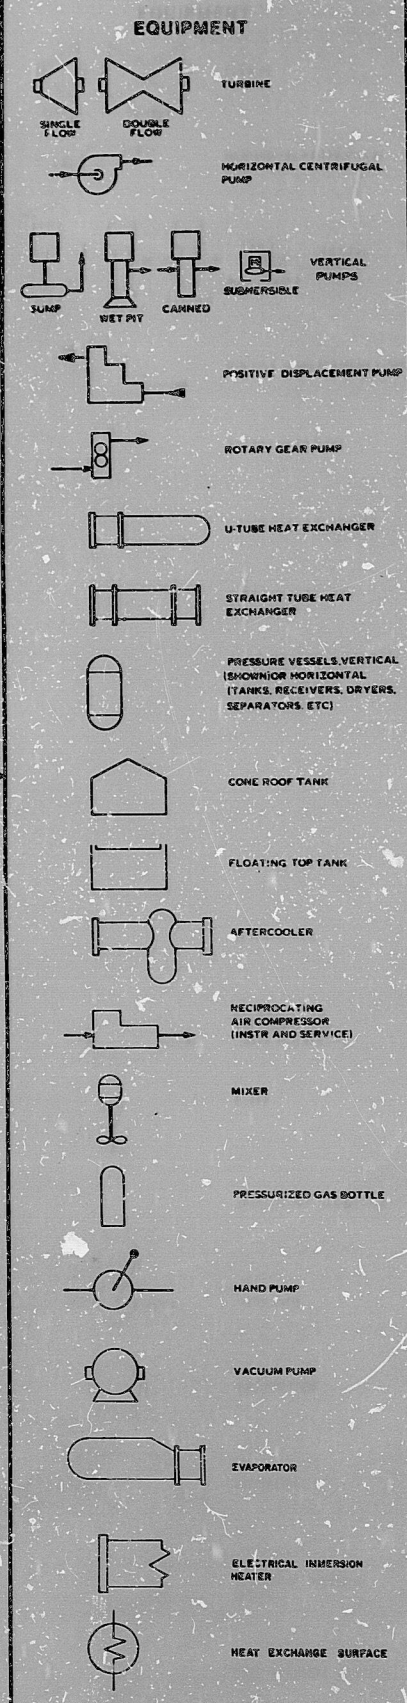

PIPING IDENTIFICATION

PIPE AND VALVE CLASSES ARE DESIGNATED BY THREE LETTER CODES. THE FIRST LETTER INDICATES THE PRIMARY VALVE OR FLANGE RATING, THE SECOND LETTER THE TYPE OF MATERIAL AND THE THIRD LETTER THE CODE TO WHICH THE PIPING IS DESIGNATED (AS FOLLOWS):

FIRST LETTER - PRIMARY PRESSURE RATING (UNLESS OTHERWISE NOTED, ALL RATINGS ARE IN ACCORDANCE WITH ANSI B16.3)

SECOND LETTER - MATERIAL

THIRD LETTER - APPLICABLE CODES

NOTES:

- EQUIPMENT, VALVES, AND COMPONENTS ARE AT LEAST THE MINIMUM CODE CLASSIFICATION INDICATED (IE, SECTION 5 COMPONENT MAY BE USED IN A B 3 1/2 SYSTEM, ETC.). REVIEW OF VENDOR DRAWINGS MAY BE REQUIRED TO DETERMINE ACTUAL COMPONENT CLASSIFICATION.
- FOR USE BY SMALL PIPE GROUP ONLY IF REQUIRED, LINE NUMBER FOR EQUIPMENT INSTRUMENT CONNECTIONS UP TO THE ROOT VALVE SHALL BE IDENTICAL TO EITHER OF THE EQUIPMENT'S VENT OR DRAIN LINE NUMBER.

REVISED AS INDICATED ON REV. SHEET	REVISED AS INDICATED	REVISED AS INDICATED	REVISED AS INDICATED	REVISED AS INDICATED	REVISED AS INDICATED
1	2	3	4	5	6

BECHTEL
MIDLAND PLANT UNITS 1 & 2
CONSUMERS POWER COMPANY

LEGEND
PIPING AND INSTRUMENT DIAGRAM

JOB NO.	DATE	REV.
7220	M-400 SH.2	6

8.5" 11" 17"

8.5" 11" 17"

30X

PRC APERTURE CARD

DDAPID - Rev sheet encl

RIDS

8302090431

