


11
11
8.5
8.5
11
17

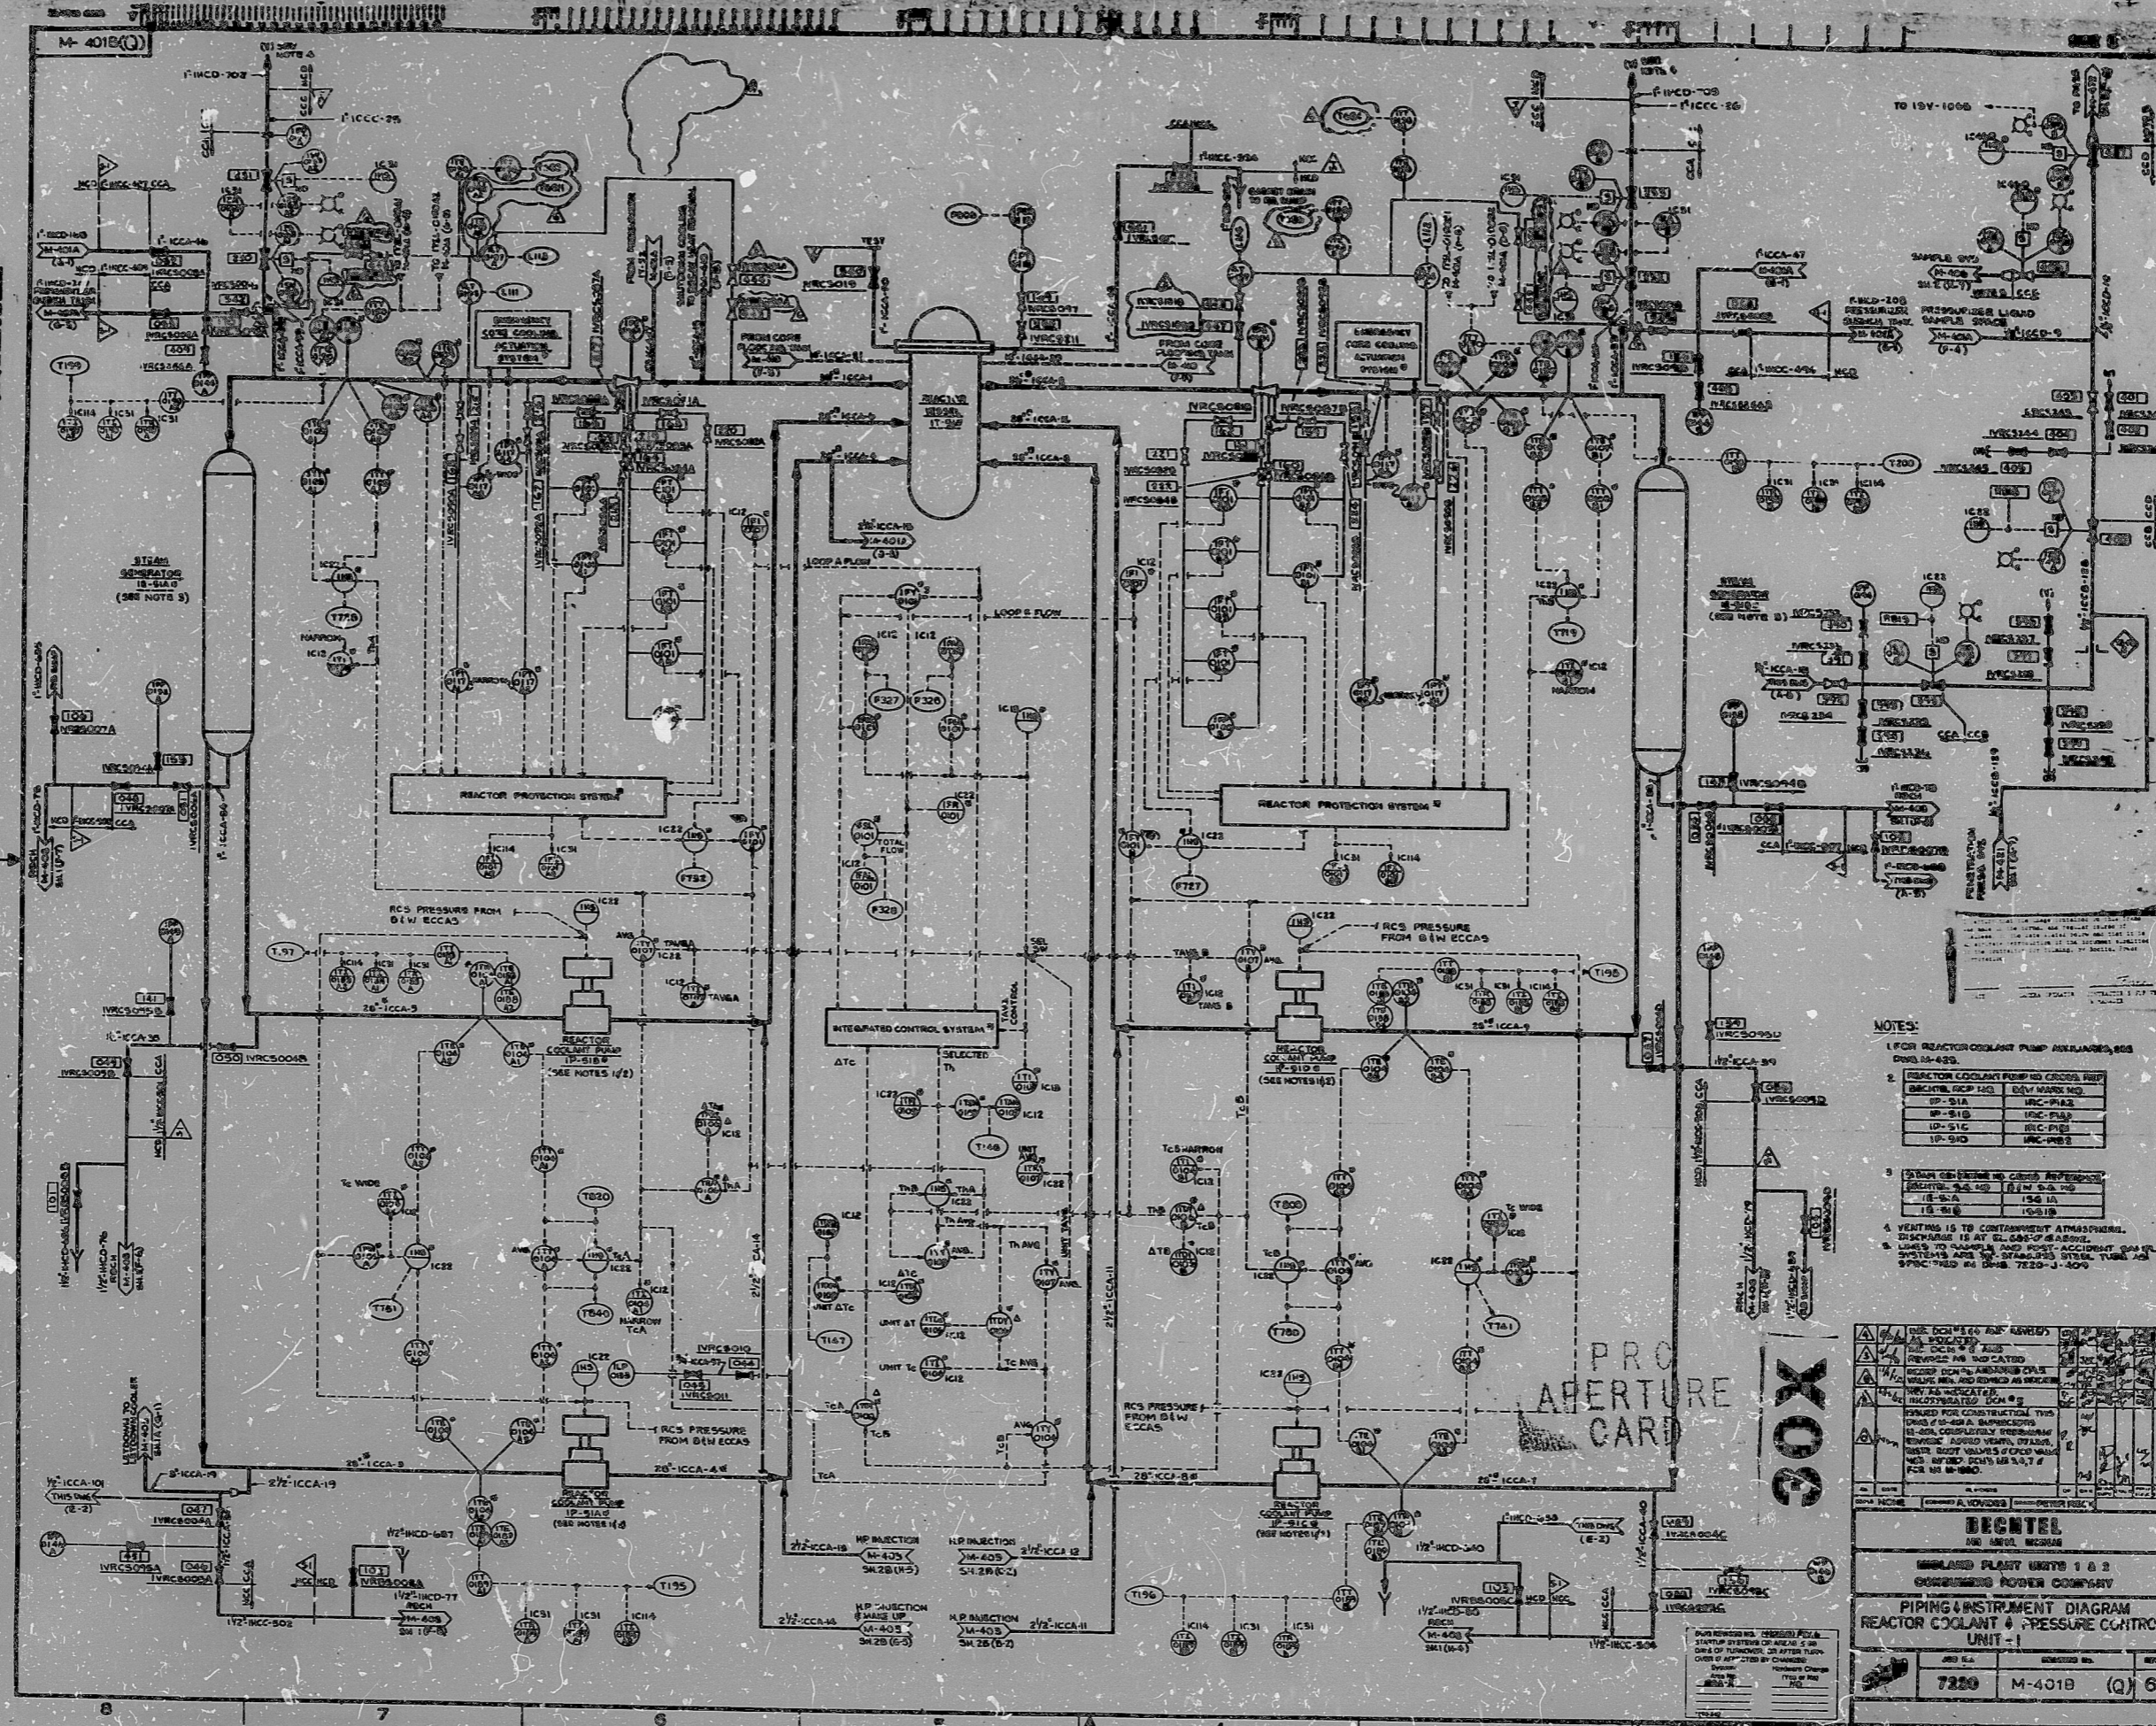

- NOTES:




PIPING & INSTRUMENT DIAGRAM
REACTOR COOLANT & PRESSURE CONTROL
UNIT-1

7220 M-401B (Q) 6

11
11
8.5
8.5
11
17

PRO
APERTURE
CARD

30X

RIDS

8302090436

