




RIDS

8109210137

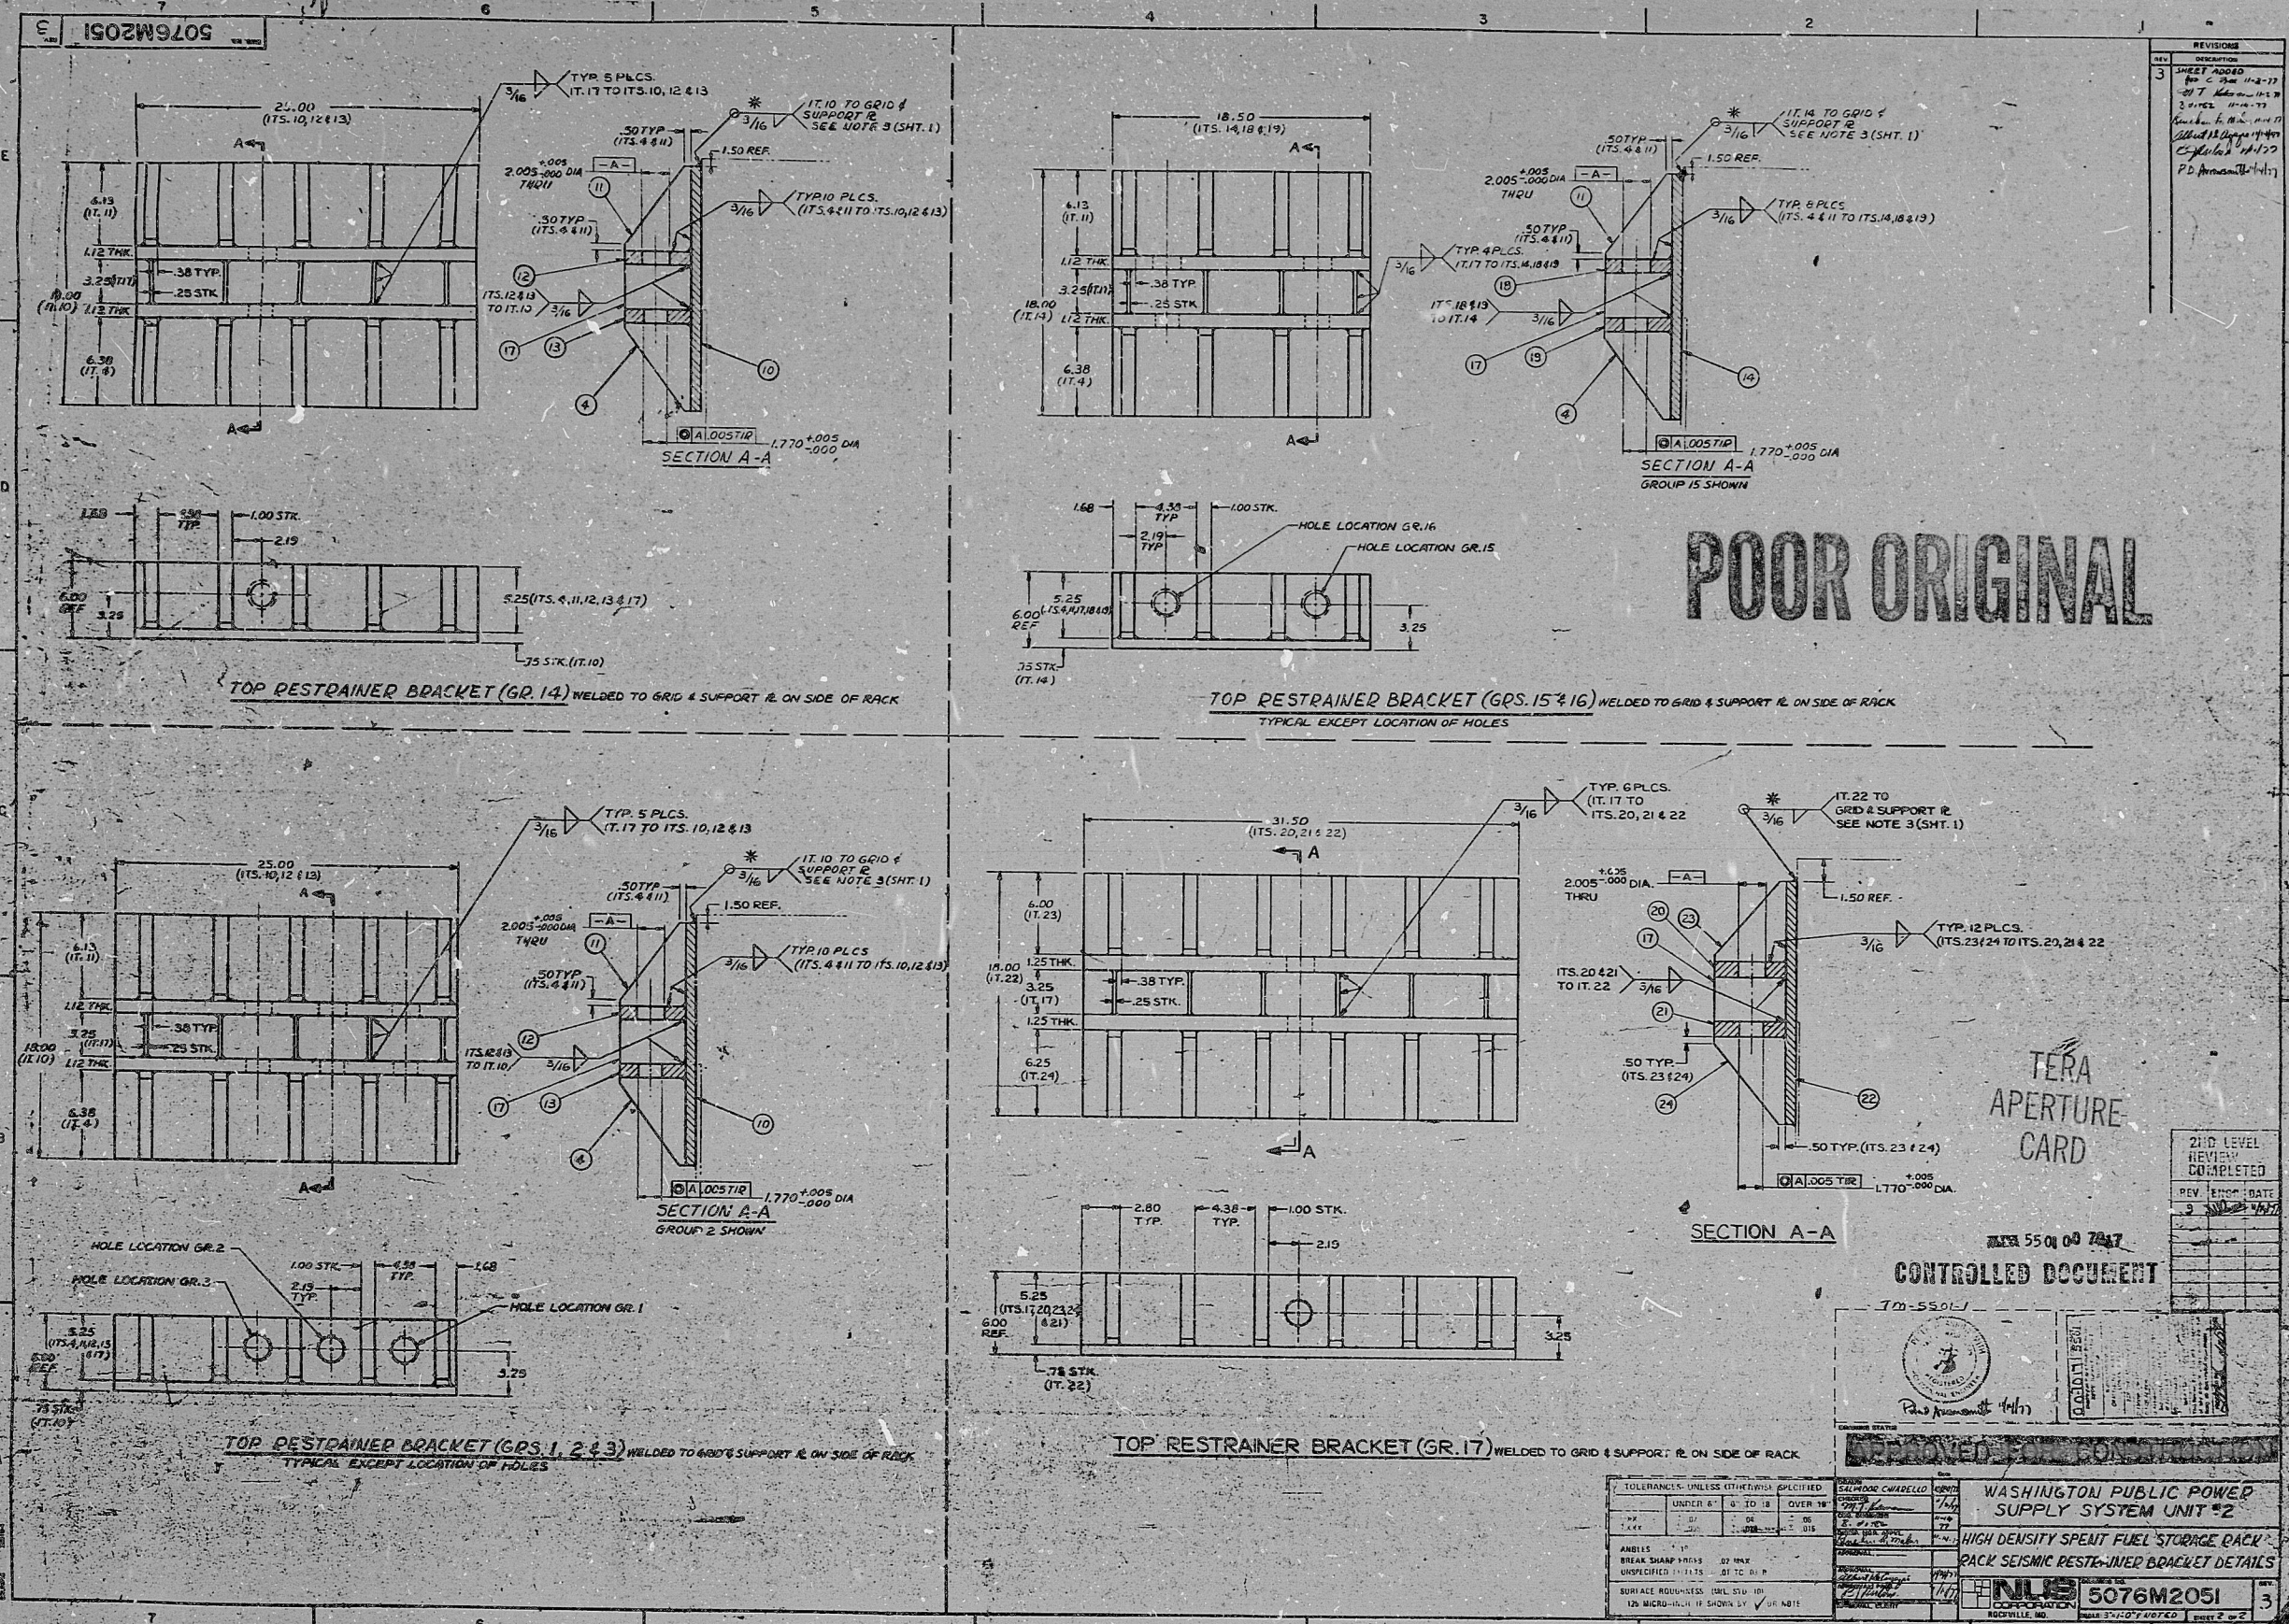