


17  
11  
8.5  
8.5  
11  
17

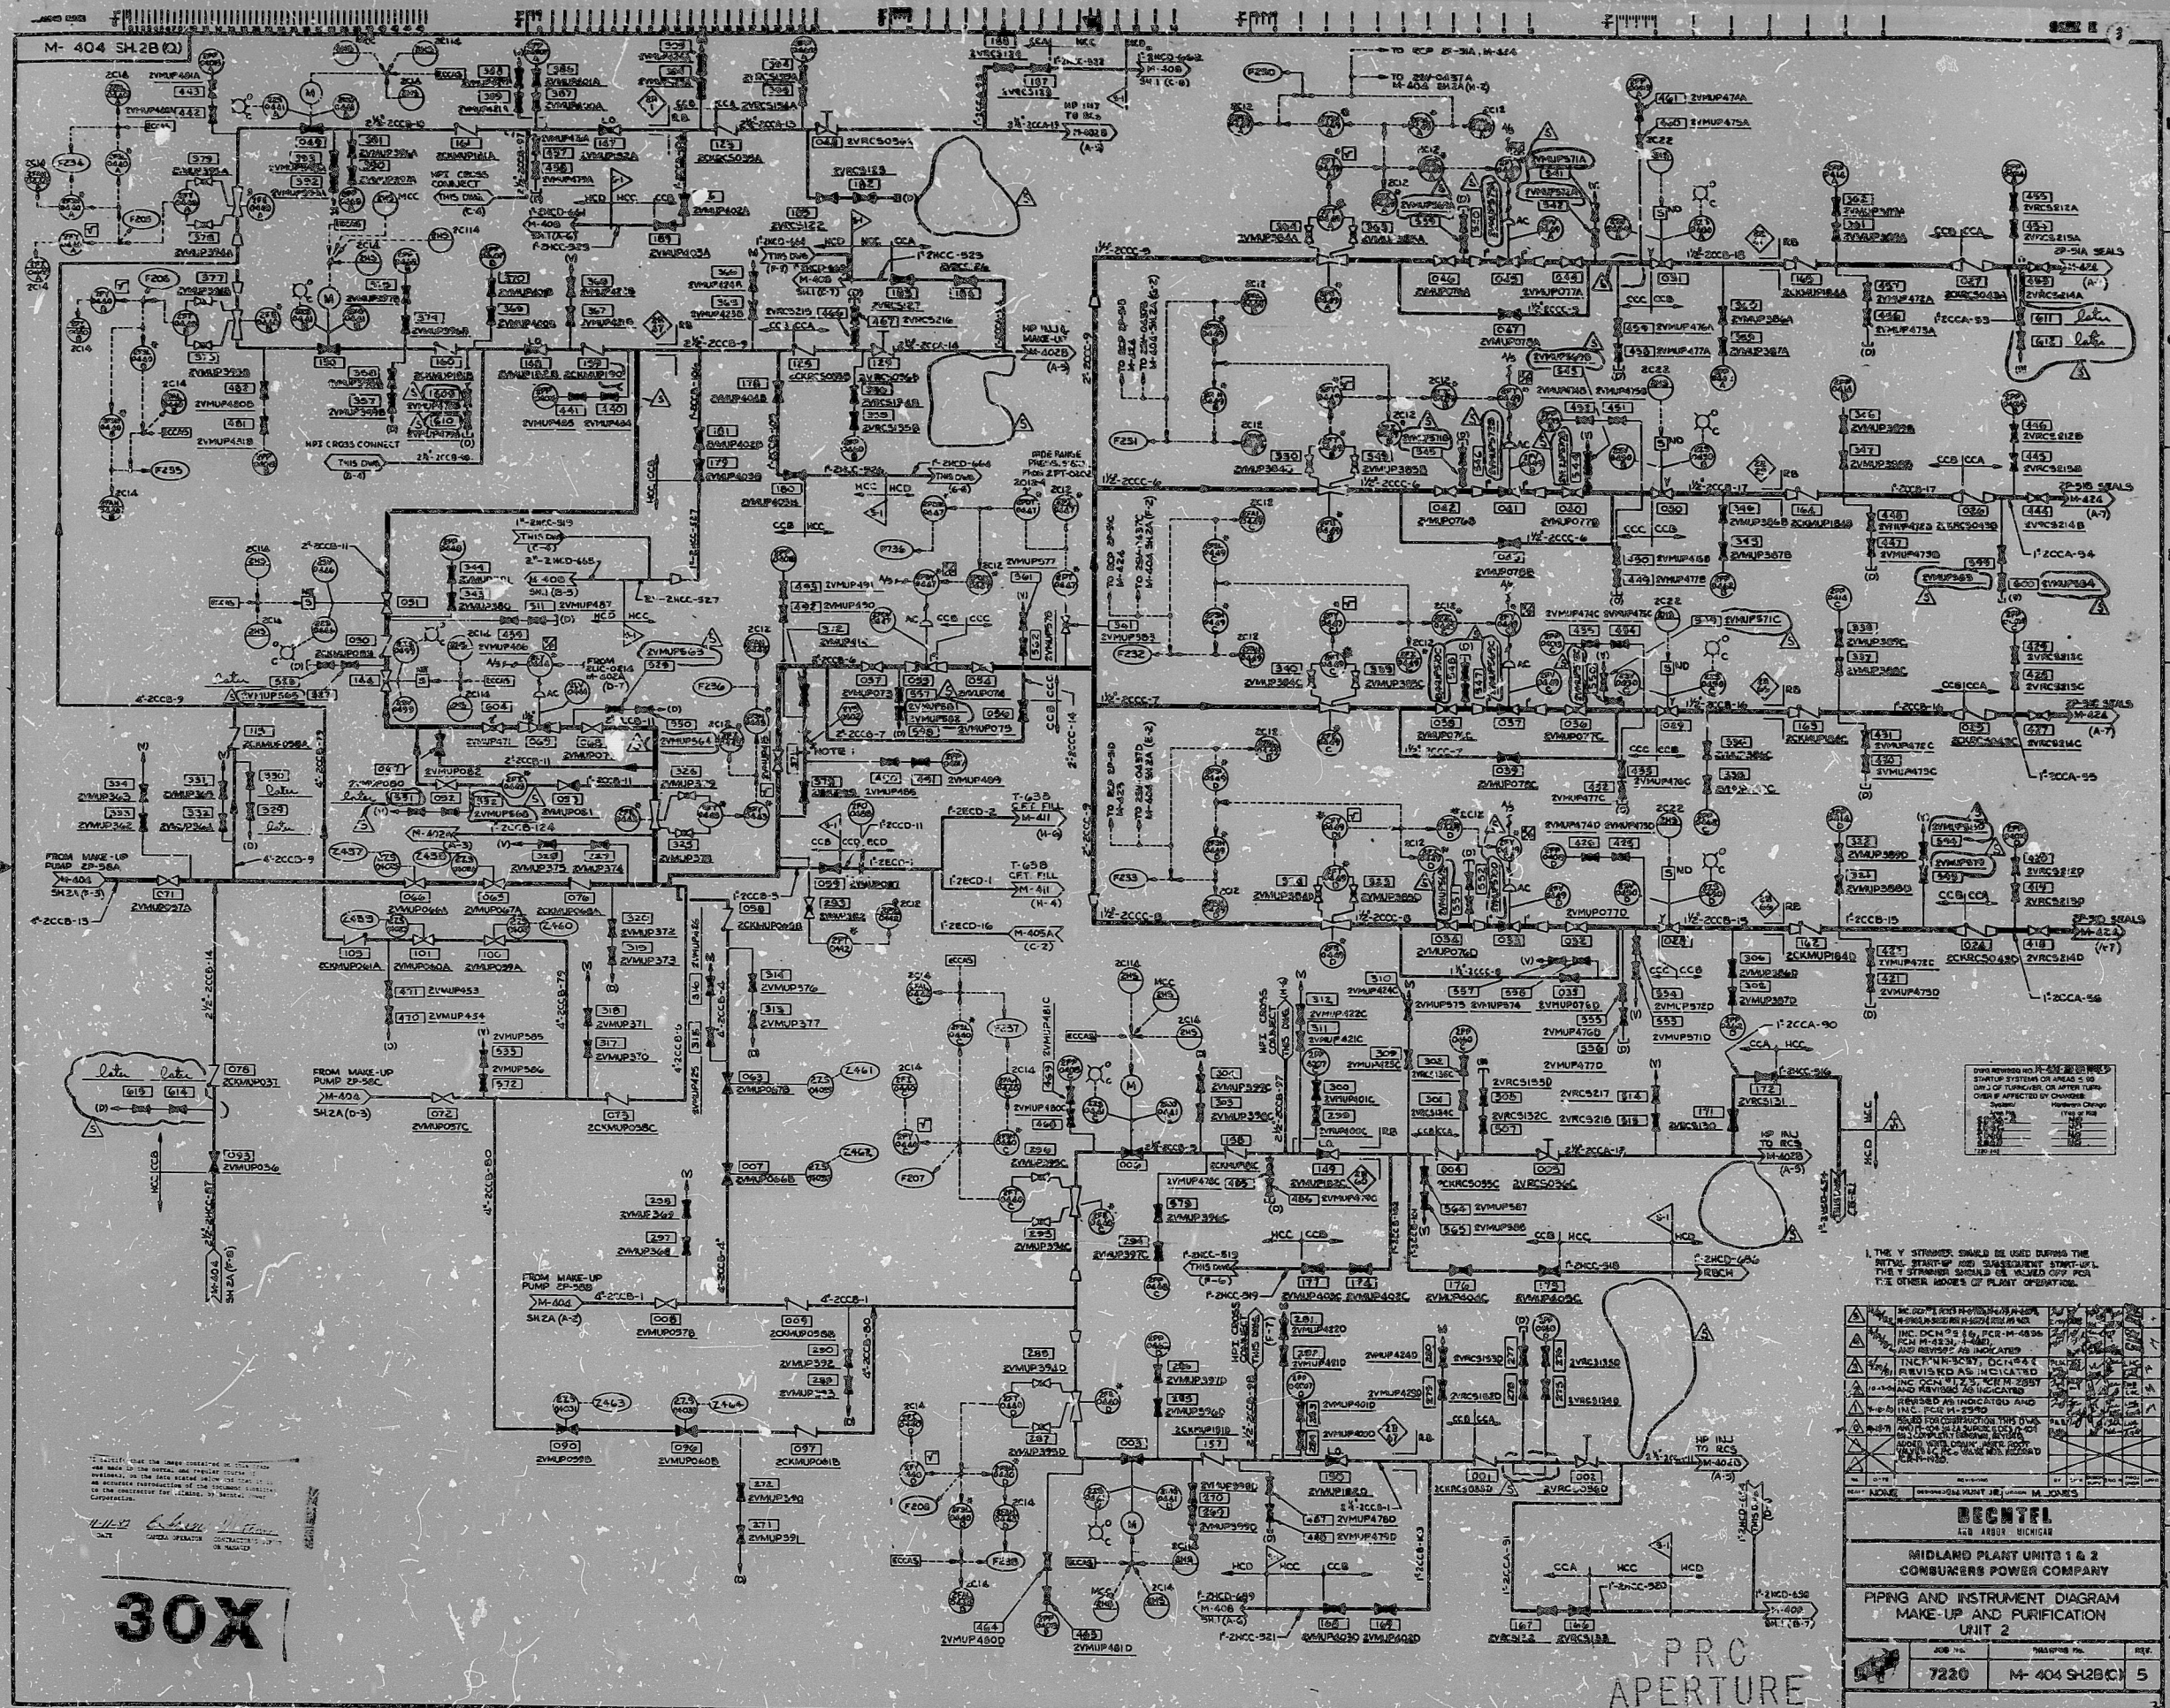

17  
11  
8.5  
8.5  
11  
17

REVISIONS

NO.	DESCRIPTION	DATE	BY	CHKD.

DATE: 11/17/77  
DRAWN: J. H. JONES  
CHECKED: M. JONES  
DATE: 11/17/77

**RECHTEL**  

MIDLAND PLANT UNITS 1 & 2  
CONSUMERS POWER COMPANY

PIPING AND INSTRUMENT DIAGRAM  
MAKE-UP AND PURIFICATION  
UNIT 2

JOB NO.	PLANTING NO.	REV.
7220	M-404 SH2B(C)	5

PRC APERTURE CARD 2

RIDS

8302090459

