


- NOTES:
1. 3/4" STD. IN. FOR HIGH PRESSURE PUMP CONNECTION ARE PROVIDED FOR FUTURE USE.
 2. (TABLE) (TYPICAL)
 3. LINES TO SAMPLE SYSTEMS ARE STAINLESS STEEL TUBING AS SPECIFIED IN 7200-1-409.
 4. VENT AND OVERTFLOW FROM BORIC ACID MIX TANK ACCOMPLISHED THROUGH RUNWAY ON TOP OF TANK.
 5. THE LOOP-SEAL ISOLATION VALVE SHOULD BE CONVENIENTLY LOCATED IN A LOW RADIATION ZONE TO ALLOW FILLING OF THE LOOP-SEAL BY DEMINERALIZED WATER. A NORMALLY OPEN ISOLATION VALVE SHOULD BE INCLUDED UPSTREAM OF THE TUBING WHICH MAY BE MAINTAINED FOR THE LOOP-SEAL VALVE MAINTENANCE.
 6. THE VACUUM BREAKERS SHOULD BE LOCATED WITHIN THREE FEET OF THE TANK NOZZLE.
 7. THE MAXIMUM ELEVATION OF THE LOOP-SEAL TO BE AS CLOSE TO THE TOP OF THE TANK AS POSSIBLE.
 8. VACUUM BREAKER INLET LINE TO BE PROVIDED WITH LOOPS TO PREVENT DUST ACCUMULATION.

PRO APERTURE CARD

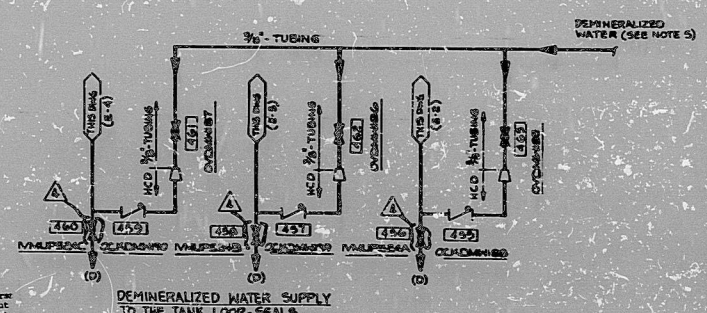

3-D-X




PREPARED BY: [Signature]
 CHECKED BY: [Signature]
 APPROVED BY: [Signature]

BECHTEL

PIPING & INSTRUMENT DIAGRAM
 REACTOR CHEMICAL ADDITION
 UNIT 1 & 2

REV.	DATE	DESCRIPTION
722	M-405 B	4

RIDS

8302090463

