


M-407SH2A

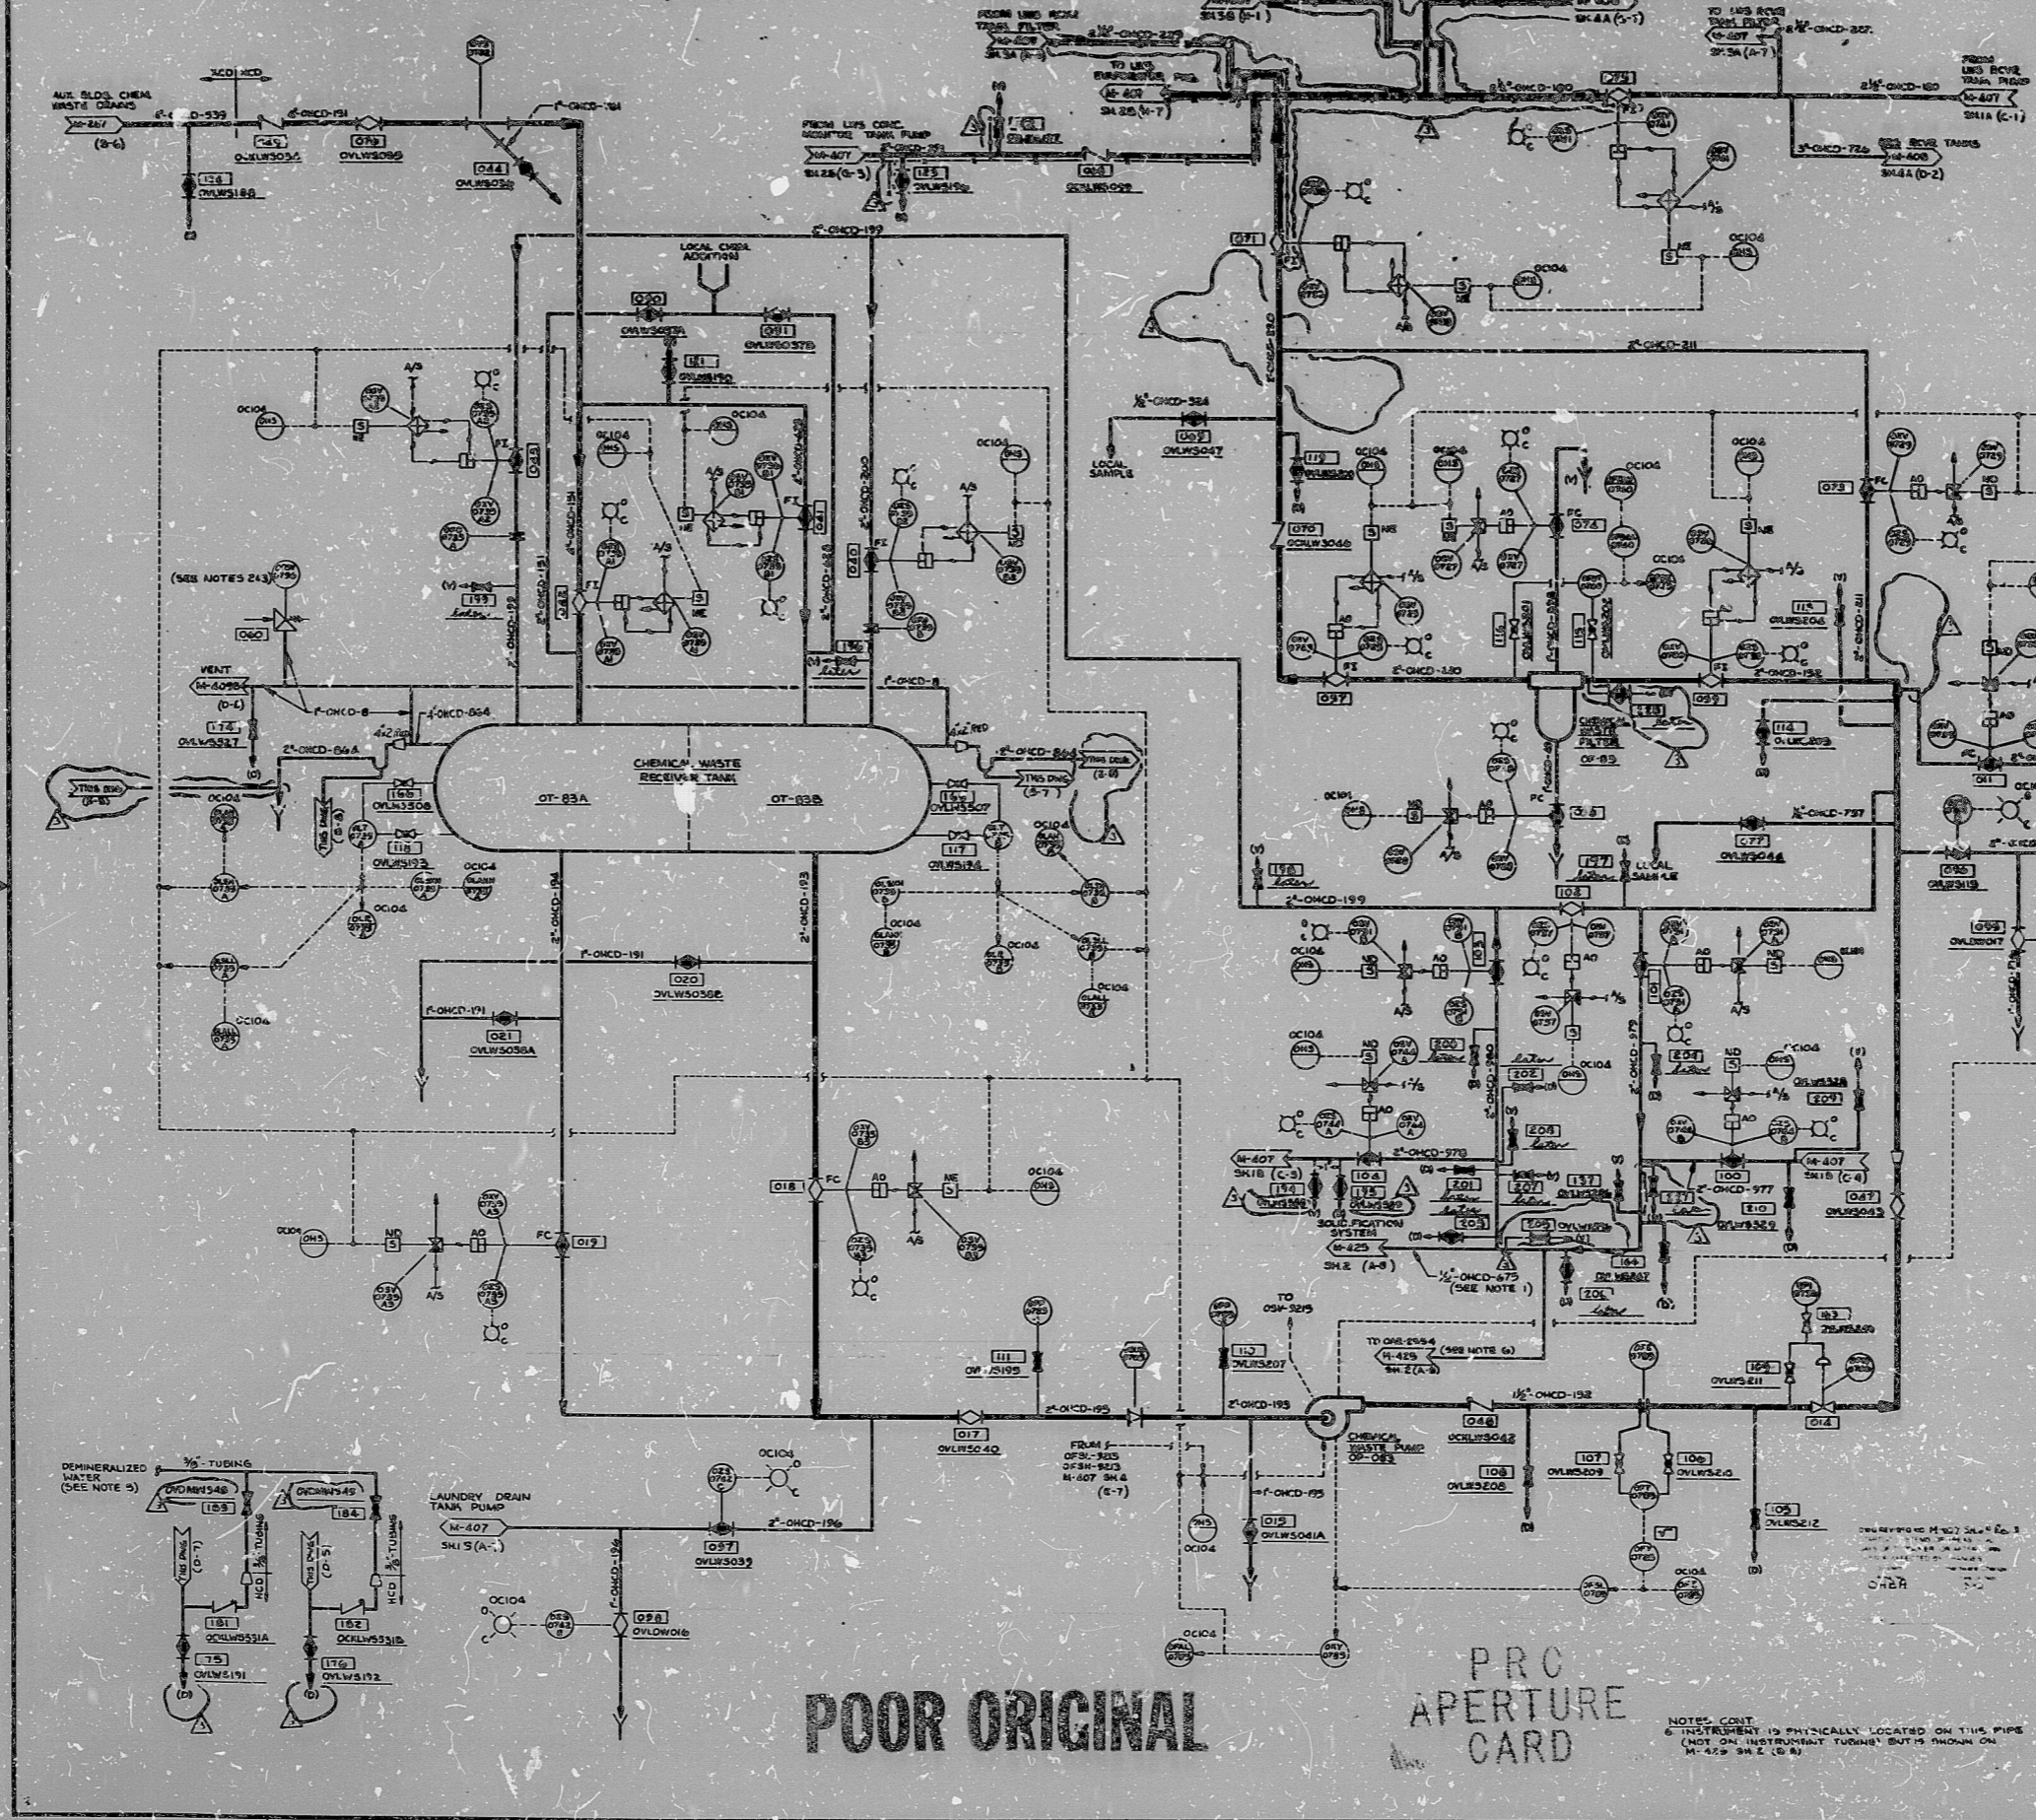

30X

- NOTES:
1. THIS LINE SHALL BE KEPT AS SHORT AS POSSIBLE FROM THE DECONTAMINATION LINES TO THE WASTING PUMPS IN THE SOLID WASTE SYSTEM. SEE P-220 M-407, SHEET 1.
 2. JOCK-STRS SHOULD BE LOCATED WITHIN THREE FEET OF THESE NOZZLES.
 3. INCLUDE ORIFICE VALVE INLET LINES TO BE PROVIDED WITH LOOPS TO PREVENT DUST ACCUMULATION.
 4. IN LOOSE POINTS FOR PRESSURE POINTS MAY BE USED FOR TESTING AND PURGING. SEE P-220 M-407, SHEET 1.
 5. THE LOOP ORIFICE VALVE SHOULD BE CONSIDERED TO BE LOCATED AS A LOW POINT ZONE TO ALLOW FILLING OF THE LOOP SIGNAL BY DEMINERALIZED WATER. AN ORIFICE VALVE SHOULD BE INCLUDED UPSTREAM OF THE TUBING WHICH MAY BE MANIPULATED FOR THE LOOP SIGNAL MAINTENANCE.

REV	DATE	BY	CHKD
1	11/18/68	M. JONES	
2	11/18/68	M. JONES	
DECTEL
188 18221 W-1116

MIDLAND PLANT UNITS 1 & 2
CONSUMERS POWER COMPANY

PIPING AND INSTRUMENT DIAGRAM
LIQUID WASTE UNIT 1&2

APP. NO.	REVISED NO.	REV.
7220	M-407 SH2A	3

POOR ORIGINAL

PRO APERTURE CARD

NOTES CONT.

11

11

8.5

8.5

11

17

11

11

8.5

8.5

11

17

RIDS

8302090468

