


17" 8.5" 11" 8.5" 17"

This drawing and the design it represents are the property of BECHTEL. They are hereby loaned to the customer for use only in connection with the project for which they were prepared. They shall not be reproduced, copied, loaned, retransmitted, or otherwise used in any manner without the prior written consent of BECHTEL.

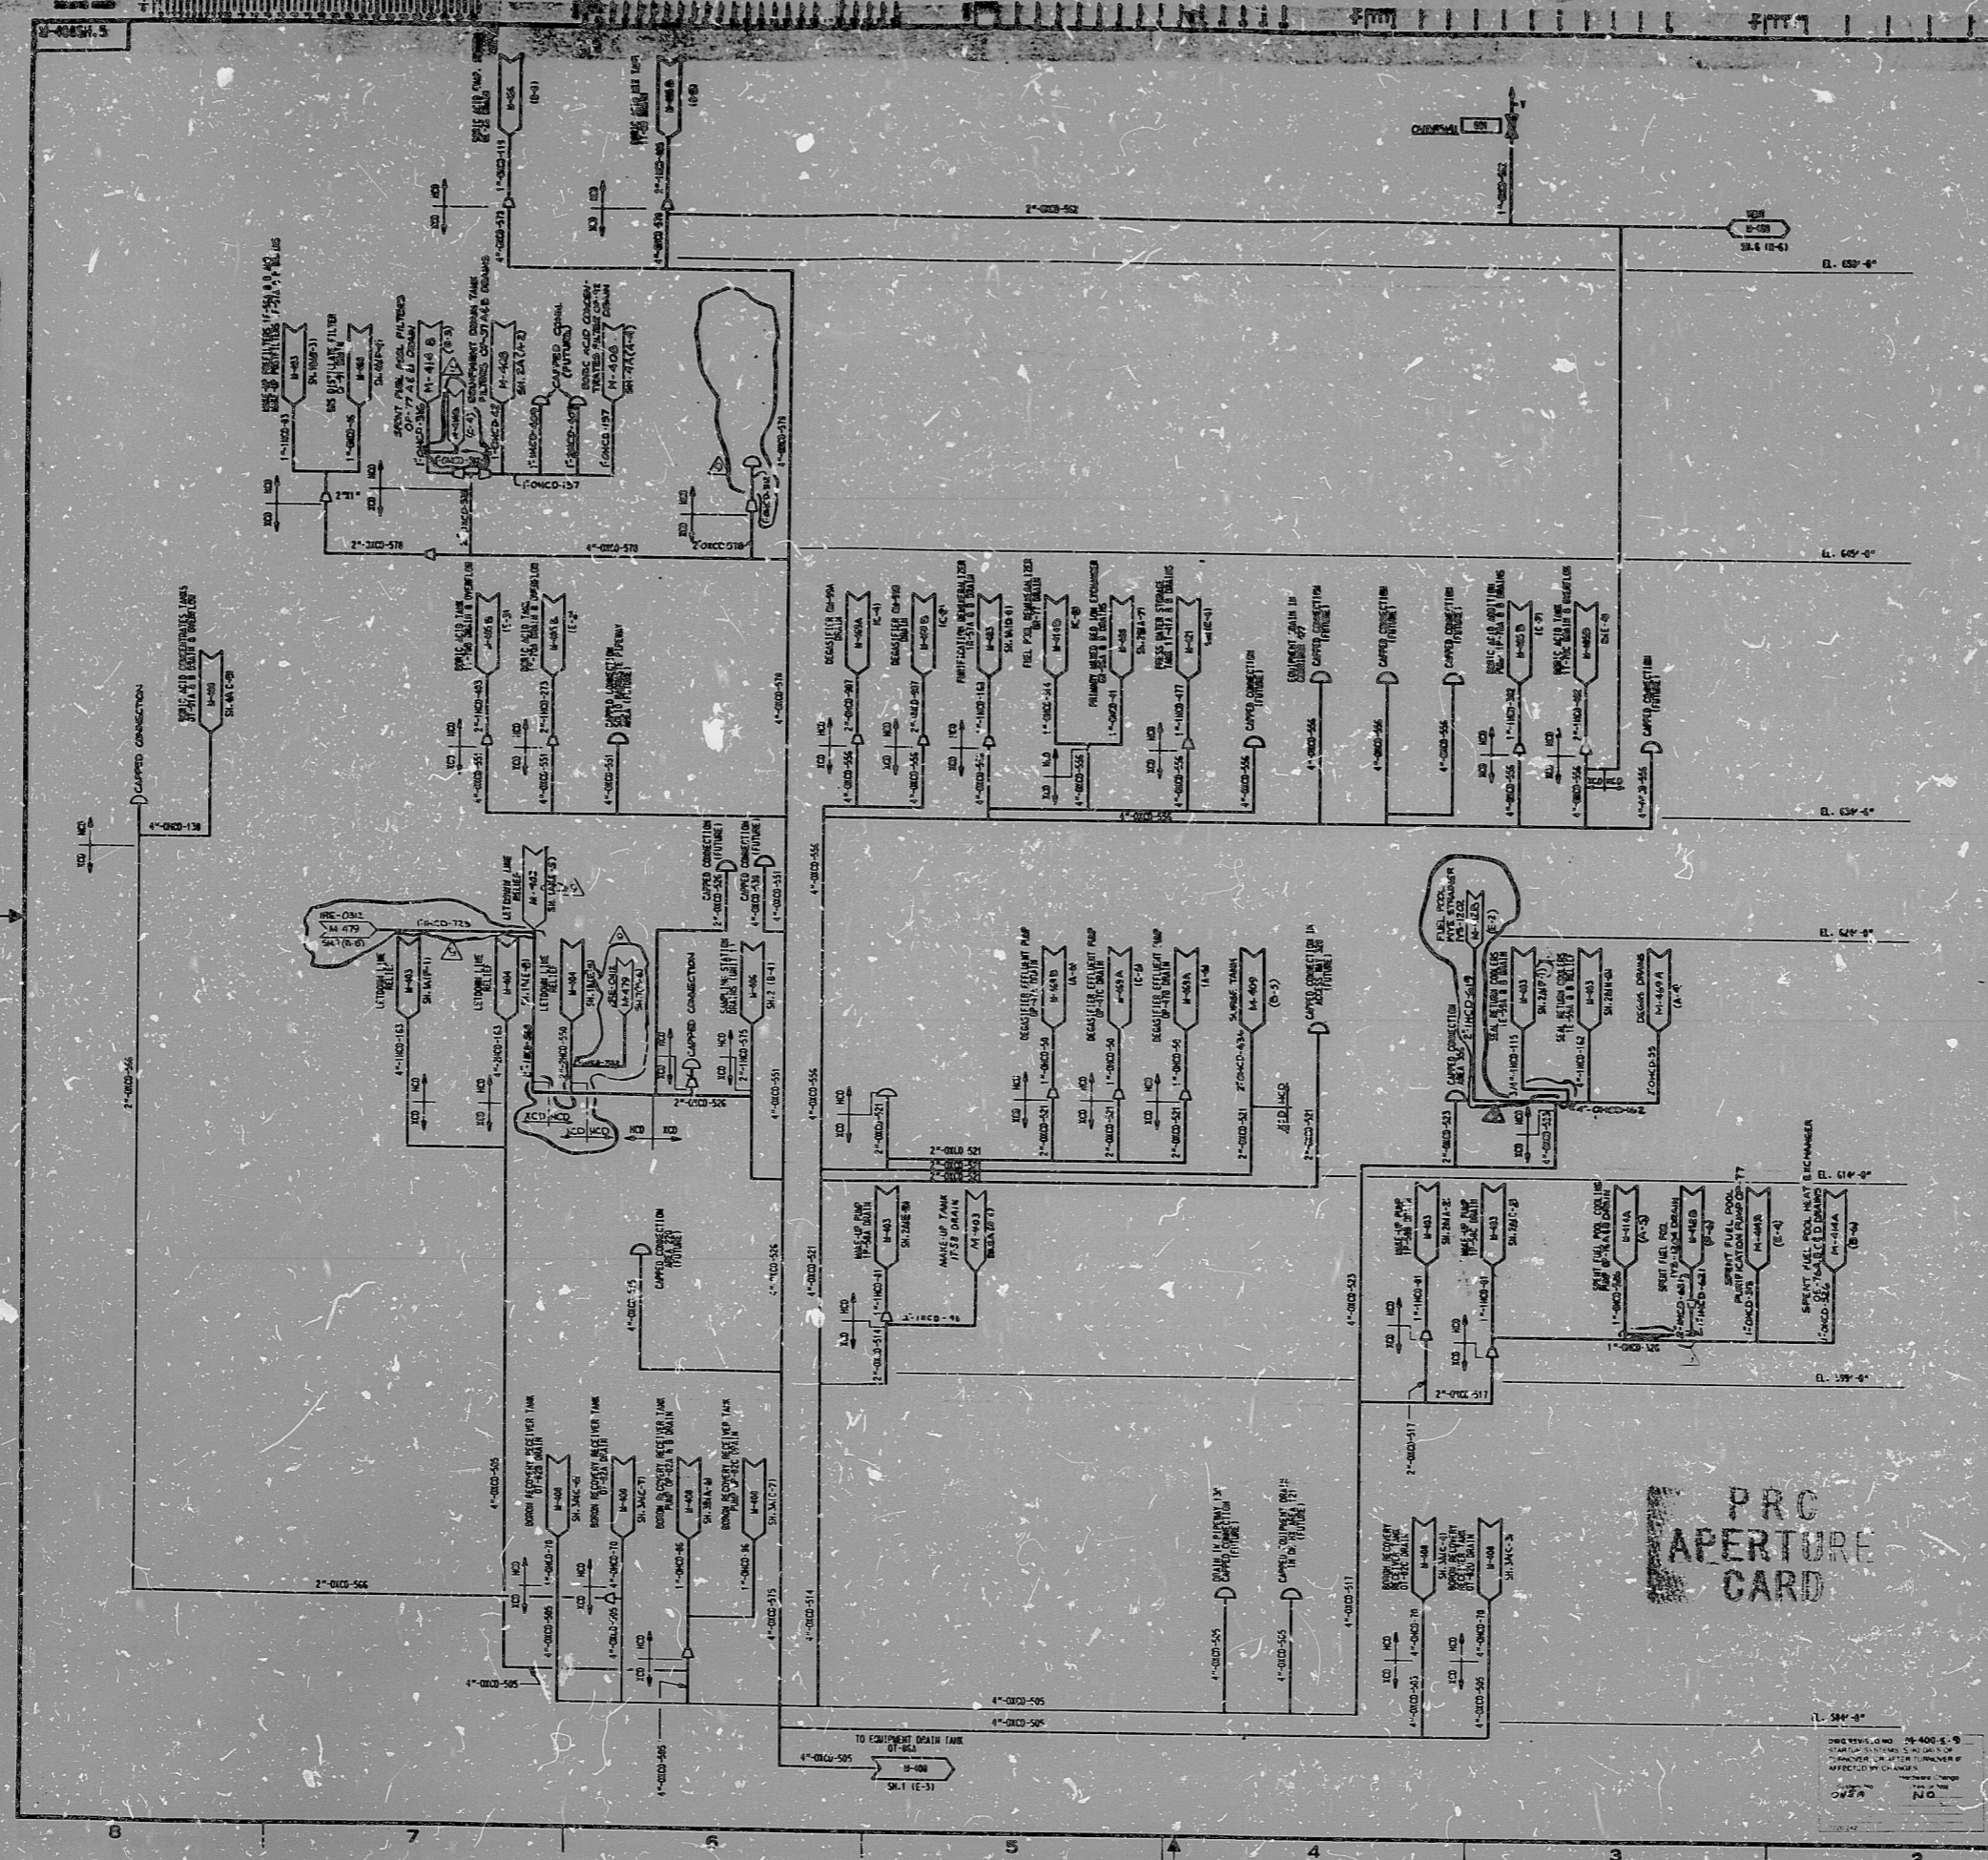


NOTE:
 1. THE ORDER OF PIPING CONNECTIONS TO EXISTING PIPING IS SHOWN AS A SCHEMATIC REPRESENTATION ONLY. ACTUAL CONSTRUCTION ORDER OF PIPING CONNECTIONS IS NOT CRITICAL.

PRC APERTURE CARD


NONE			F. KRAUSS			CAD			
BECHTEL									
LADLAND PLANT UNITS 1 & 2									
CONSUMERS POWER COMPANY									
PIPING AND INSTRUMENT DIAGRAM									
UNITS 1 & 2									

RIDS

8392090562

