


"I certify that the design shown on this form was made in the regular course of business, on the basis stated below and that the reproduction of this document, report or drawing for filing, by another person, is prohibited by law."

2-25-83 *C. Martin*
 CONTRACTOR'S SIGNATURE
 DATE

16X

This drawing and the design it contains are the property of RECHTEL. They are hereby loaned and on the borrower's return agreement that they will be used for the purpose intended, and not be reproduced, copied, or used in any way without the express written permission of RECHTEL.

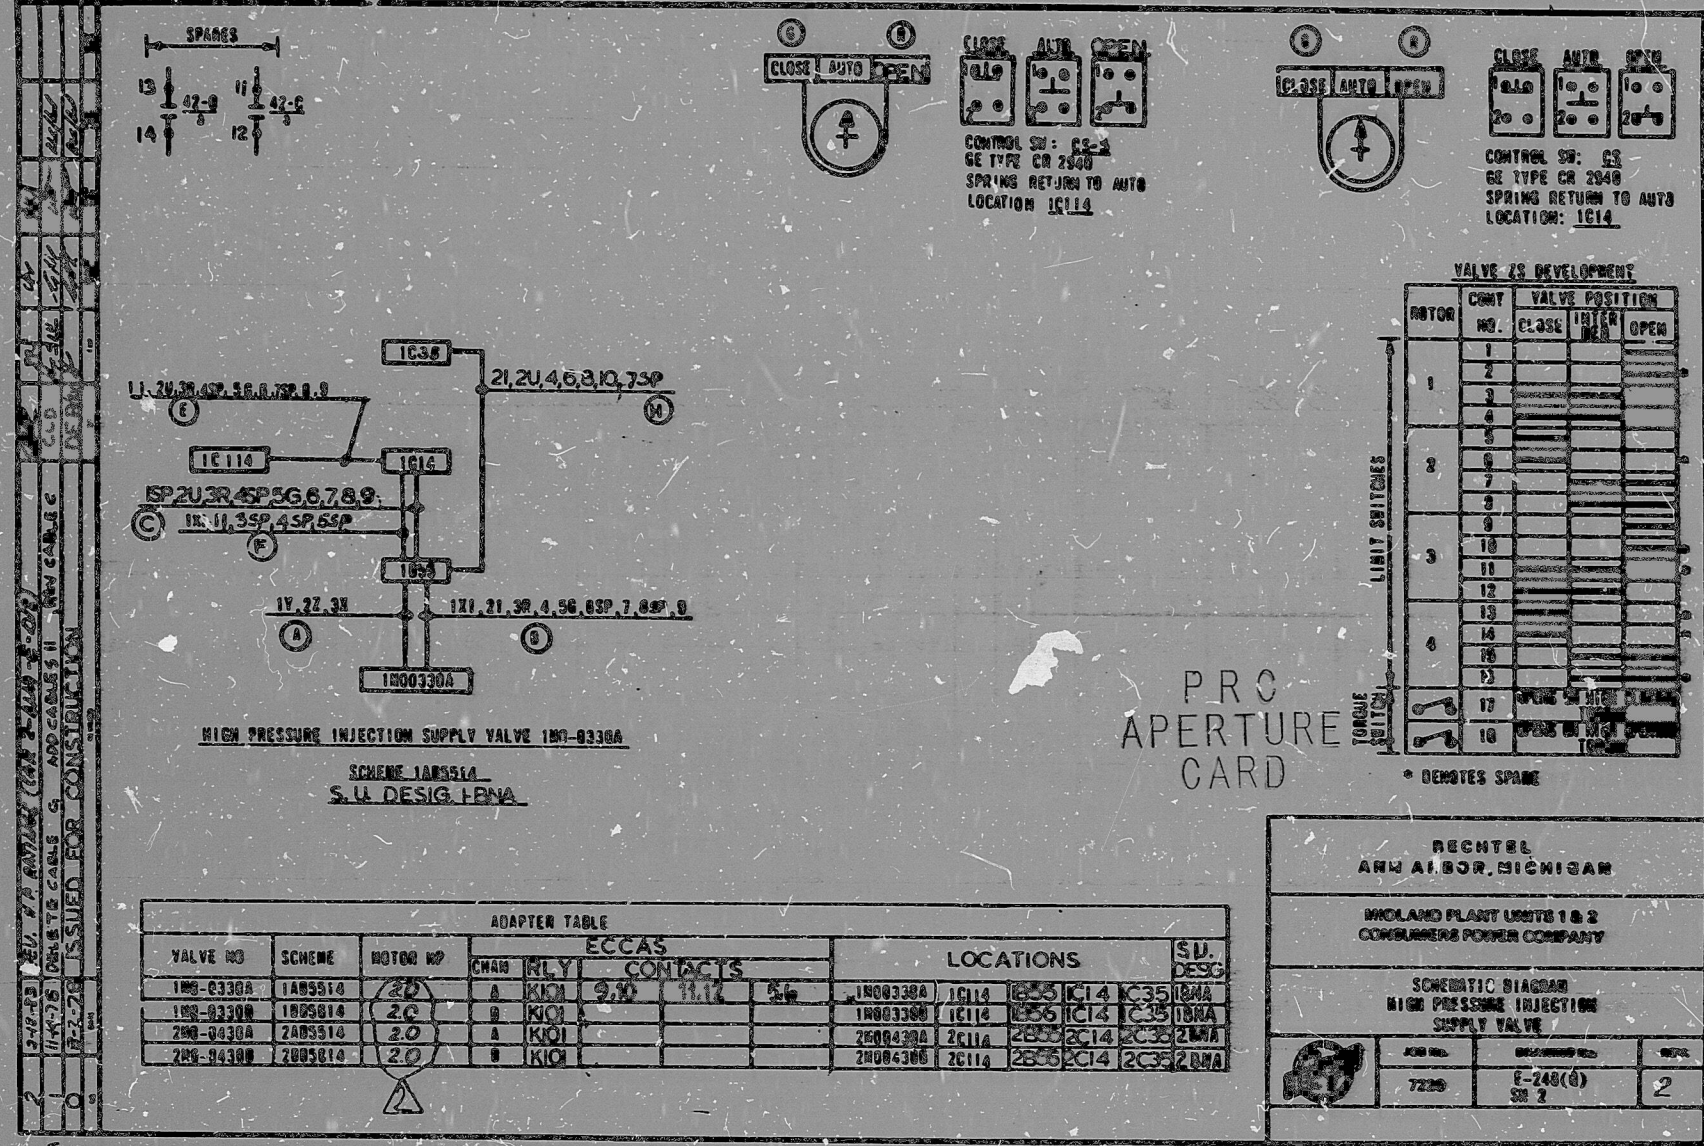

PDR RID'S

8401180298

