


M-417 SH1B

SIZE 8

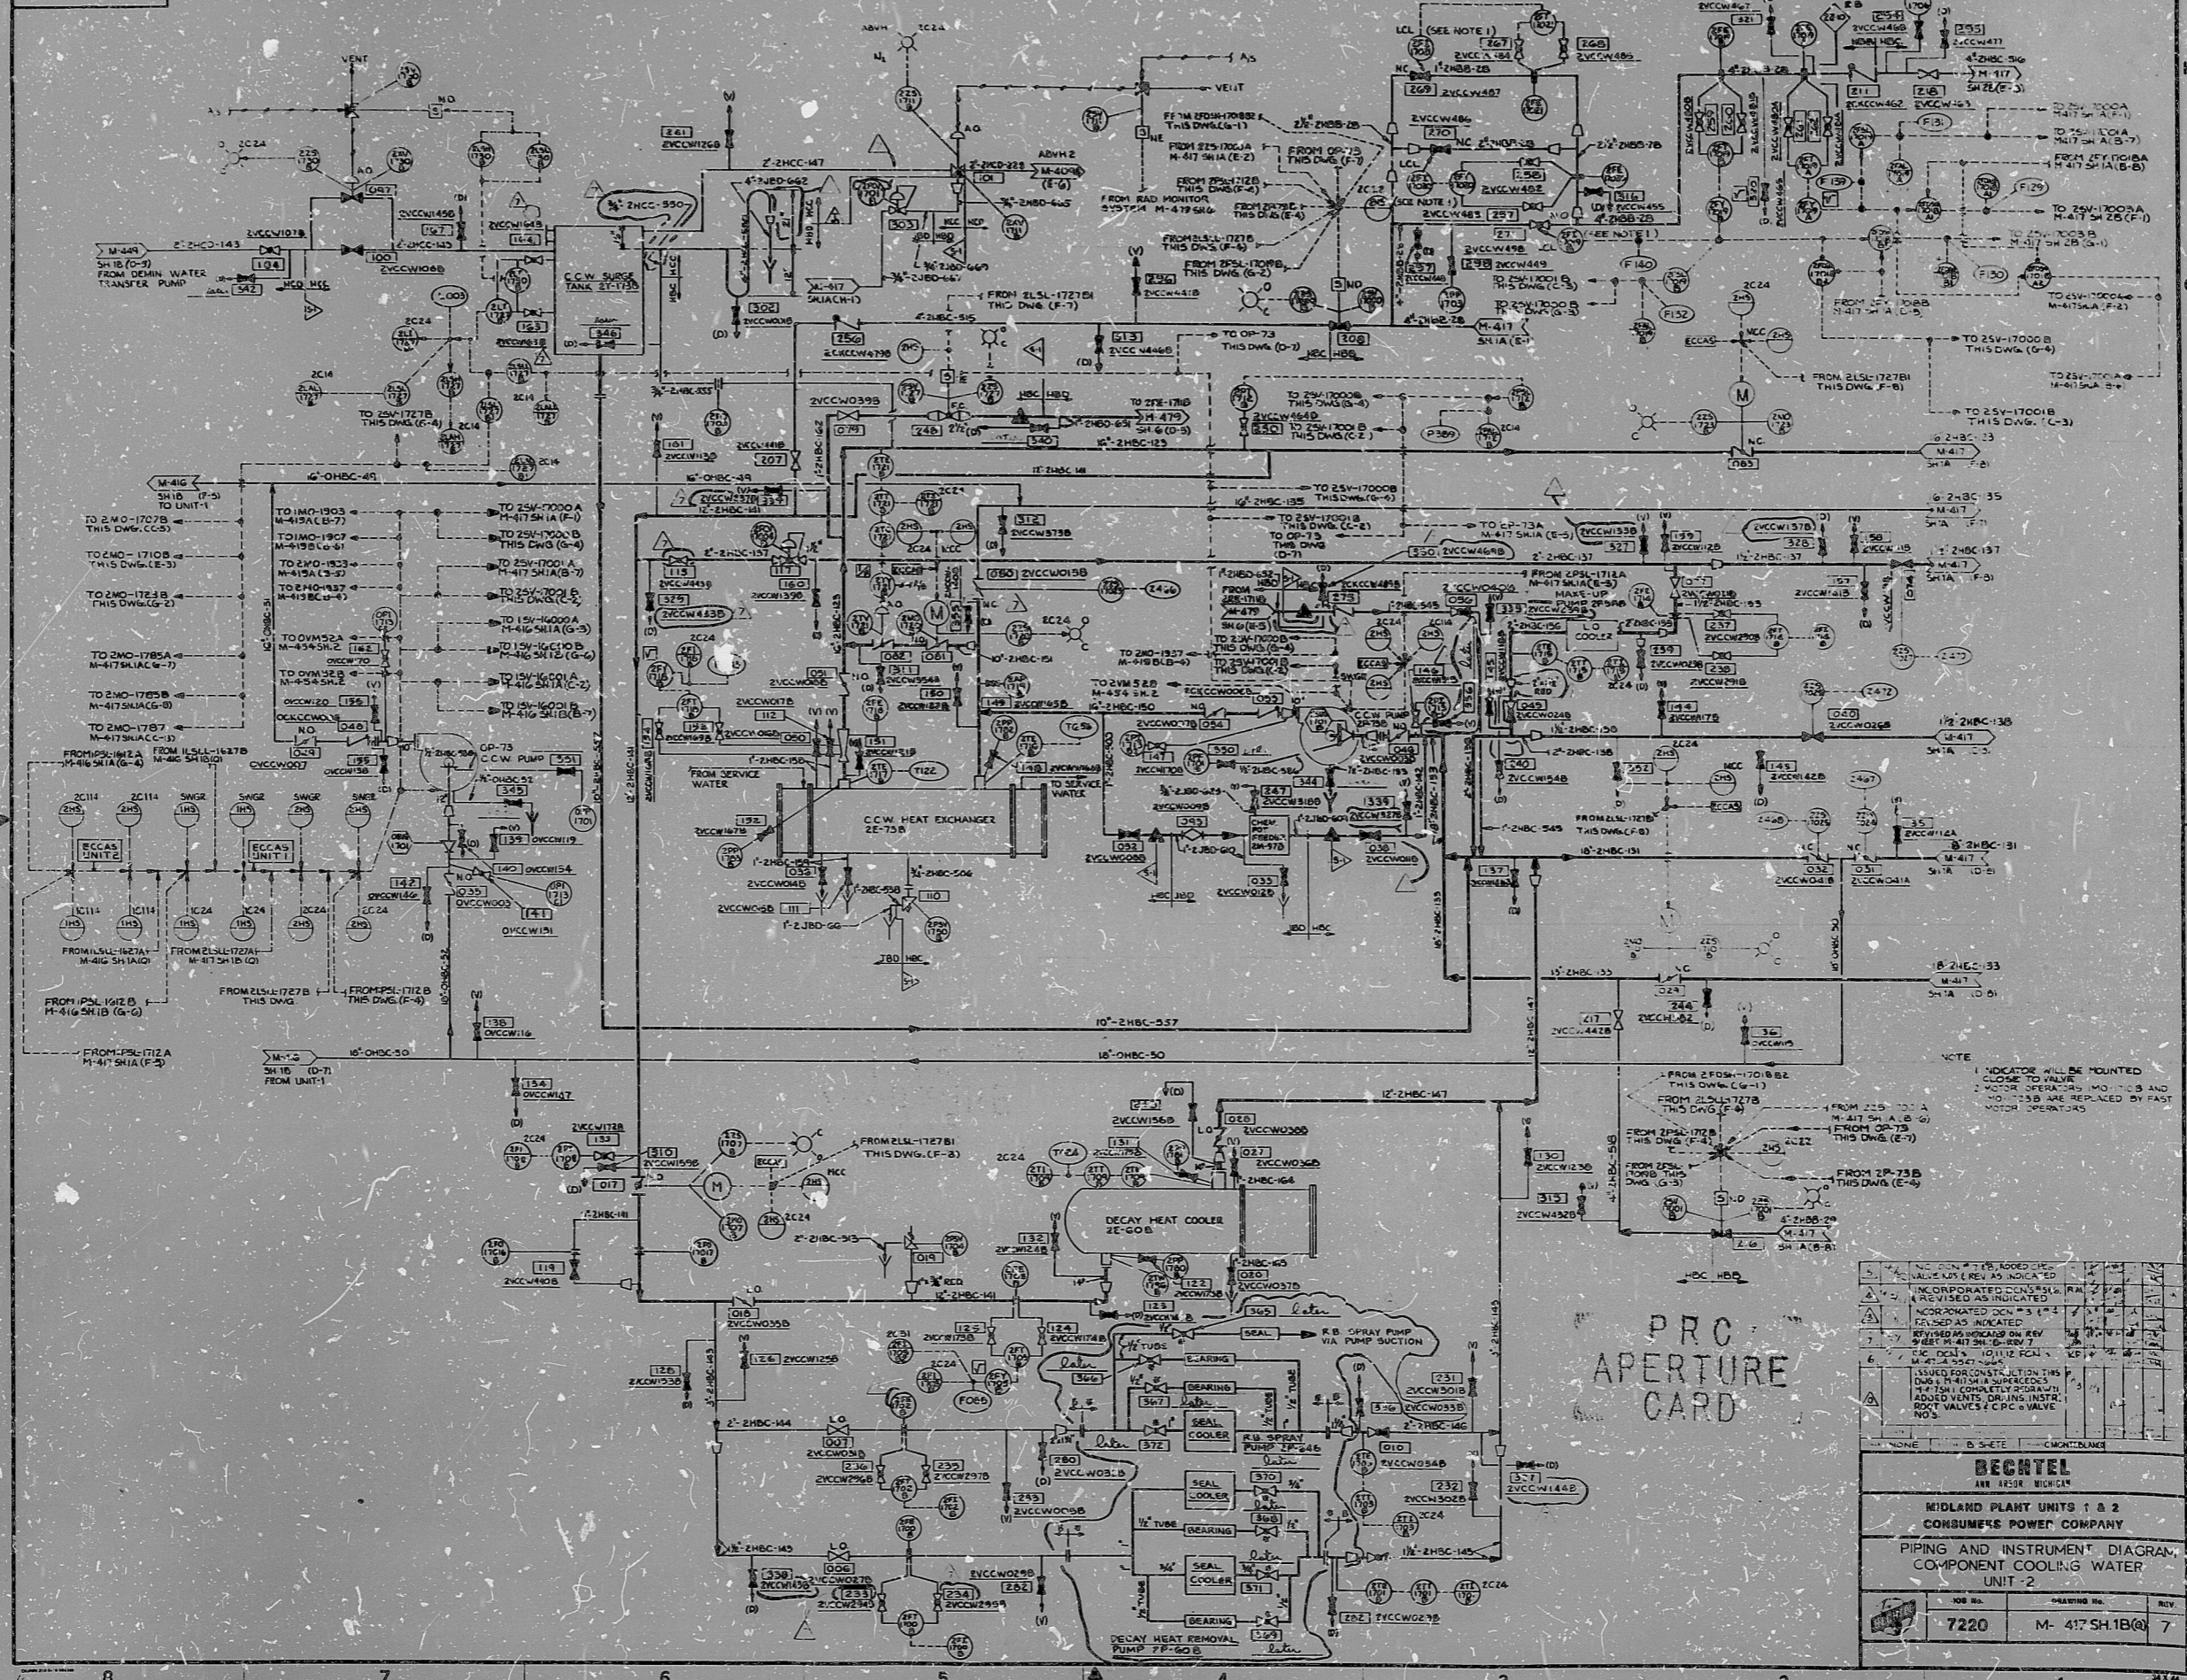

PRO APERTURE CARD

NO.	DESCRIPTION	DATE	BY

BECHTEL	
MIDLAND PLANT UNITS 1 & 2	
CONSUMERS POWER COMPANY	
PIPING AND INSTRUMENT DIAGRAM	
COMPONENT COOLING WATER	
UNIT 2	
7228	M-417 SH.1B(7)

8.5"
11"
17"

8.5"
11"
17"

RIDS

8302090589

