


M-421SH.2(C)

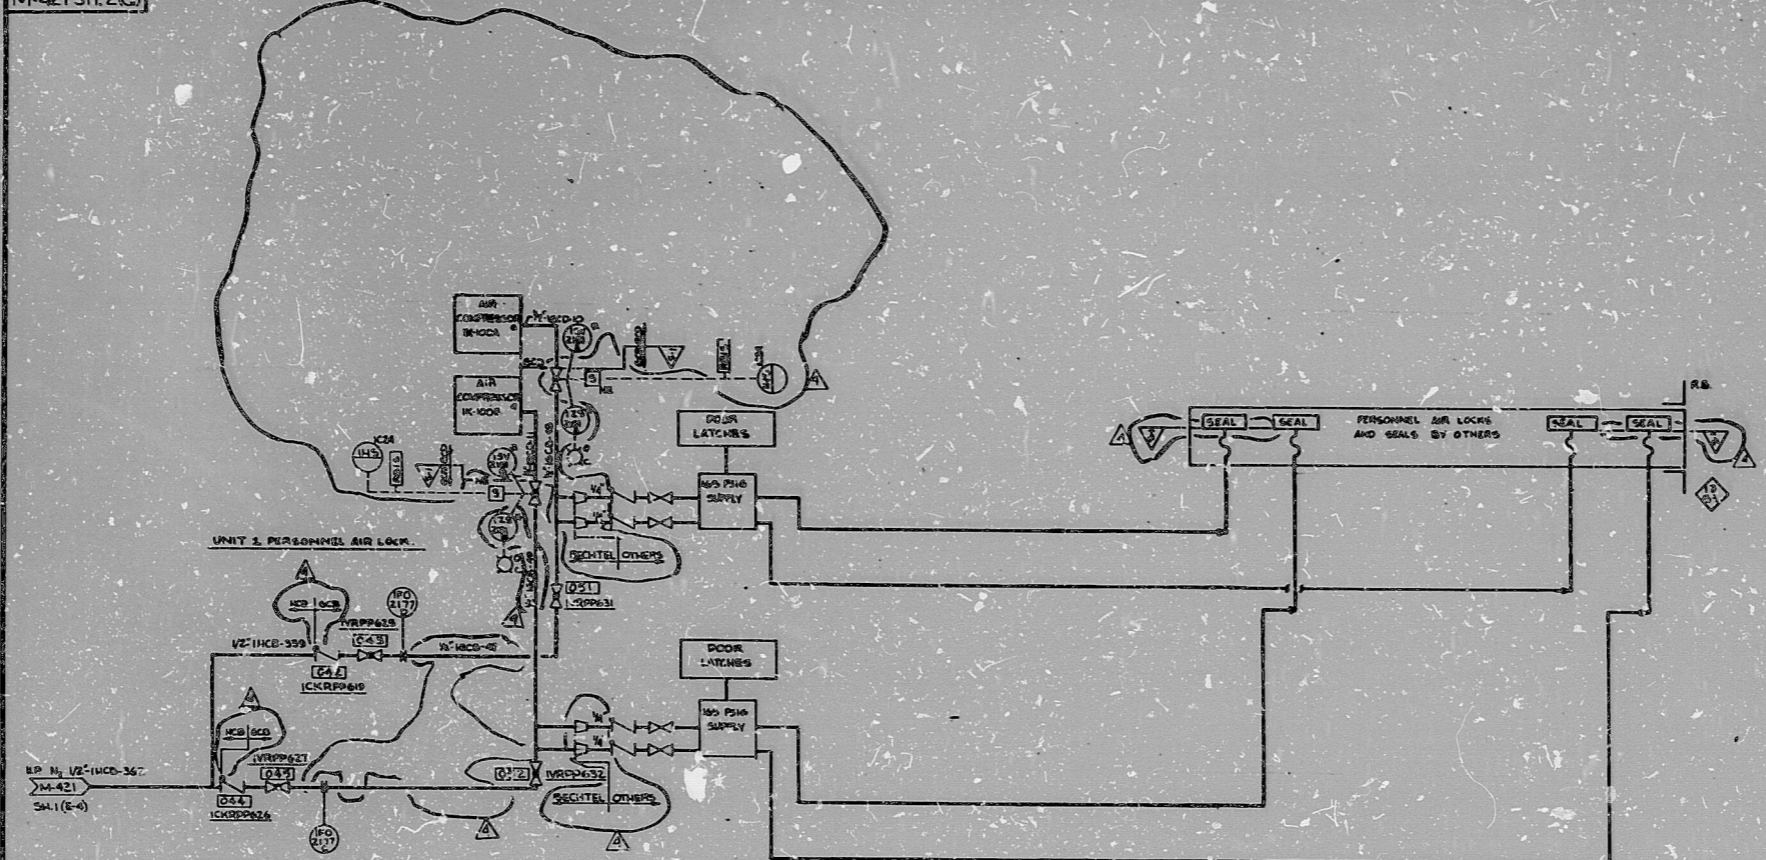

This drawing and its contents are the property of Consumers Power Company. They are hereby loaned to you for your use only. They are not to be reproduced, copied, or otherwise used in any way without the express written consent of Consumers Power Company.

30X

PRO APERTURE CARD

<b>BECHTEL</b>	
MIDLAND PLANT UNITS 1 & 2 CONSUMERS POWER COMPANY	
PIPING AND INSTRUMENT DIAGRAM REACTOR BUILDING PENETRATION PRESSURIZATION UNIT-1	
JOB NO. 7220	DRAWING NO. M-421 SH.2 (C)

KIDS

8302090604

