


M-422 SH 2Q

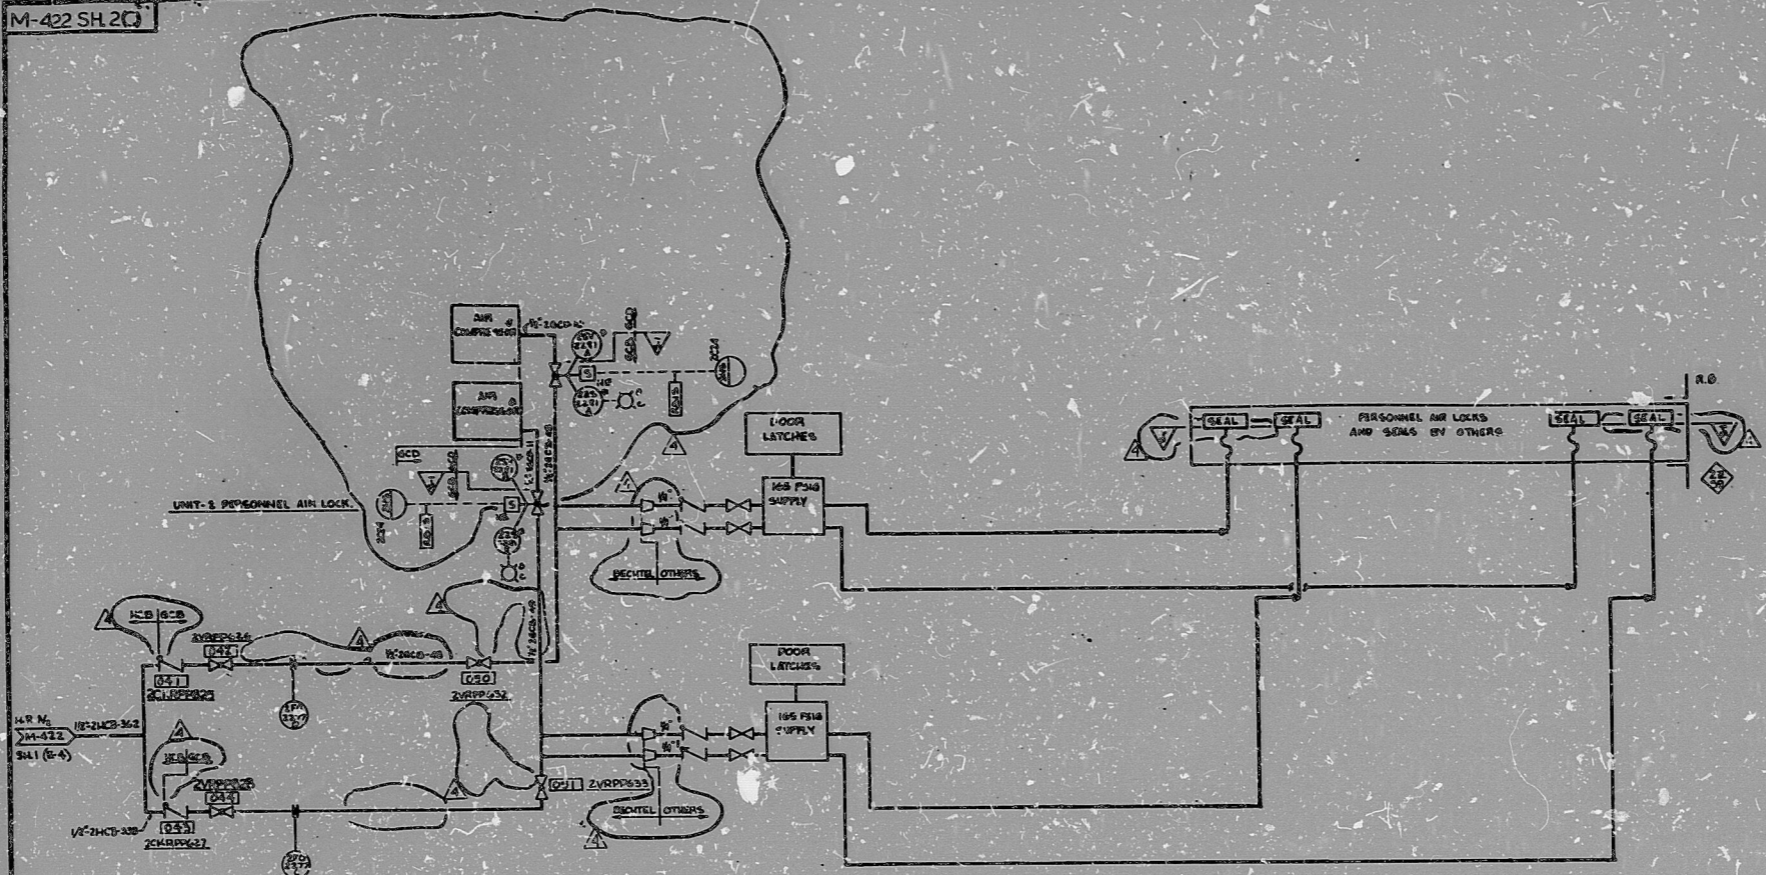

PRO APERTURE CARD


REVISION	DATE	BY	DESCRIPTION
1			ISSUED FOR CONSTRUCTION
2			
3			
4			
5			
6			
7			
8			
9			
10			

MIDLAND PLANT UNITS 1 & 2 CONSUMERS POWER COMPANY			
PIPING AND INSTRUMENT DIAGRAM REACTOR BUILDING PENETRATION PRESSURIZATION UNIT-2			
NO.	REV.	DATE	BY
7220	M-422 SH 2Q		4

17"

11"

8.5"

8.5"

11"

17"

17"

11"

8.5"

8.5"

11"

17"

RIDS

8302090608

