


M-423A(0)

SIZE E

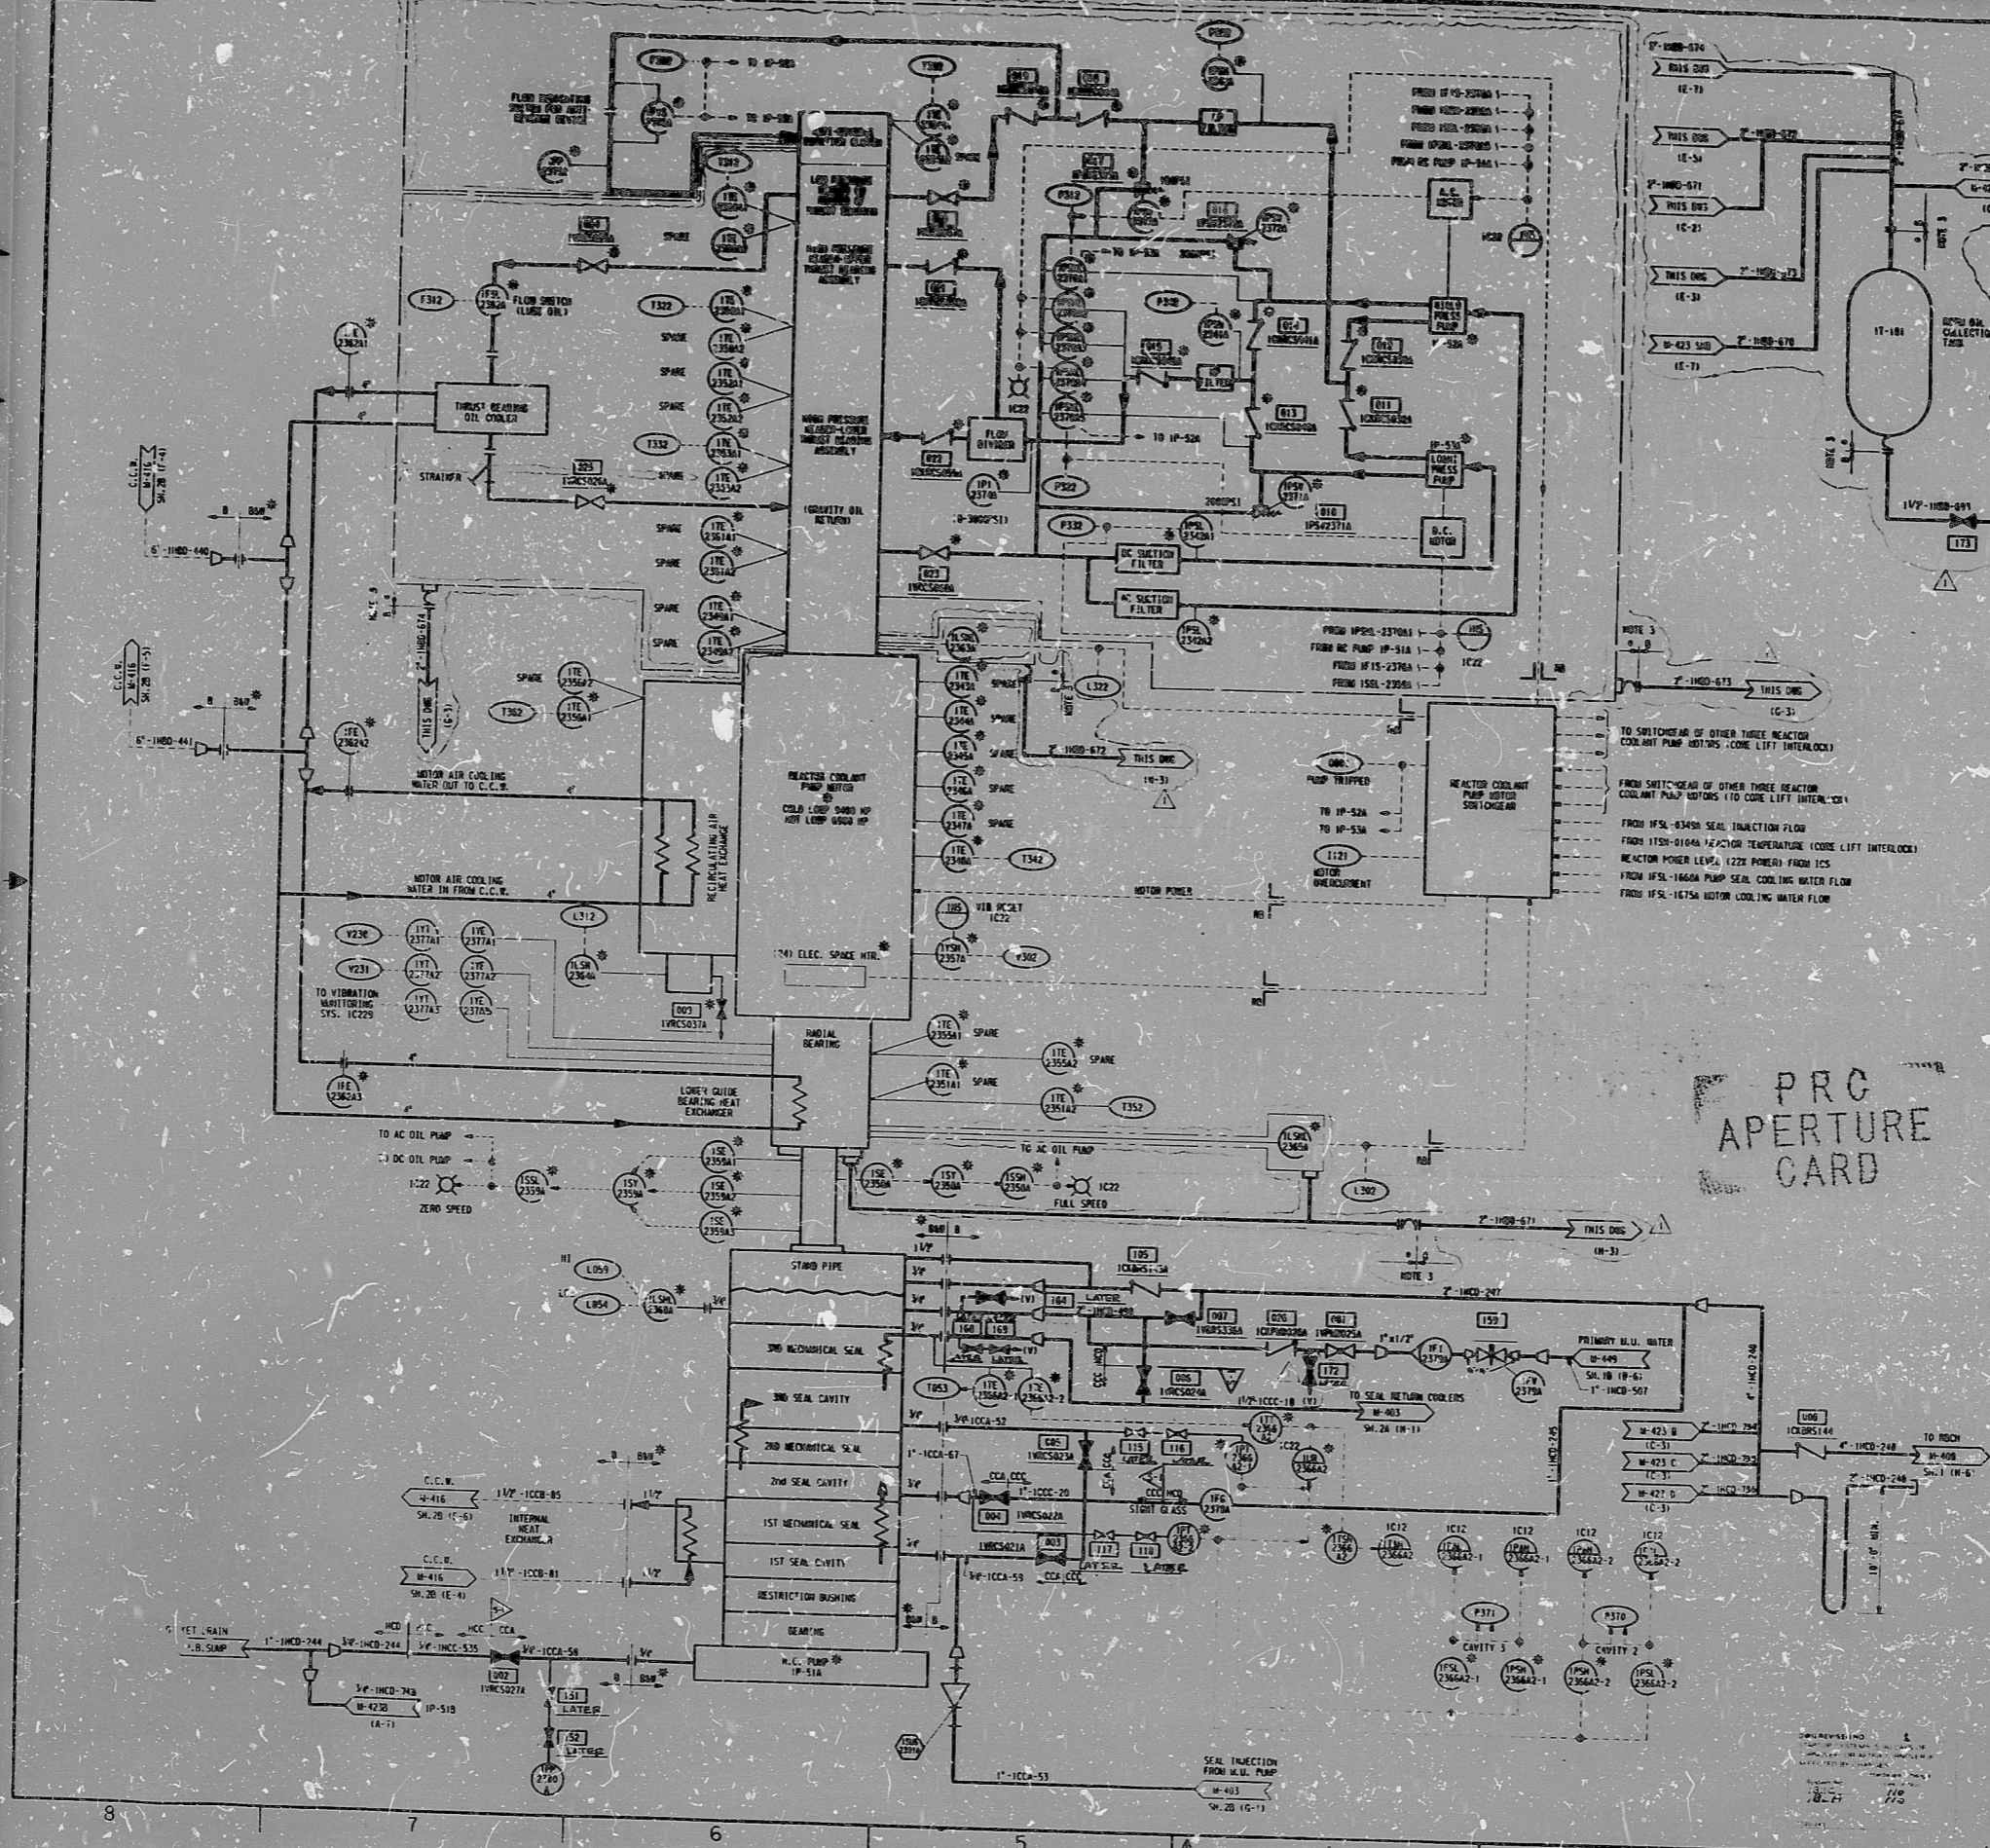

- NOTES**
1. SEE PUMP AND MOTOR CROSS REFERENCE NUMBER  
 SYMBOL: PUMP SERIAL NO. MOTOR SERIAL NO.  
 M-423A 402-2142 091-20-0206 634570
  2. THE FOLLOWING LINES ARE CROSSED OUT IN THE REACTOR COOLANT PUMP MOTOR OIL COLLECTION SYSTEM  
 1" ICCA-51  
 1" ICCA-52  
  3. POSITION 1225 IS A REPRESENT THE ENCLOSURES FOR THE REACTOR COOLANT PUMP MOTOR OIL COLLECTION SYSTEM
  4. A - INDICATES FLEXIBLE CONNECTIONS SUPPLIED BY THE COOPERATION TECHNOLOGIES & FLEX CONNECTIONS
  5. LINES 2" - 1000-571 THROUGH 574 SHOULD BE CLOSED NORMALLY TO AVOID DRAINING OF OIL.
  6. REMOVE MATERIAL FROM OILS 100 AND 100B

PRC APERTURE CARD

30X


NO. 7220  
 DATE 11/20/77  
 DRAWING NO. M-423 SH.A(0) 1

**BECHTEL**  
 SAN RAMON, CALIFORNIA

MIDLAND PLANT UNITS 1 & 2  
 CONSUMERS POWER COMPANY

PIPING AND INSTRUMENT DIAGRAM  
 MISCELLANEOUS REACTOR COOLANT PUMP  
 CONNECTIONS - PUMP IP-51A UNIT 1

JOB NO. 7220  
 DRAWING NO. M-423 SH.A(0) 1

RIDS

8302090610

