



M-433A

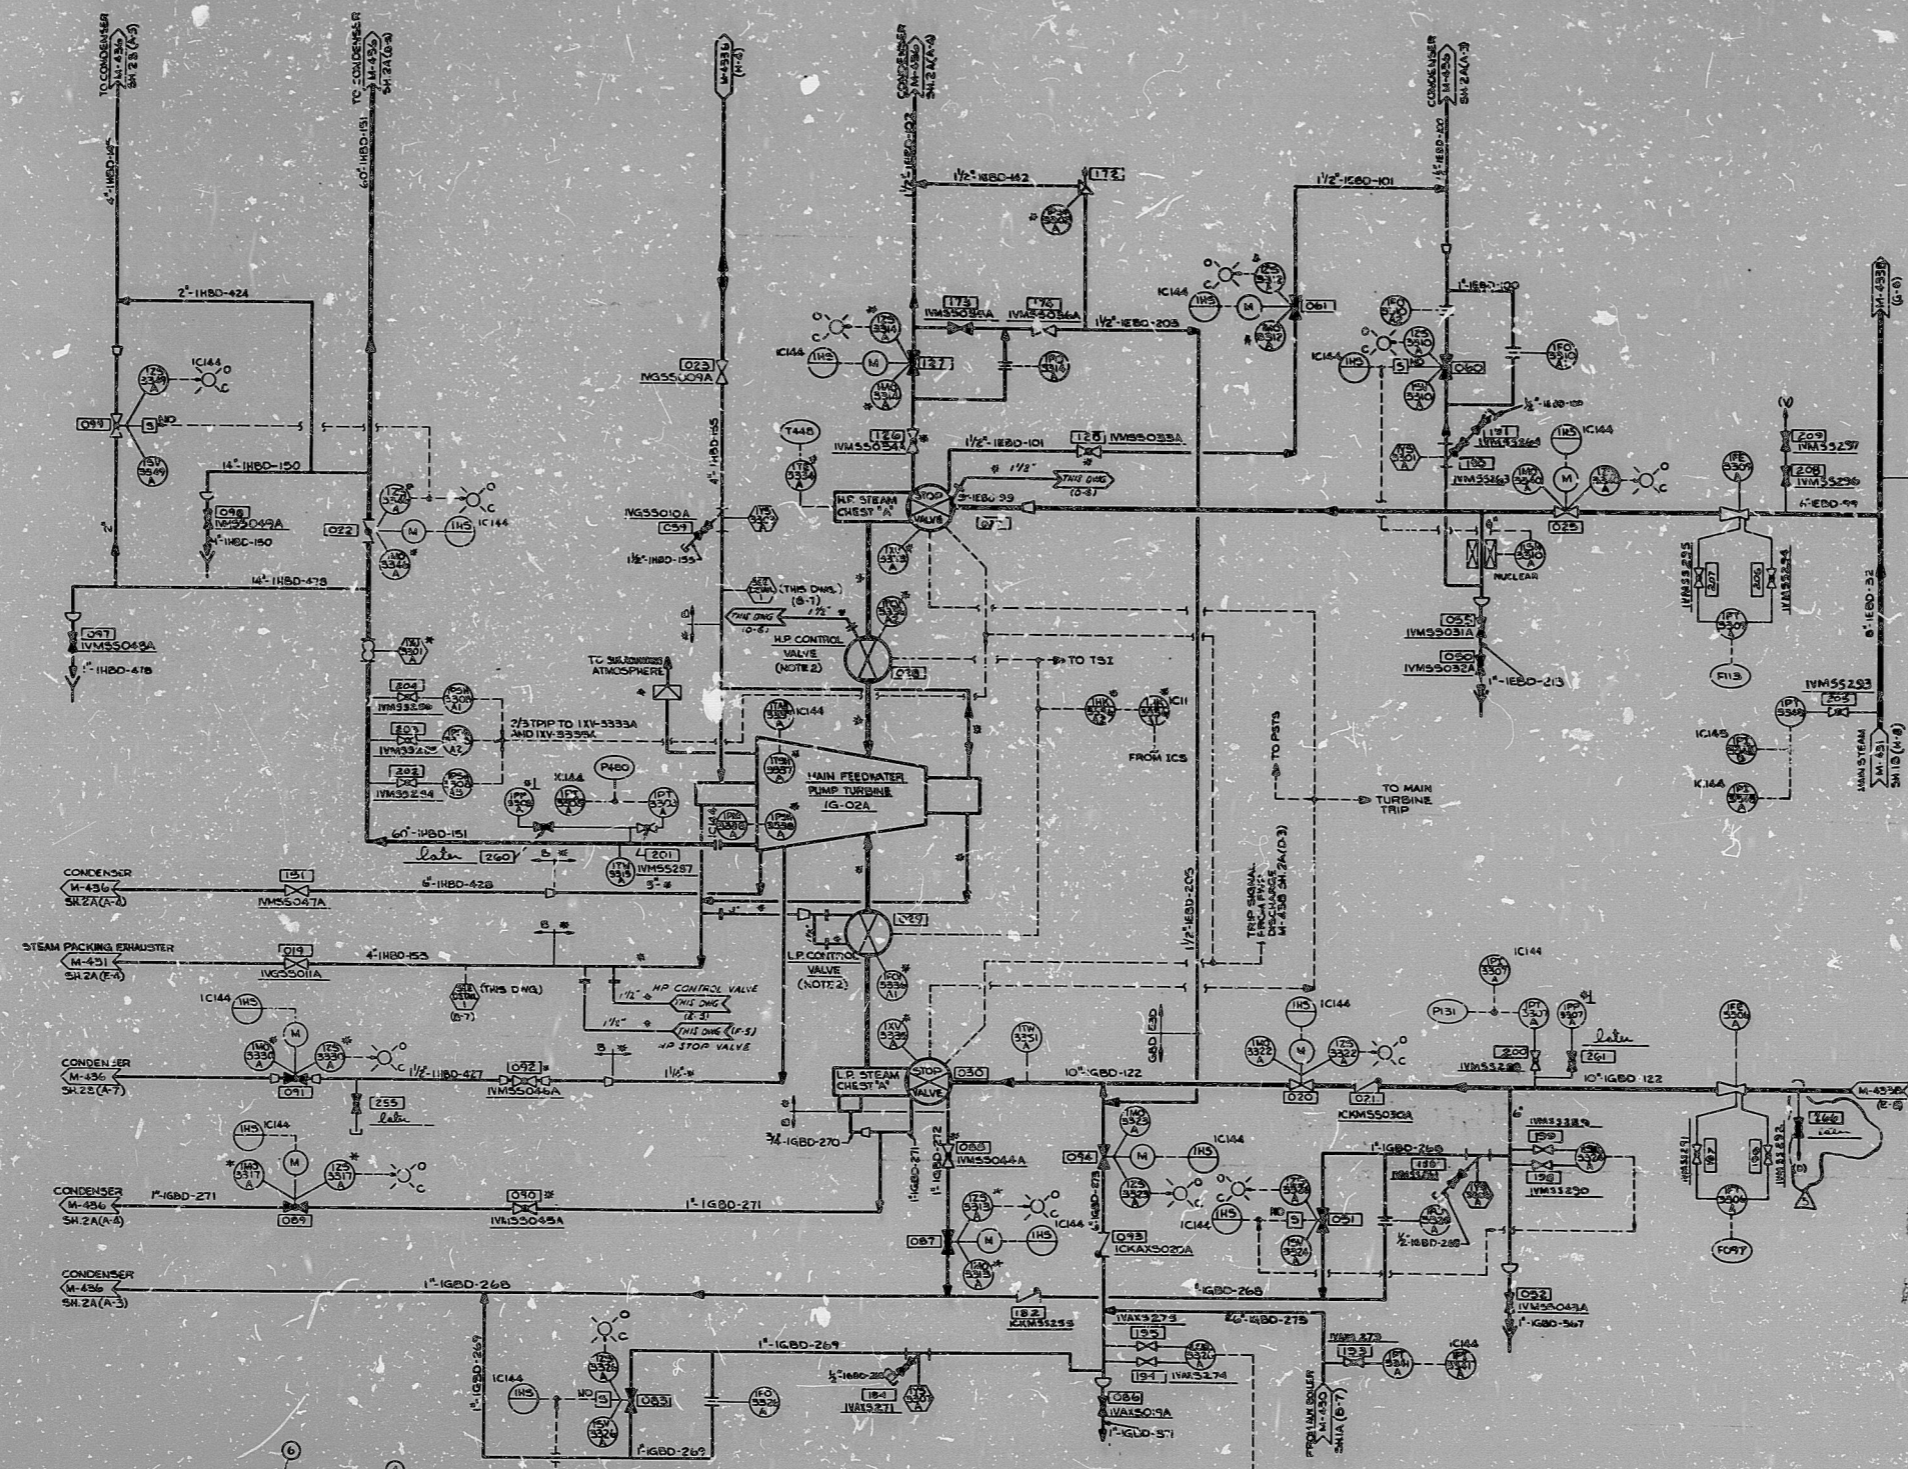

NOTES:

- STEAM TRAPS ARE FURNISHED WITH INTEGRAL BLOWDOWN VALVES.
- THE HP AND LP CONTROL VALVES ARE CONTROLLED BY A COMMON MECHANICAL LINKAGE.
- SWITCHES 1, 2, 1000.

PRO APERTURE CARD

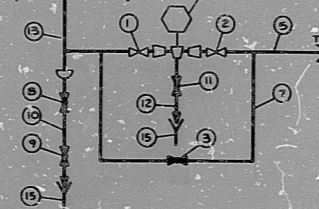



BECHTEL
MIDLAND PLANT UNITS 1 & 2
CONSUMERS POWER COMPANY

PIPING & INSTRUMENT DIAGRAM
AUXILIARY STEAM UNIT-1

JOB NO. 7220
DRAWING NO. M-433A
REV. 5

RIDS

8302100037

