



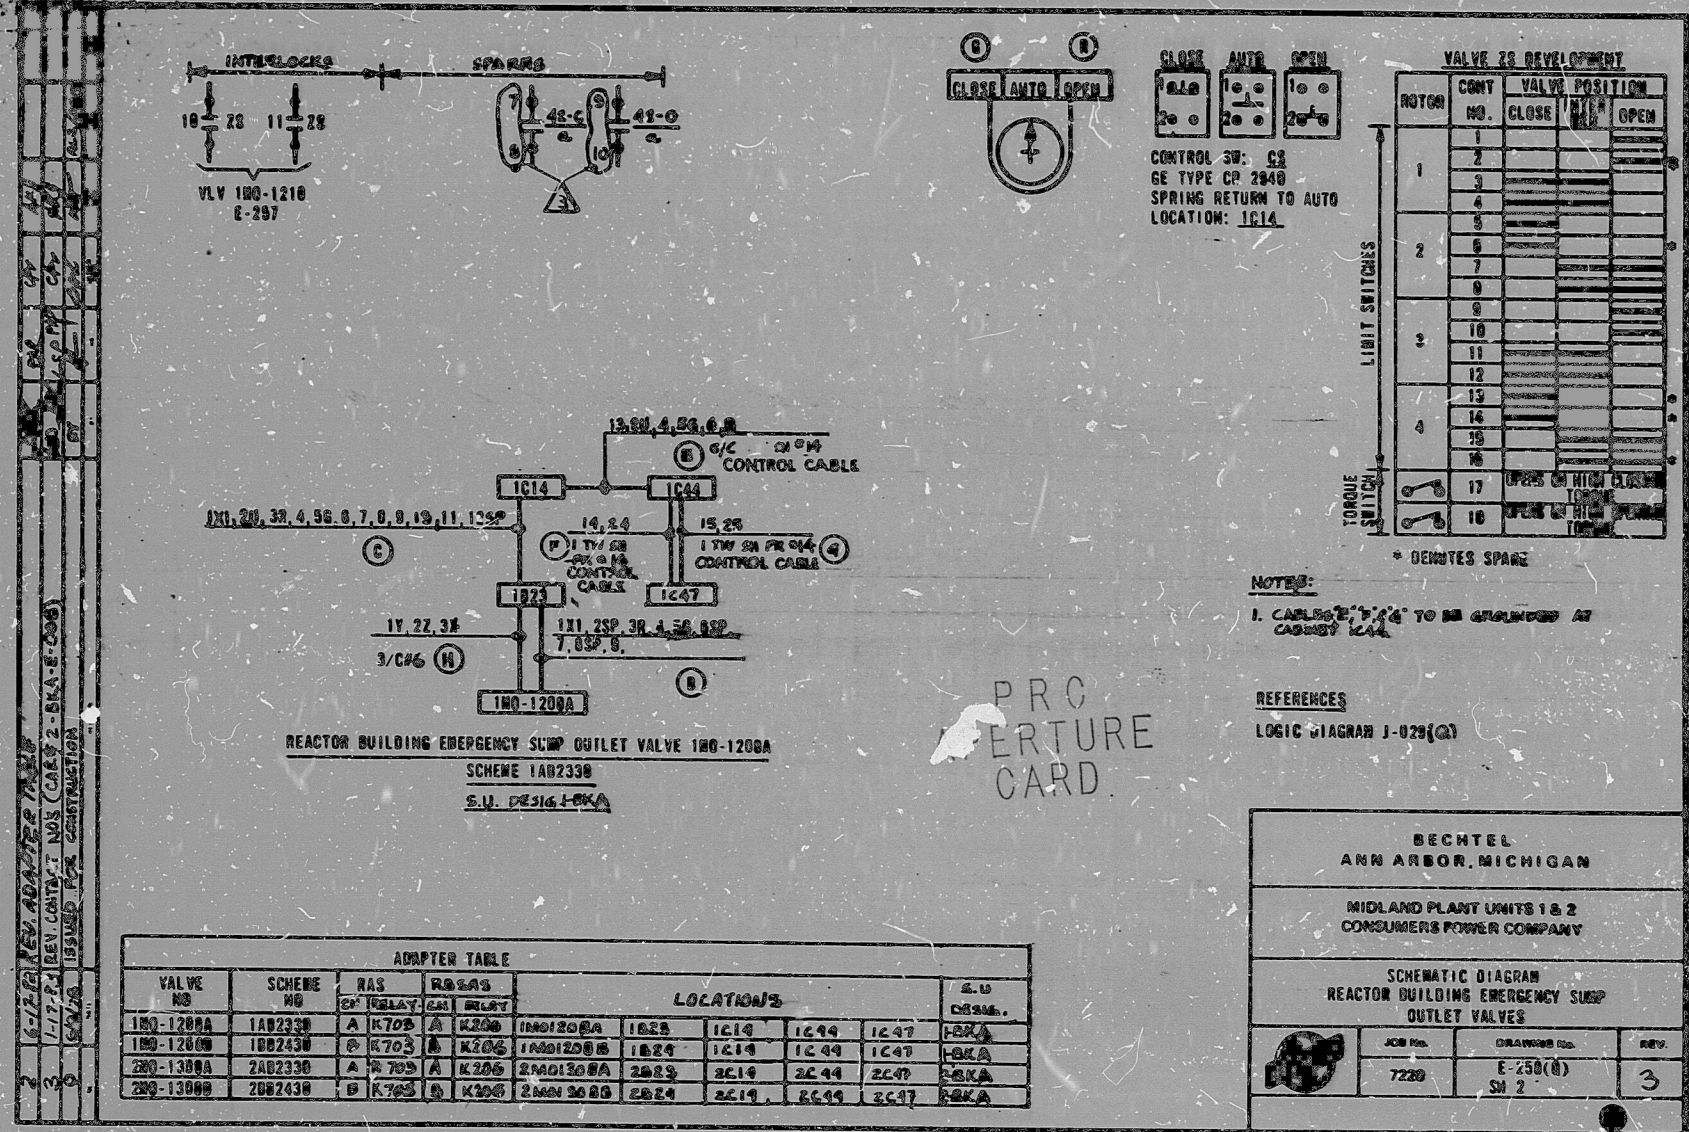



8401190032

PDR RIDS

