
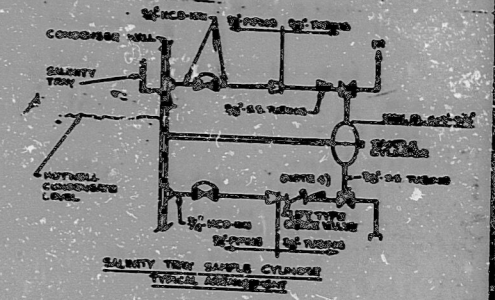


17"
11"
8.5"
8.5"
11"
17"

This drawing and the piping it covers are the property of BECHTEL. They are issued based on the necessary information furnished by the customer and subject to any future revision from the design of the process.

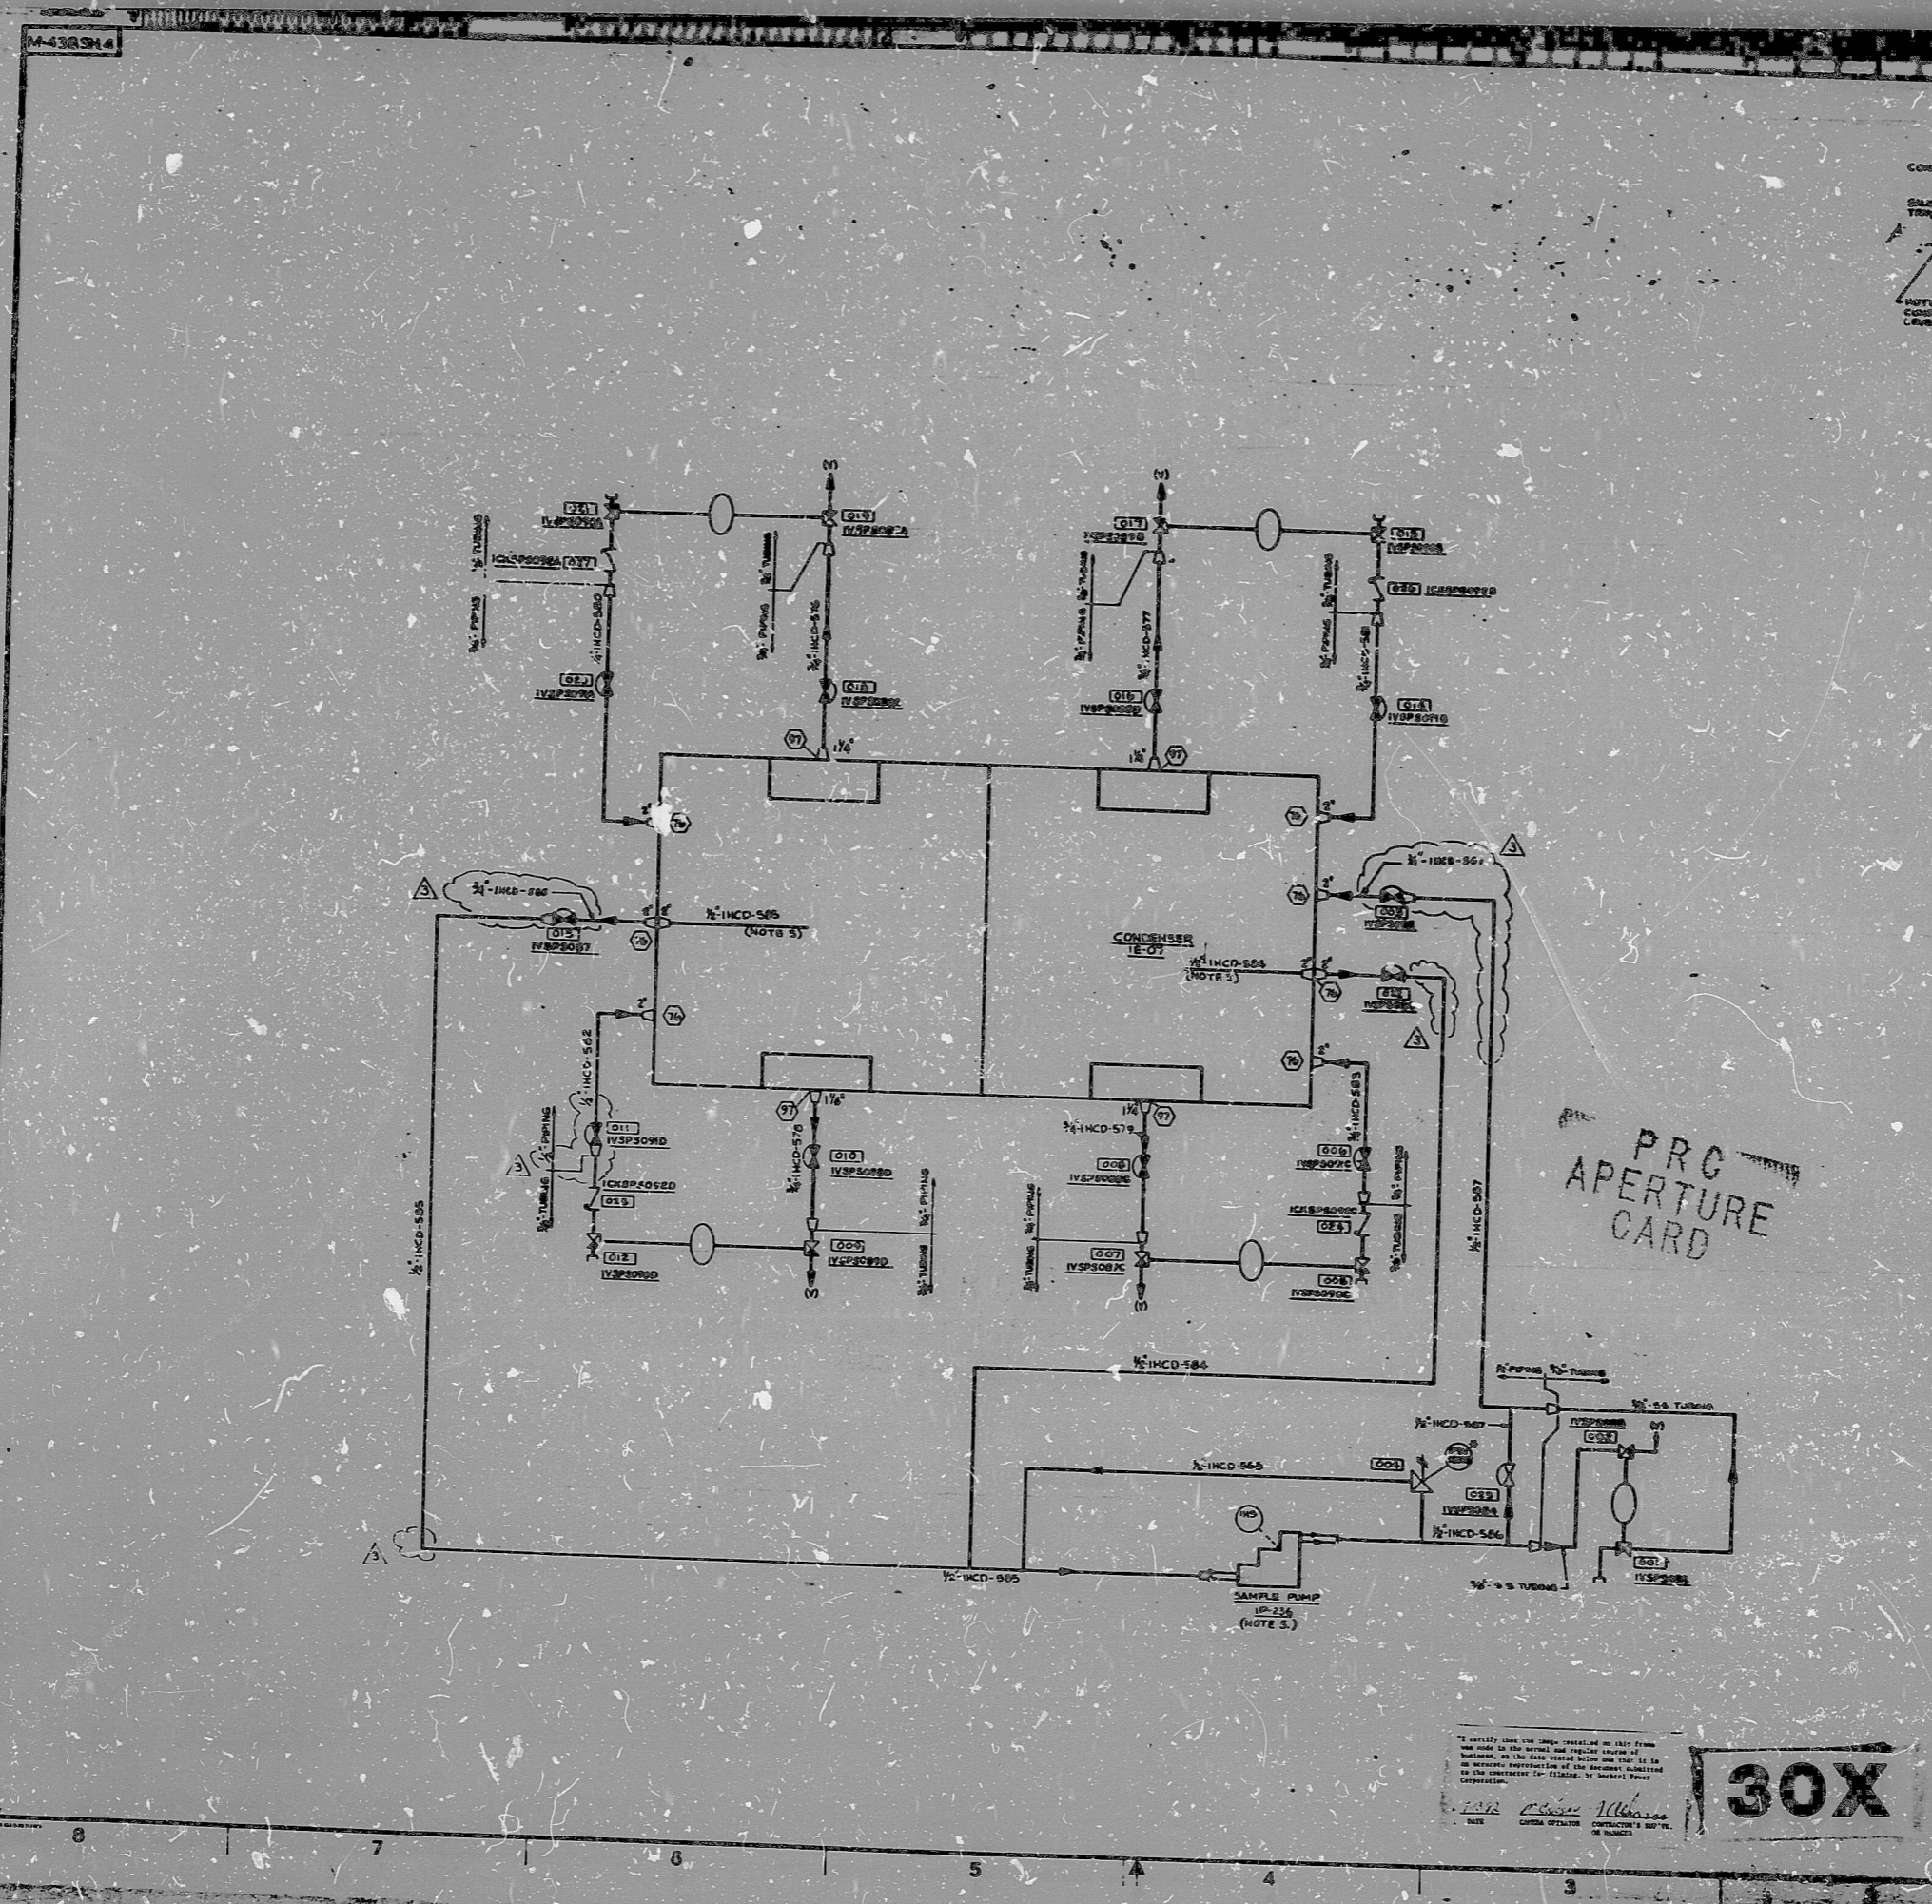

- NOTES:
- 1. ALL 3/4" VALVES AND CHECK VALVES ARE OF 1/2"
 - 2. ALL SAMPLE CYLINDERS ARE 500 ML. SS.
 - 4. THIS LINE TO BLOCK CONTINUOUSLY FOR SAFETY TESTS.
 - 5. SAMPLE PUMP IS A DETAIL PAGE.

BECHTEL

PIPING AND INSTRUMENT DIAGRAM			
FEEDWATER AND CONDENSATE UNIT 1			
POTWELL SAMPLING			
NO. 1	NO. 2	NO. 3	NO. 4
1	2	3	4

30X

RIDS

177

258

8302100066

