


M-437SH2B (3)

8205 E

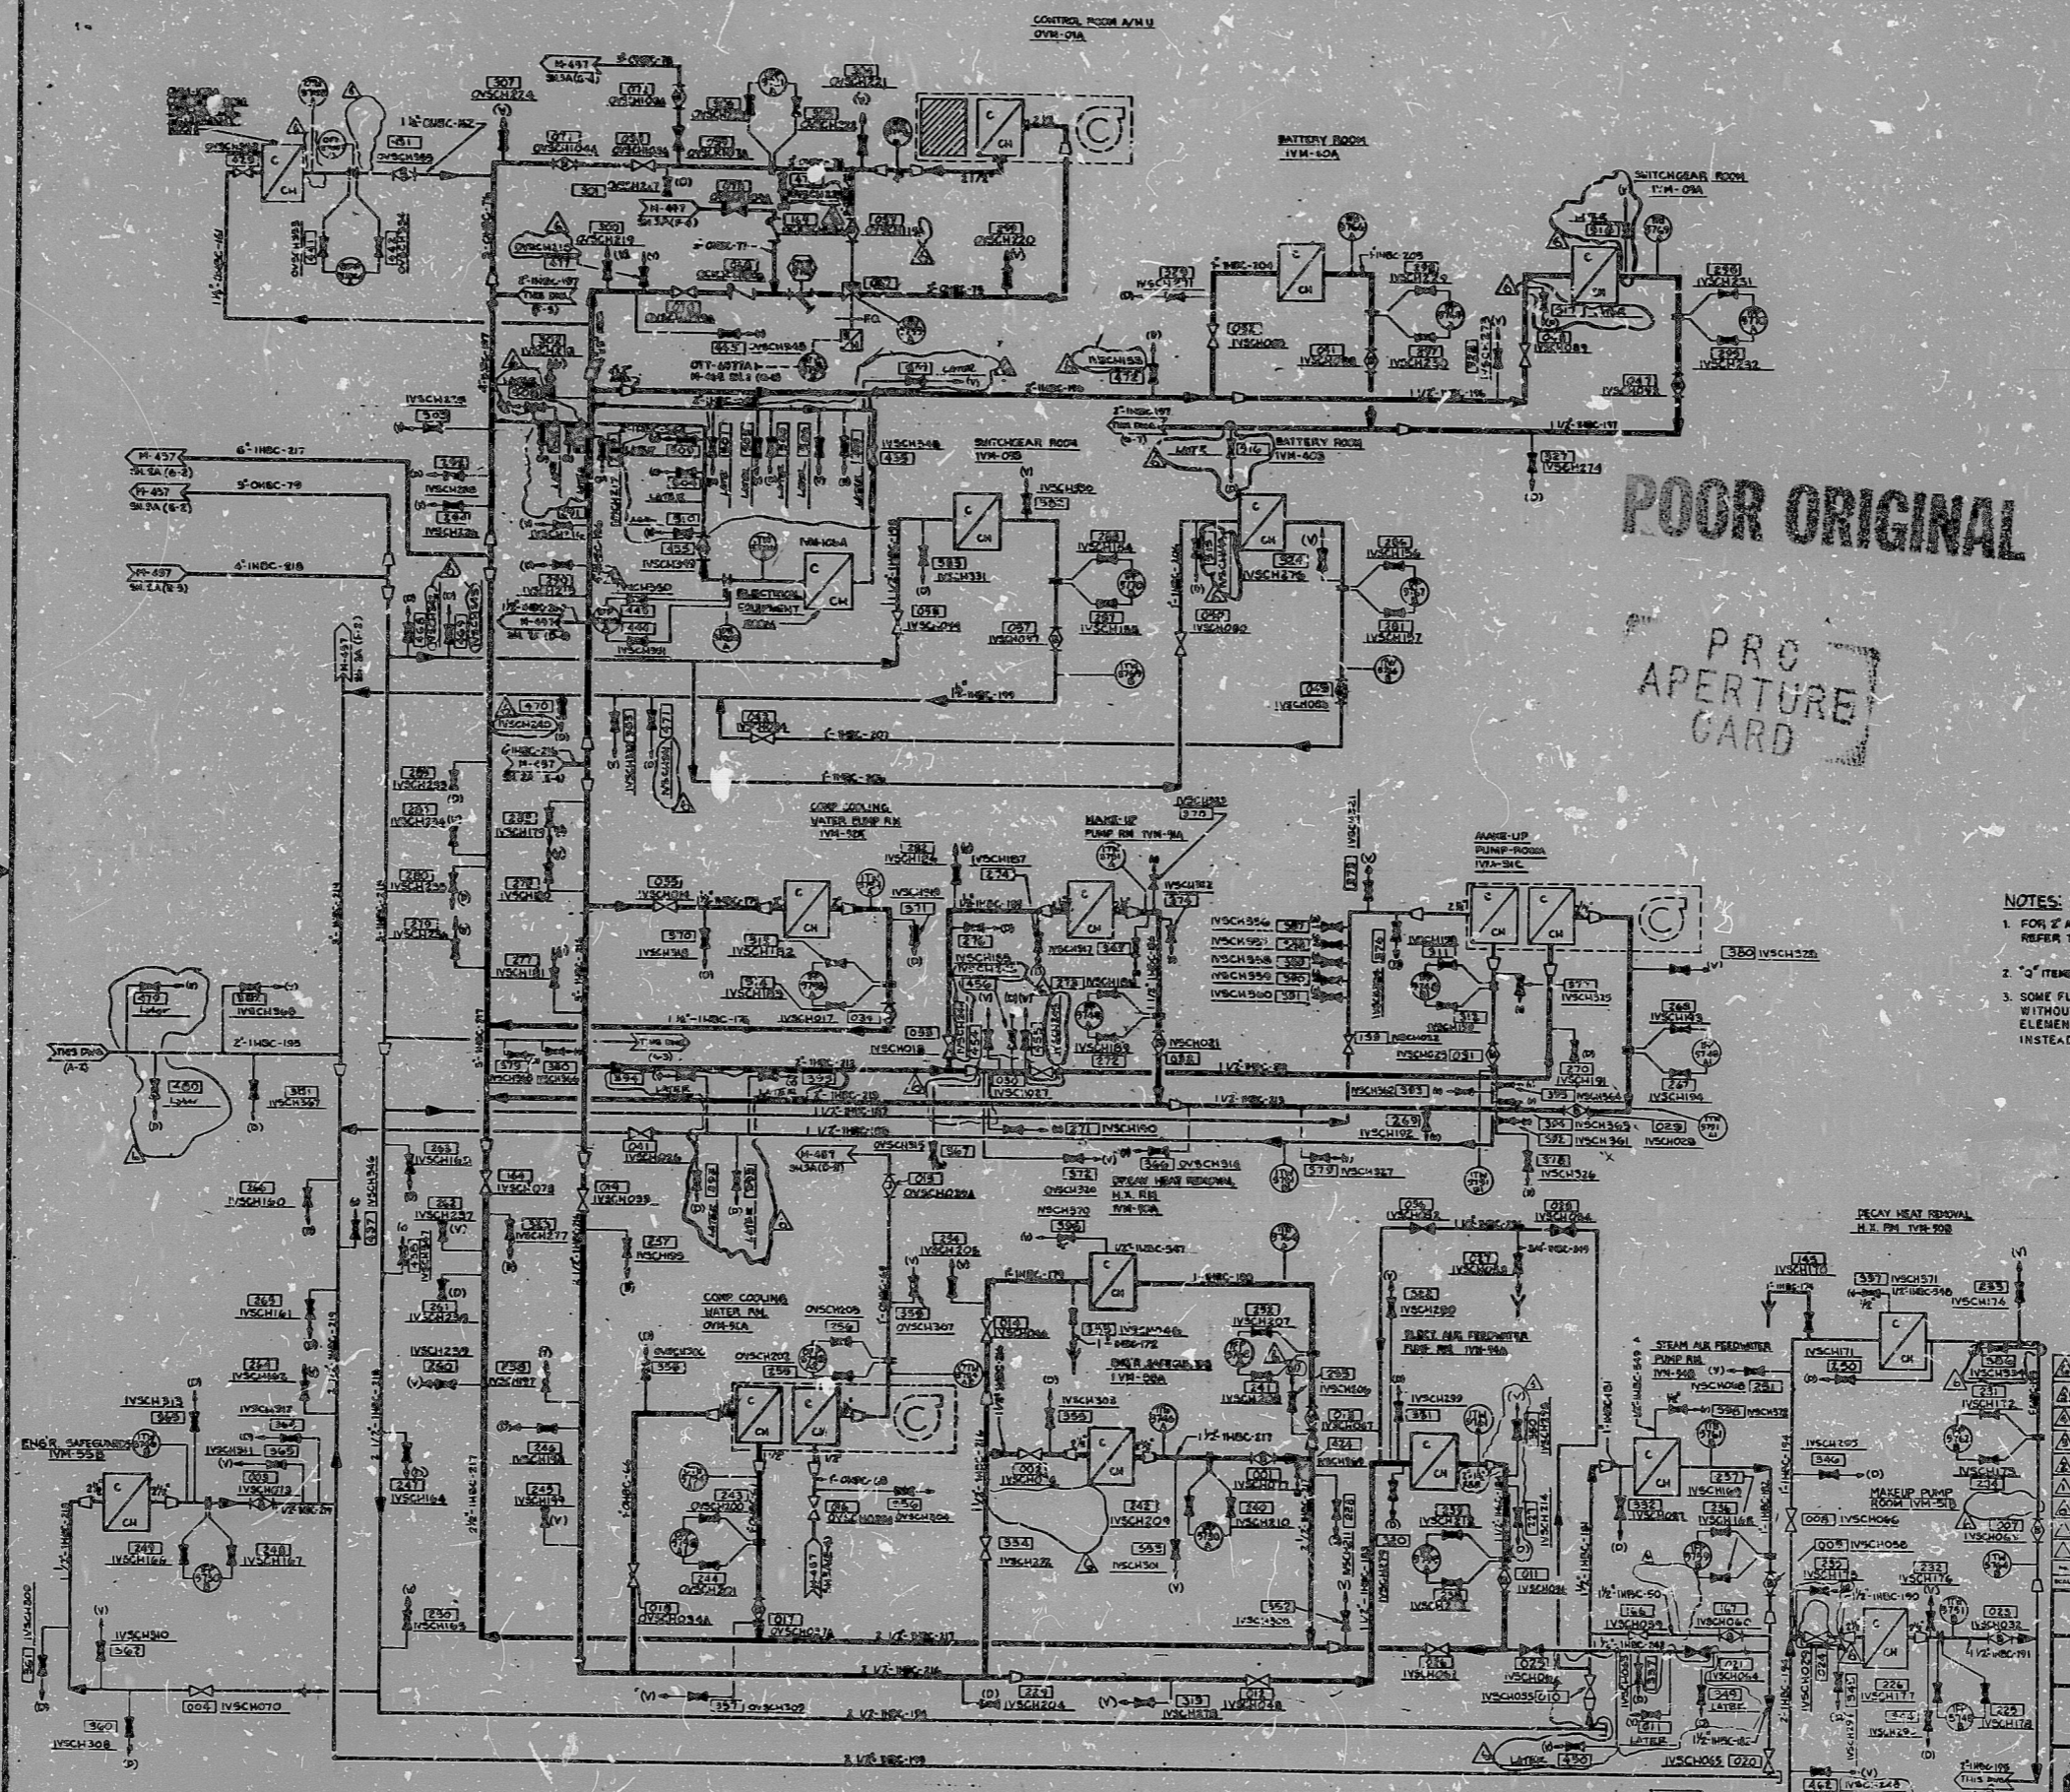

POOR ORIGINAL

PRO APERTURE CARD

30X



NOTES:

- FOR 2" AND SMALLER PIPING, THRESHOLD CONNECTIONS REFER TO INSTRUMENTS INSTALLATION INSTRUCTIONS J-602
- "Q" ITEMS ARE CONTAINED ONLY ON SHEETS 2 AND 3.
- SOME FLOW POINTS, ON THIS DRAWING, ARE SHOWN WITHOUT THE PRIMARY ELEMENT (FE) BECAUSE THE ELEMENT WAS PURCHASED AND TAGGED AS FE INSTEAD OF FE.


REV.	BY	DATE	DESCRIPTION
1
2
3
4
5
6
7
8
9
10

BECHTEL
 AN AMERICAN CORPORATION

MIDLAND PLANT UNITS 1 & 2
 CONSUMERS POWER COMPANY

PIPING AND INSTRUMENT DIAGRAM
 CHILLED WATER-SAFEGUARDS
 EQUIPMENT-UNIT-1

7220 M-437SH2B (3)

17"

11"

8.5"

8.5"

11"

17"

17"

11"

8.5"

8.5"

11"

17"

RIDS

8302100523

