


This drawing and the design it covers are the property of BECHTEL. They are hereby loaned and not the borrower's property. The borrower agrees to return them to the lender in the same condition as received, and to indemnify the lender from any and all claims, damages, losses, and expenses, including reasonable attorney's fees, which may be incurred by the lender in connection with the loan of these drawings and the design it covers.

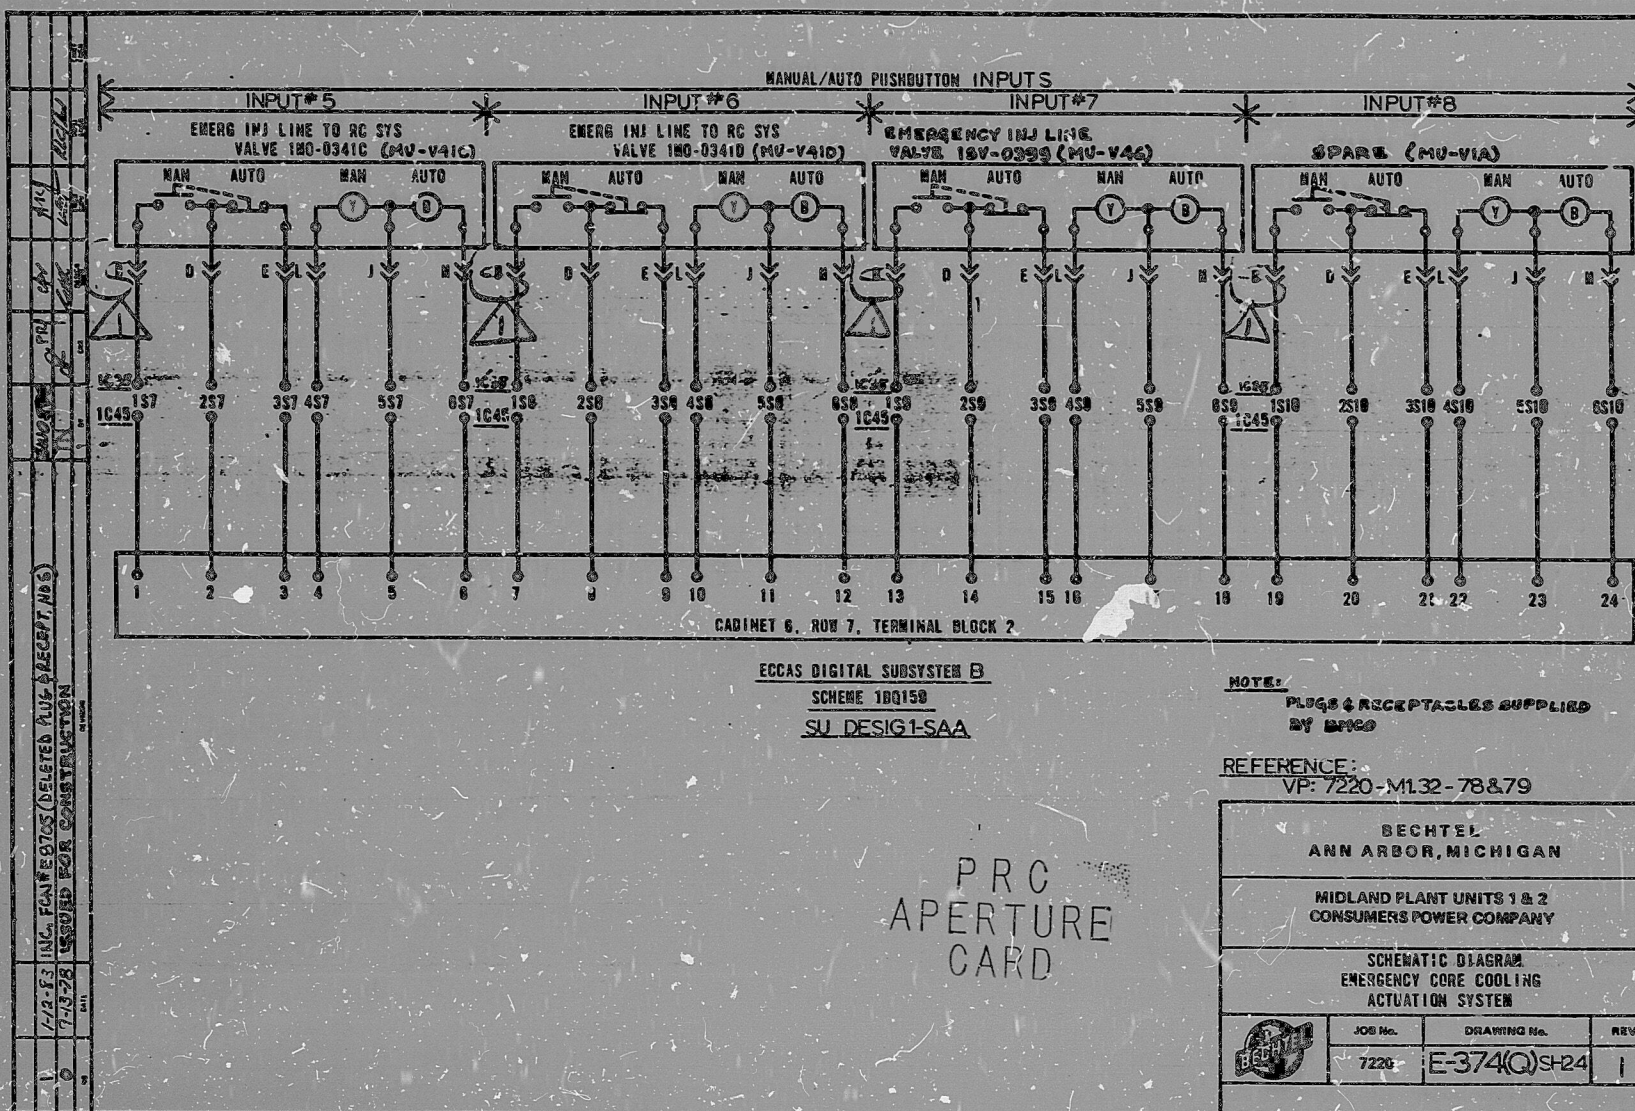

I certify that the image contained on this frame was made in the normal and regular course of business, on the date stated below and that it is an accurate reproduction of the document submitted to reprographics.

16X

8401190447

PDR RIDS

