

HP MAGNETIC FILTER OF-80	LP MAGNETIC FILTER OF-81A	LP MAGNETIC FILTER OF-81B	LP MAGNETIC FILTER OF-81C	LP MAGNETIC FILTER OF-81D

- NOTES:
1. STAGGS FOR MAGNETIC COIL.
 2. MAGNETIC COIL COOLING SYSTEM: INSTRUMENT TANKS SHOULD BE IN SYSTEM IS TYPICAL FOR ALL G MAGNETIC FILTER COILS & COOLING JETS AND IS TYPICAL. SEE VENDOR DATA FOR COOLING UNIT DETAILS.
 3. EACH MAGNETIC COIL HAS FOUR STAGGS BENCHMOUNTED TO THE COIL. BENCHMOUNTING IS USED WHILE THE OTHER THREE STAGGS ARE SPARES.
 4. STATUS LIGHTS FOR FILTER SH-READ VALVES OC-9281A & OC-9281B ARE ON OC-270.
 5. TYPICAL INSTRUMENTATION AS FOR OC-44A. SEE ADAPTER TABLE FOR INSTRUMENT NUMBERS.
 6. COMMON ALARMS FOR OC-348A & OC-348B ARE LOCATED AT CONTROL PANEL OC-470.
 7. BUTTERFLY VALVE CONTROL DETAIL TYPE FOR VALVES IN THIS SECTION SUPPLIED.


VALVE # LIGHT SOLIDLINE CONTROL


TUBING DESCRIPTION

LINE #	TUBING DESCRIPTION
VE-YDD-21	H.P. FILTER (OF-80) MAGNETIC COIL COOLING INLET TUBING
VE-YDD-22	H.P. FILTER (OF-80) MAGNETIC COIL COOLING OUTLET TUBING
VE-YDD-23	L.P. FILTER (OF-81A) MAGNETIC COIL A COOLING INLET TUBING
VE-YDD-24	L.P. FILTER (OF-81A) MAGNETIC COIL A COOLING OUTLET TUBING
VE-YDD-25	L.P. FILTER (OF-81B) MAGNETIC COIL B COOLING INLET TUBING
VE-YDD-26	L.P. FILTER (OF-81B) MAGNETIC COIL B COOLING OUTLET TUBING
VE-YDD-27	L.P. FILTER (OF-81C) MAGNETIC COIL C COOLING INLET TUBING
VE-YDD-28	L.P. FILTER (OF-81C) MAGNETIC COIL C COOLING OUTLET TUBING
VE-YDD-29	L.P. FILTER (OF-81D) MAGNETIC COIL D COOLING INLET TUBING
VE-YDD-30	L.P. FILTER (OF-81D) MAGNETIC COIL D COOLING OUTLET TUBING

PRO APERTURE CARD

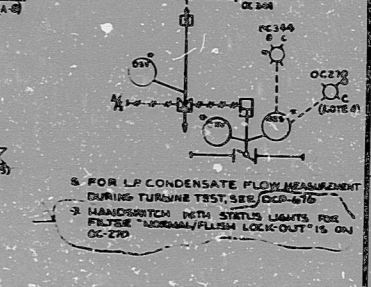

BECHTEL
180 15TH AVENUE

MIDLAND PLANT UNITS 1 & 2
CONDENSERS POWER COMPANY
PIPING AND INSTRUMENT DIAGRAM
TURBINE EXTRACTION
STEAM TO EVAPORATORS

DES. NO.	7220
REVISION NO.	M-460 S44
REV.	7

DATE: 11/10/54

DETAIL 1
FOR IDENTIFICATION OF COMPONENTS
SEE LIST IN ZONE A-24-A-3

CERTIFICATE OF MICROFILMING
I certify that the maps contained on this frame was made in the normal and regular course of business, on the date stated below and that it is an accurate reproduction of the document described in the certificate for filing in the Bechtel Power Corporation.

DATE: 11/10/54


RIDS

8302140138

