


17
11
8.5
11
8.5
17

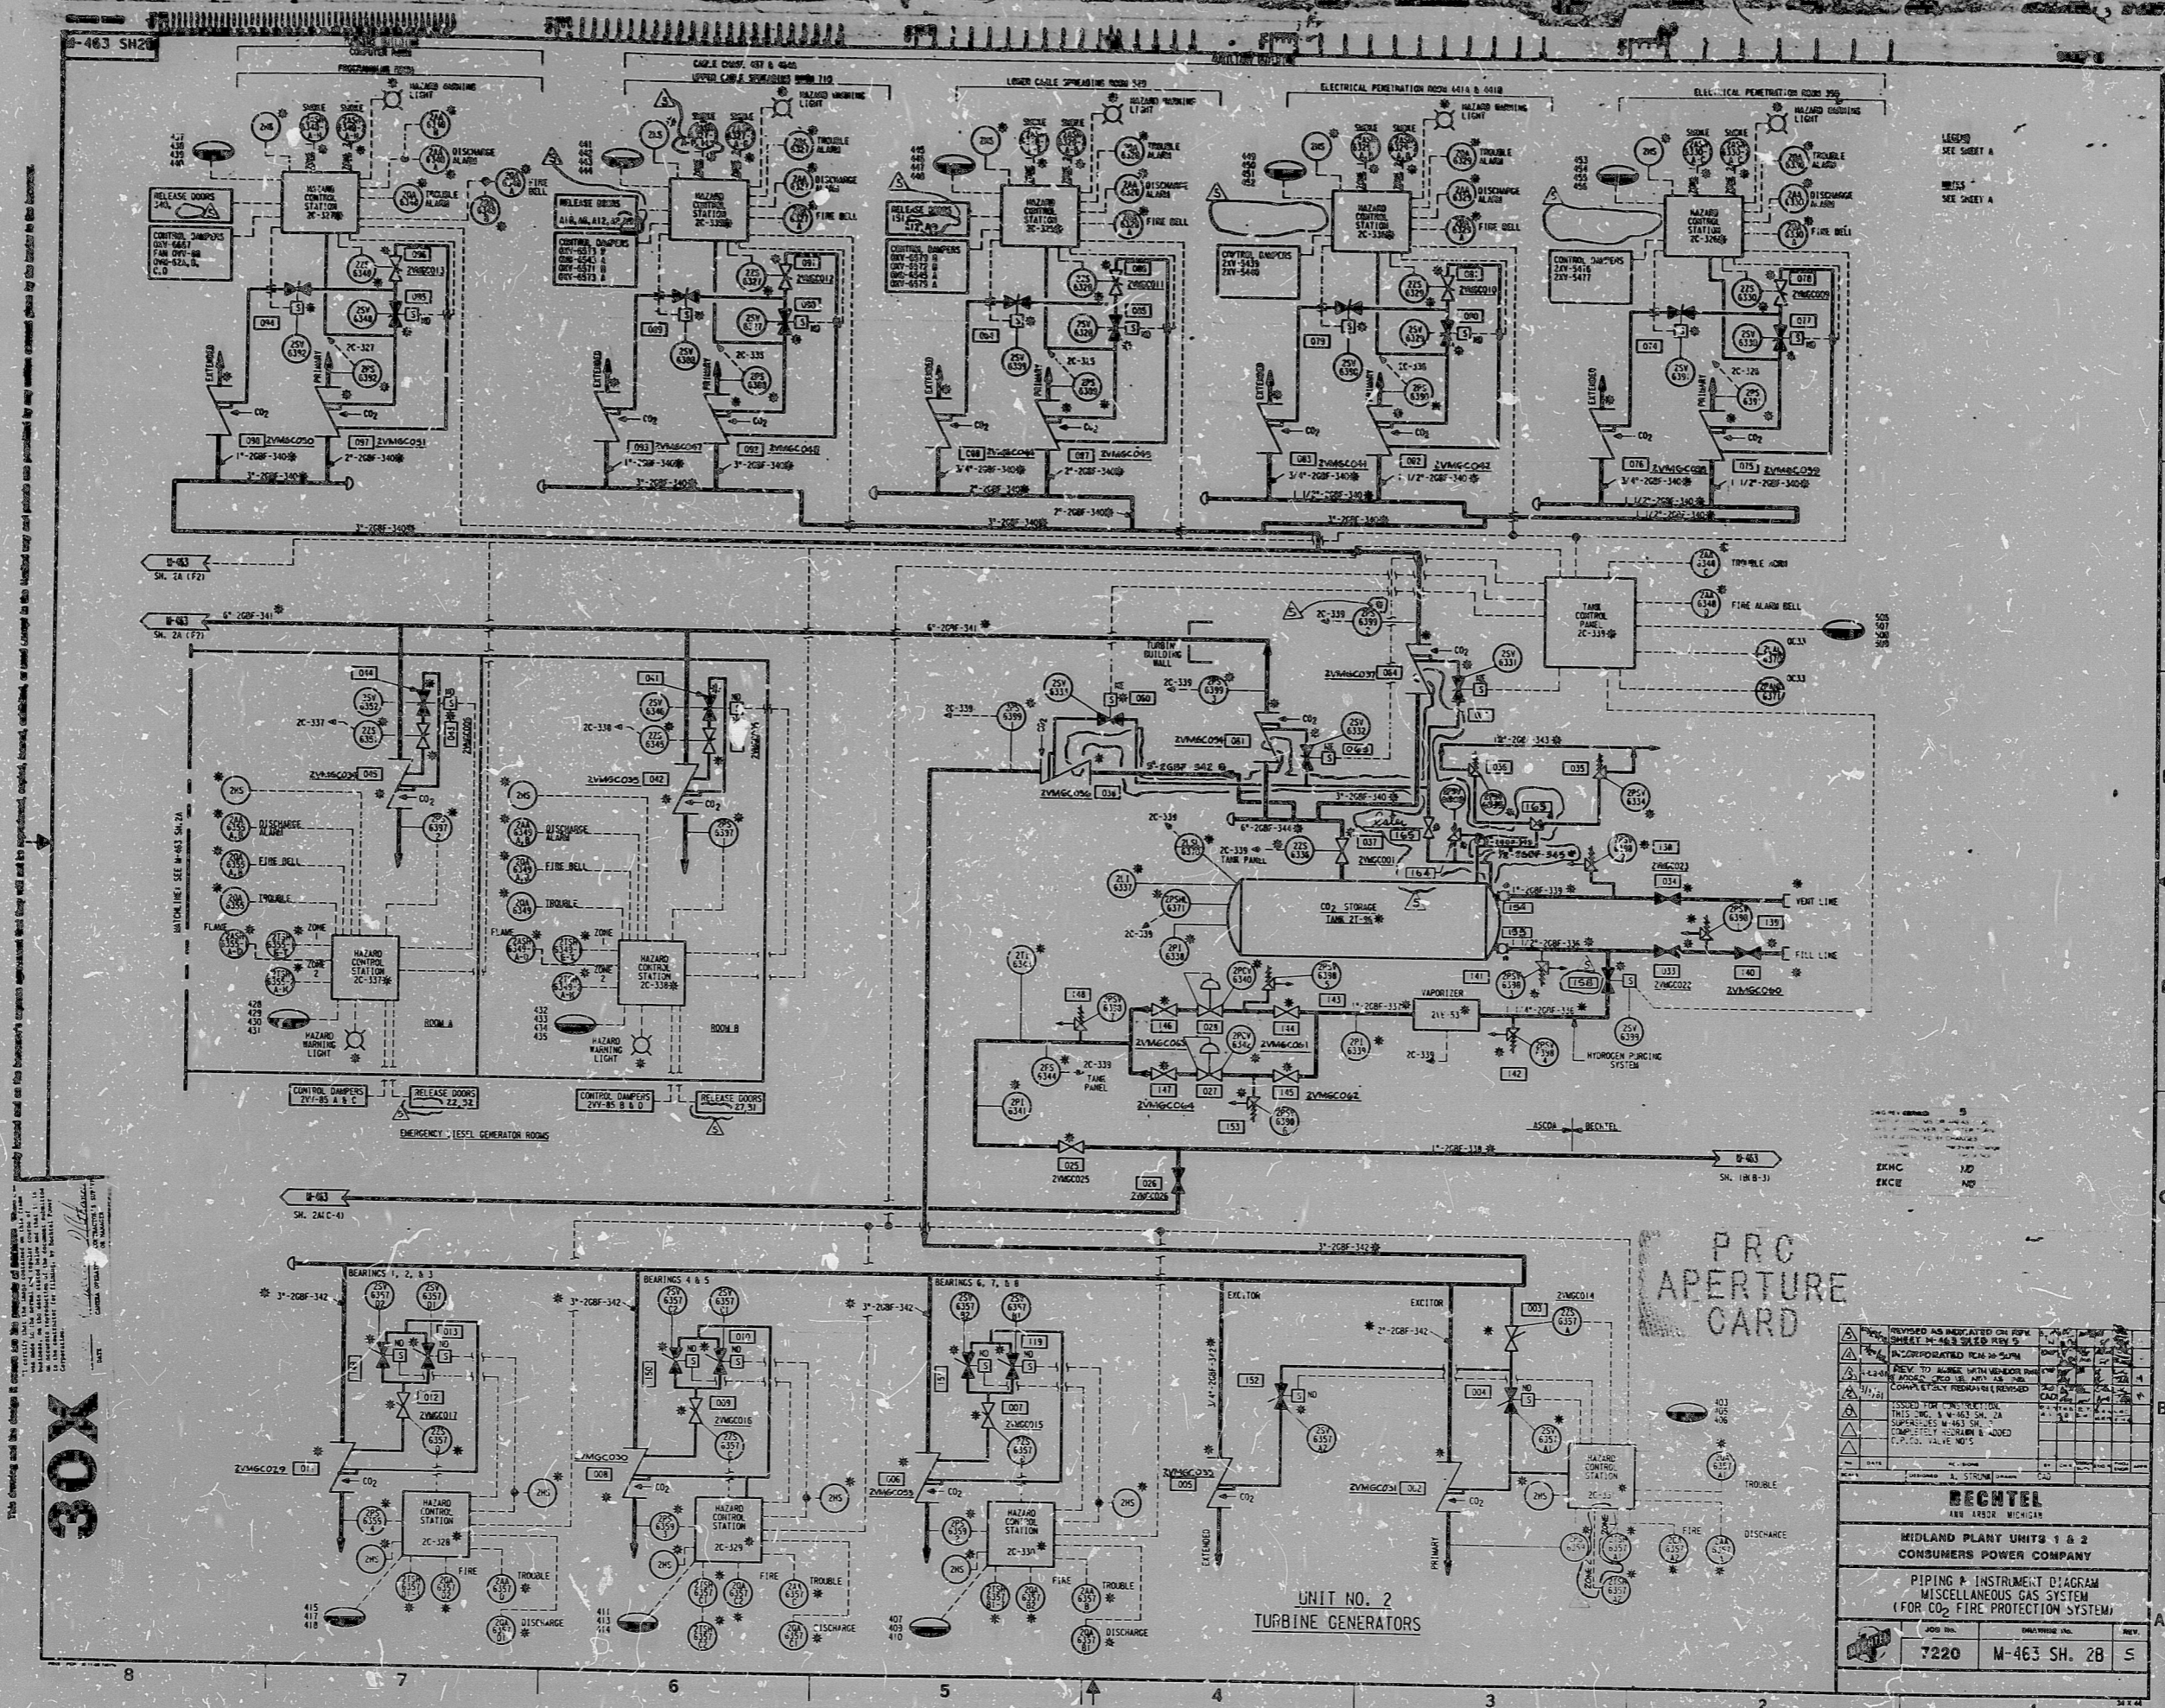

30X

NO.	DESCRIPTION	DATE	BY

BECHTEL

MIDLAND PLANT UNITS 1 & 2
CONSUMERS POWER COMPANY

PIPING & INSTRUMENT DIAGRAM
MISCELLANEOUS GAS SYSTEM
(FOR CO₂ FIRE PROTECTION SYSTEM)

JOB NO.	DRAWING NO.	REV.
7220	M-463 SH. 28	5

H
G
F
E
D
C
B
A

17
11
8.5
11
8.5
17

RIDS

8302140151

