


17"
11"
8.5"
8.5"
11"
17"

This drawing and the design it covers are the property of BECHTEL. They are hereby loaned out on the borrower's express agreement that they will not be reproduced, copied, loaned, exhibited, or made access in any manner by any individual, except as specifically permitted by any written consent given by the lender to the borrower.

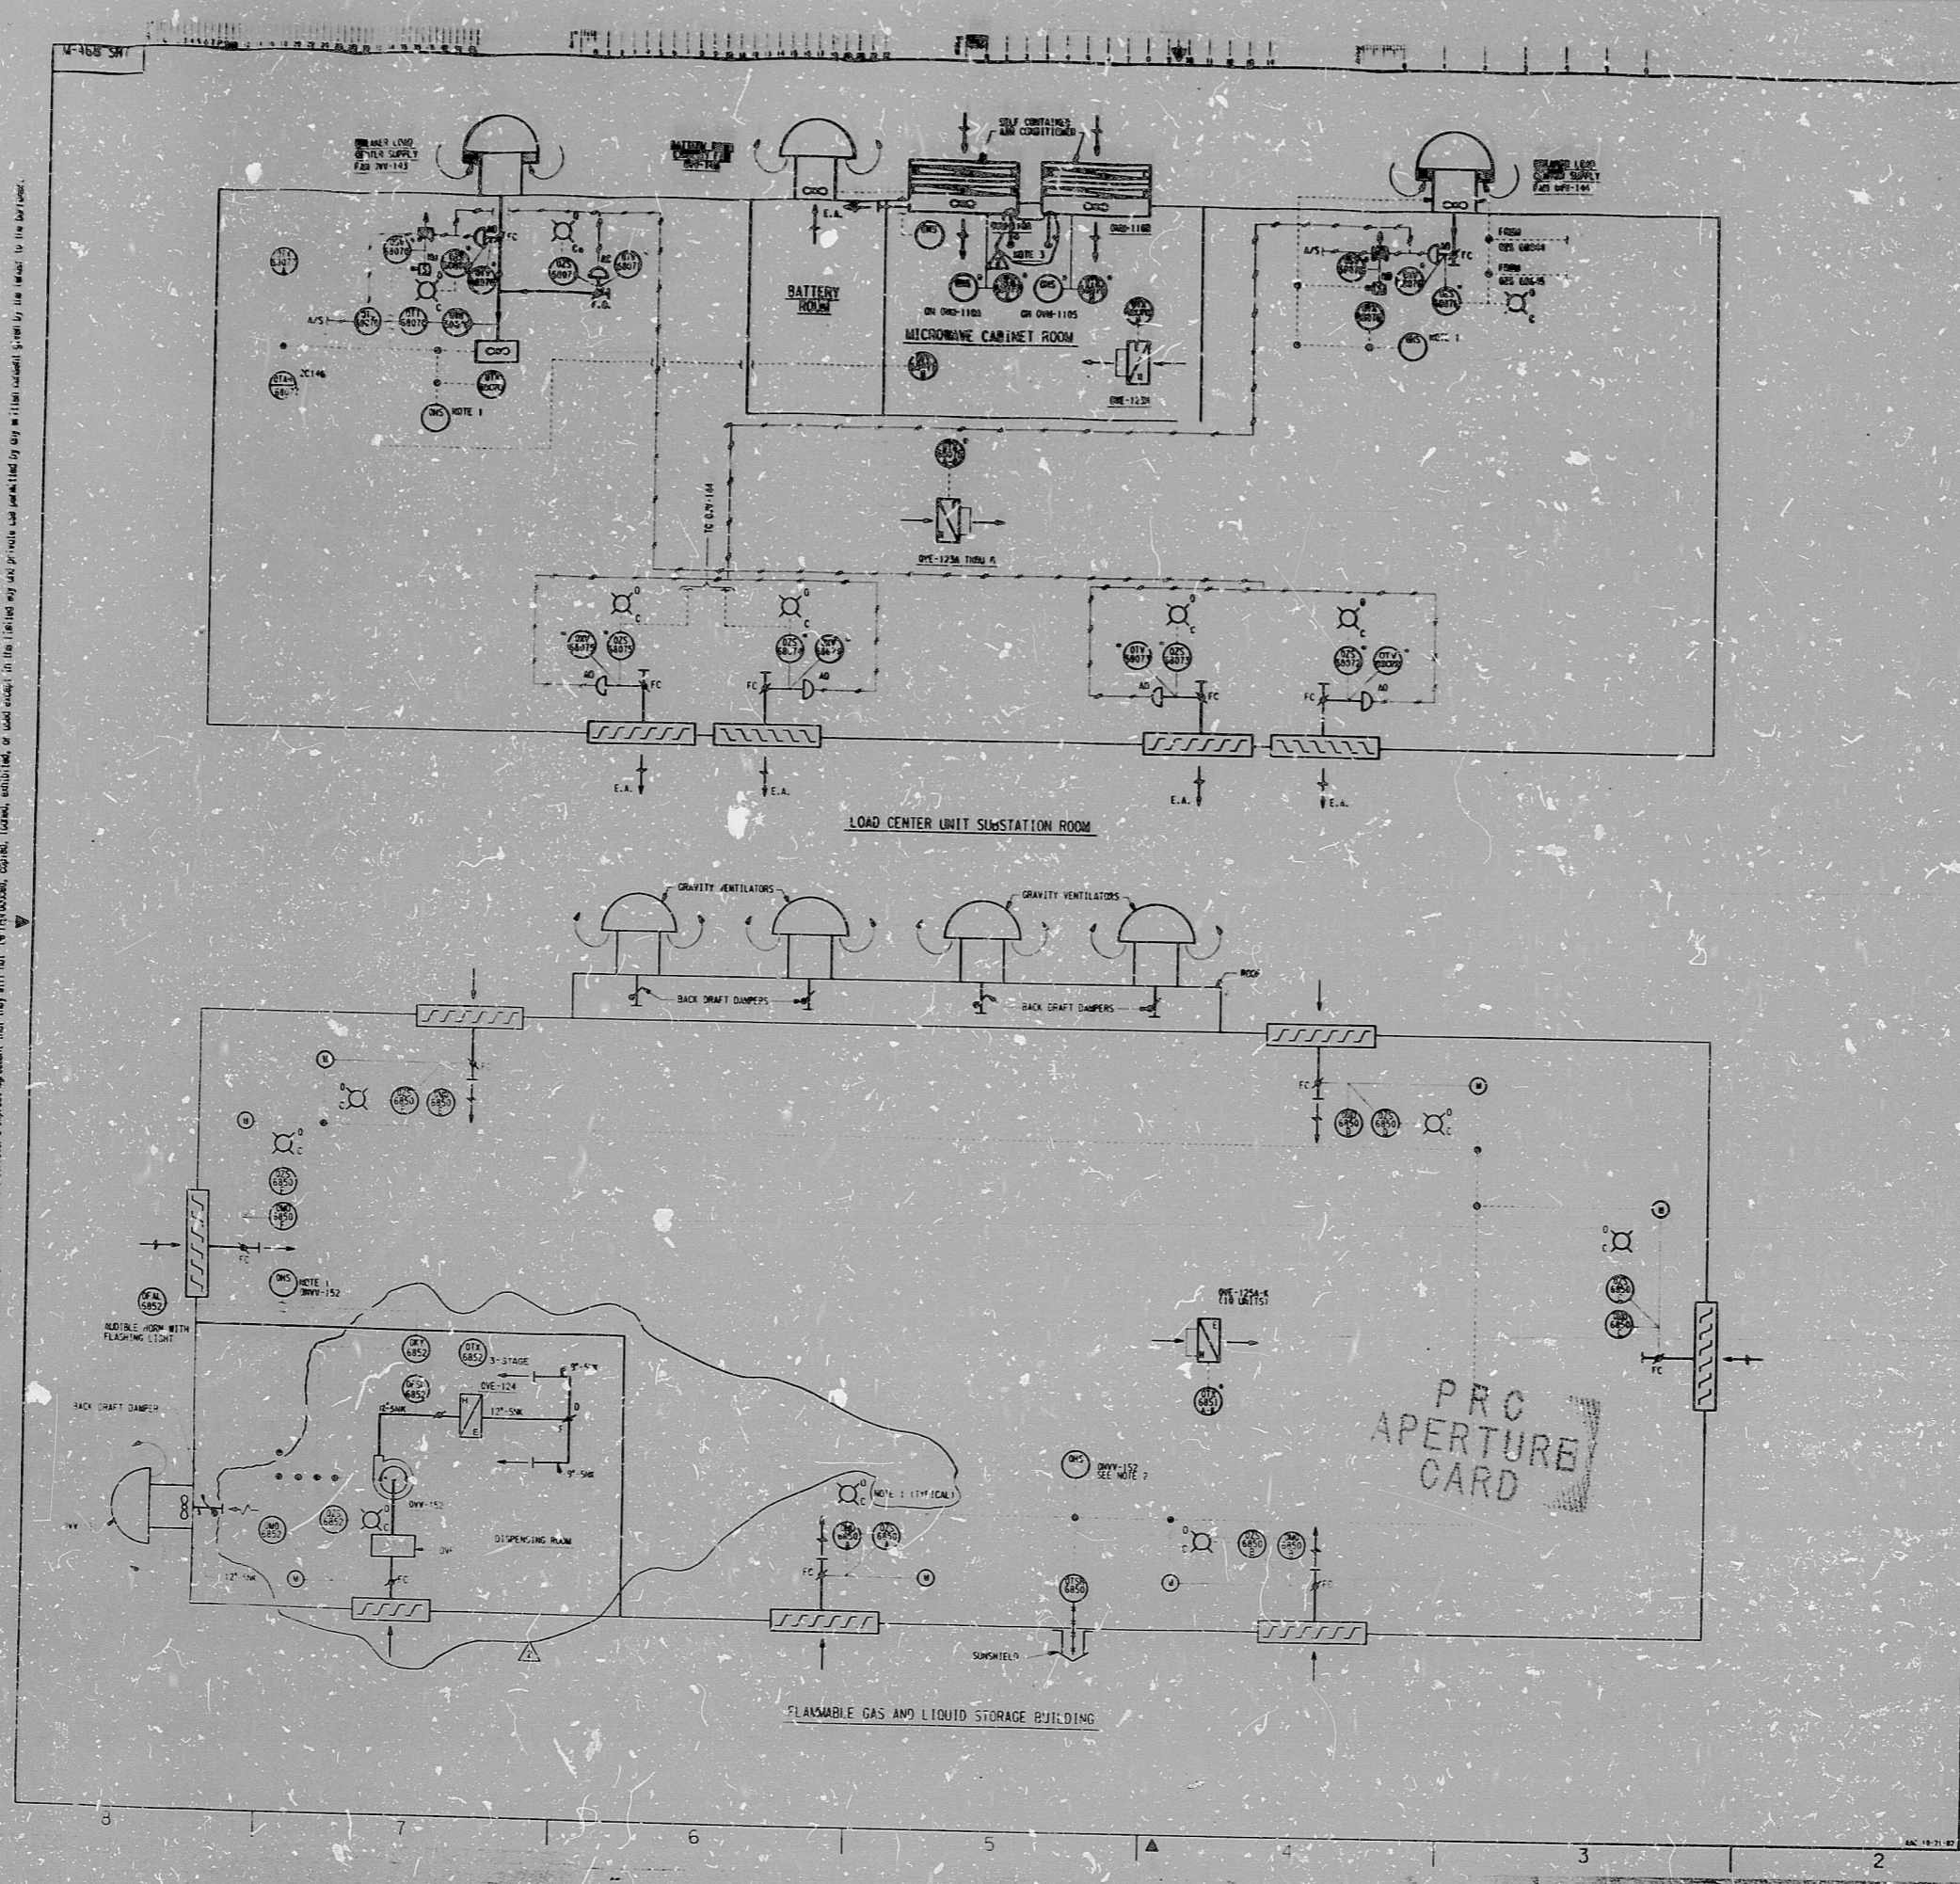

SIZE E

NOTES

1. SWITCH LOCATED ON LOCAL WALL MOUNTED ELECTRICAL BOX, RE-LOCATED EQUIPMENT.
2. AS IS LOCATED AT BLDG. ENTRANCE.
3. DRAIN LINE IS 1/2" DIA. FLEXIBLE HOSE SUPPLIED BY VENDOR.

30X

THIS DRAWING IS THE PROPERTY OF BECHTEL AND IS LOANED TO YOU FOR YOUR INFORMATION ONLY. IT IS NOT TO BE REPRODUCED, COPIED, LOANED, EXHIBITED, OR MADE ACCESS IN ANY MANNER BY ANY INDIVIDUAL, EXCEPT AS SPECIFICALLY PERMITTED BY ANY WRITTEN CONSENT GIVEN BY THE LENDER TO THE BORROWER.


BECHTEL AN AMERICAN CORPORATION	
MIDLAND PLANT UNITS 1 & 2 CONSUMERS POWER COMPANY	
PIPING AND INSTRUMENT DIAGRAM HEATING, VENTILATING & AIR CONDITIONING MISC. STRUCTURE	
JOB NO. 7220	DRAWING NO. M-468 SH. 7
REV. 2	

17"
11"
8.5"
8.5"
11"
17"

RIDS

8302140167

