


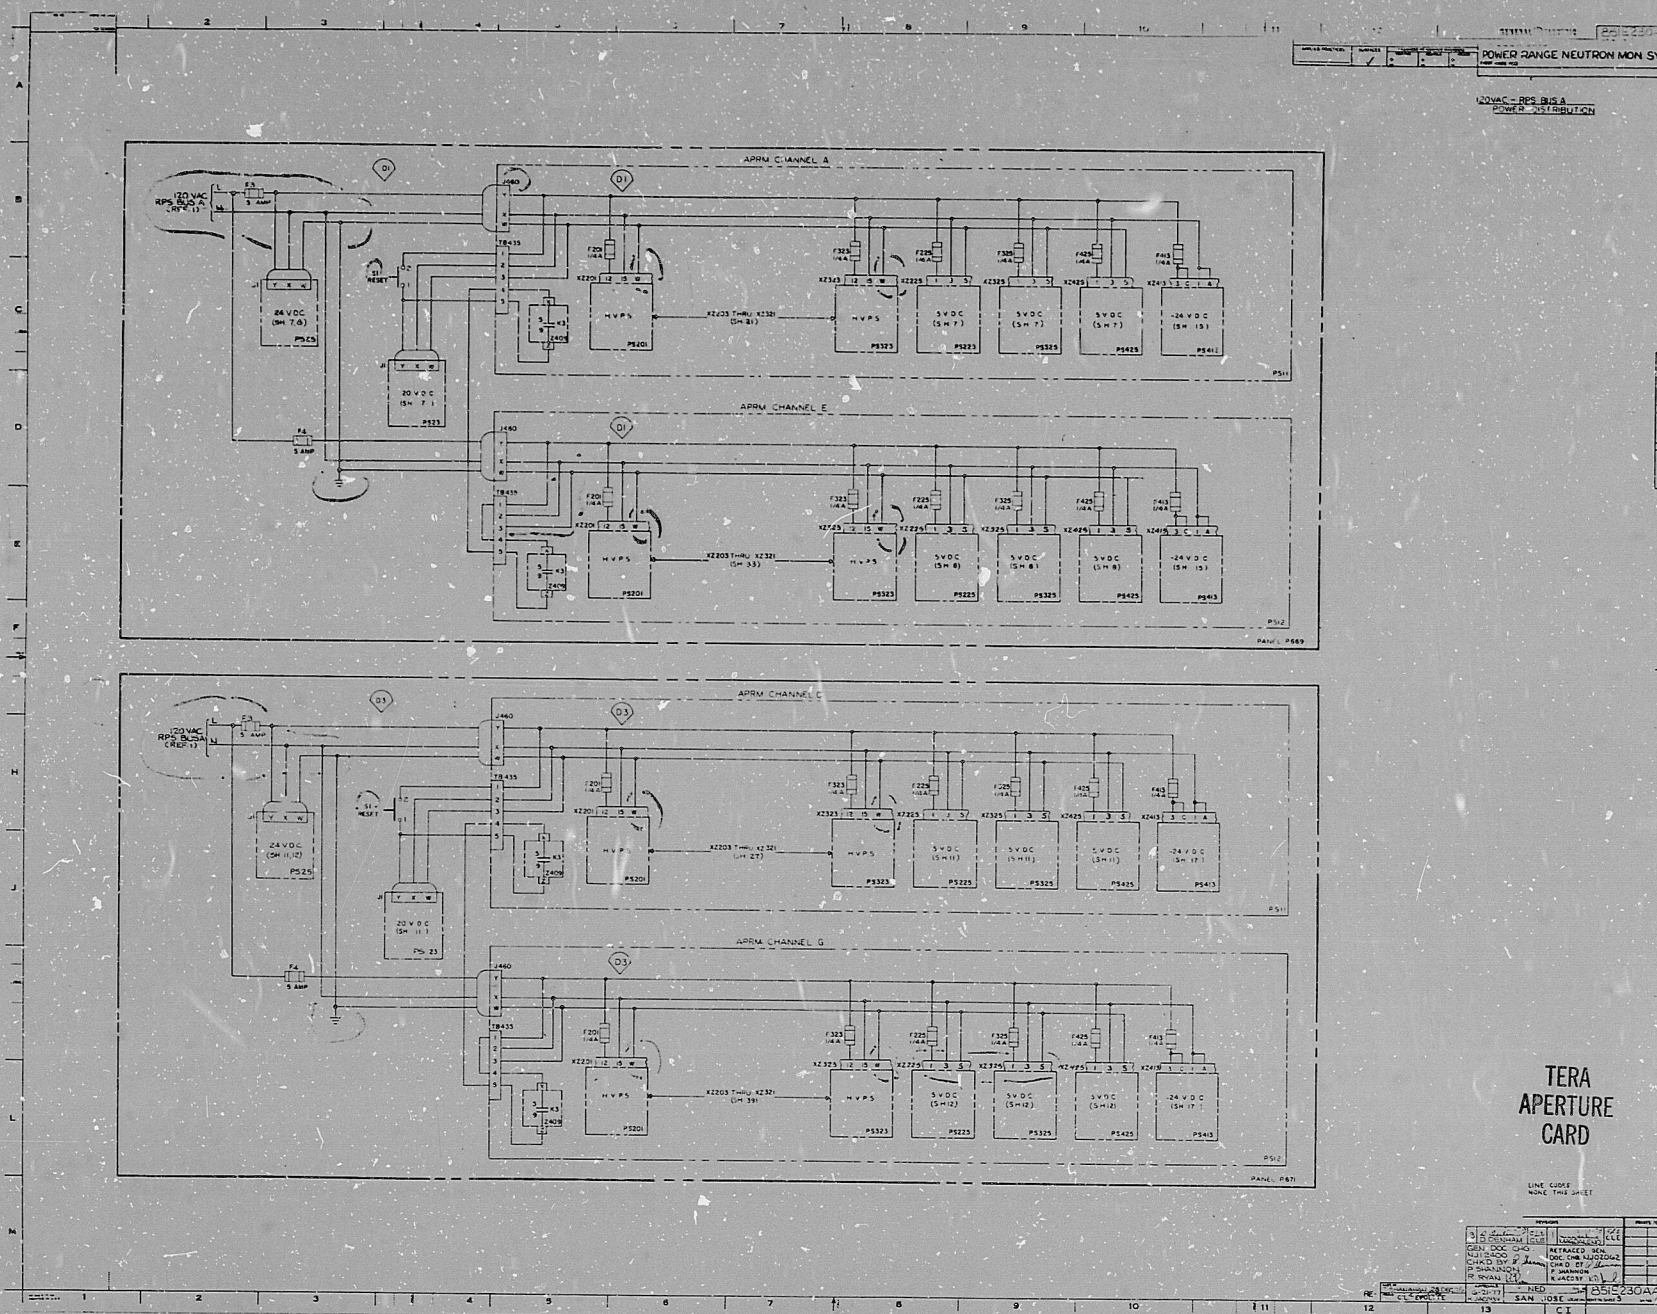

RIDS

8109220306

